


59-58

# NORTH MOUNT FARRELL C<sup>o</sup> N.L.

## SECTIONS OF SHAFT LEVELS

— SCALE .40 FEET TO AN INCH —

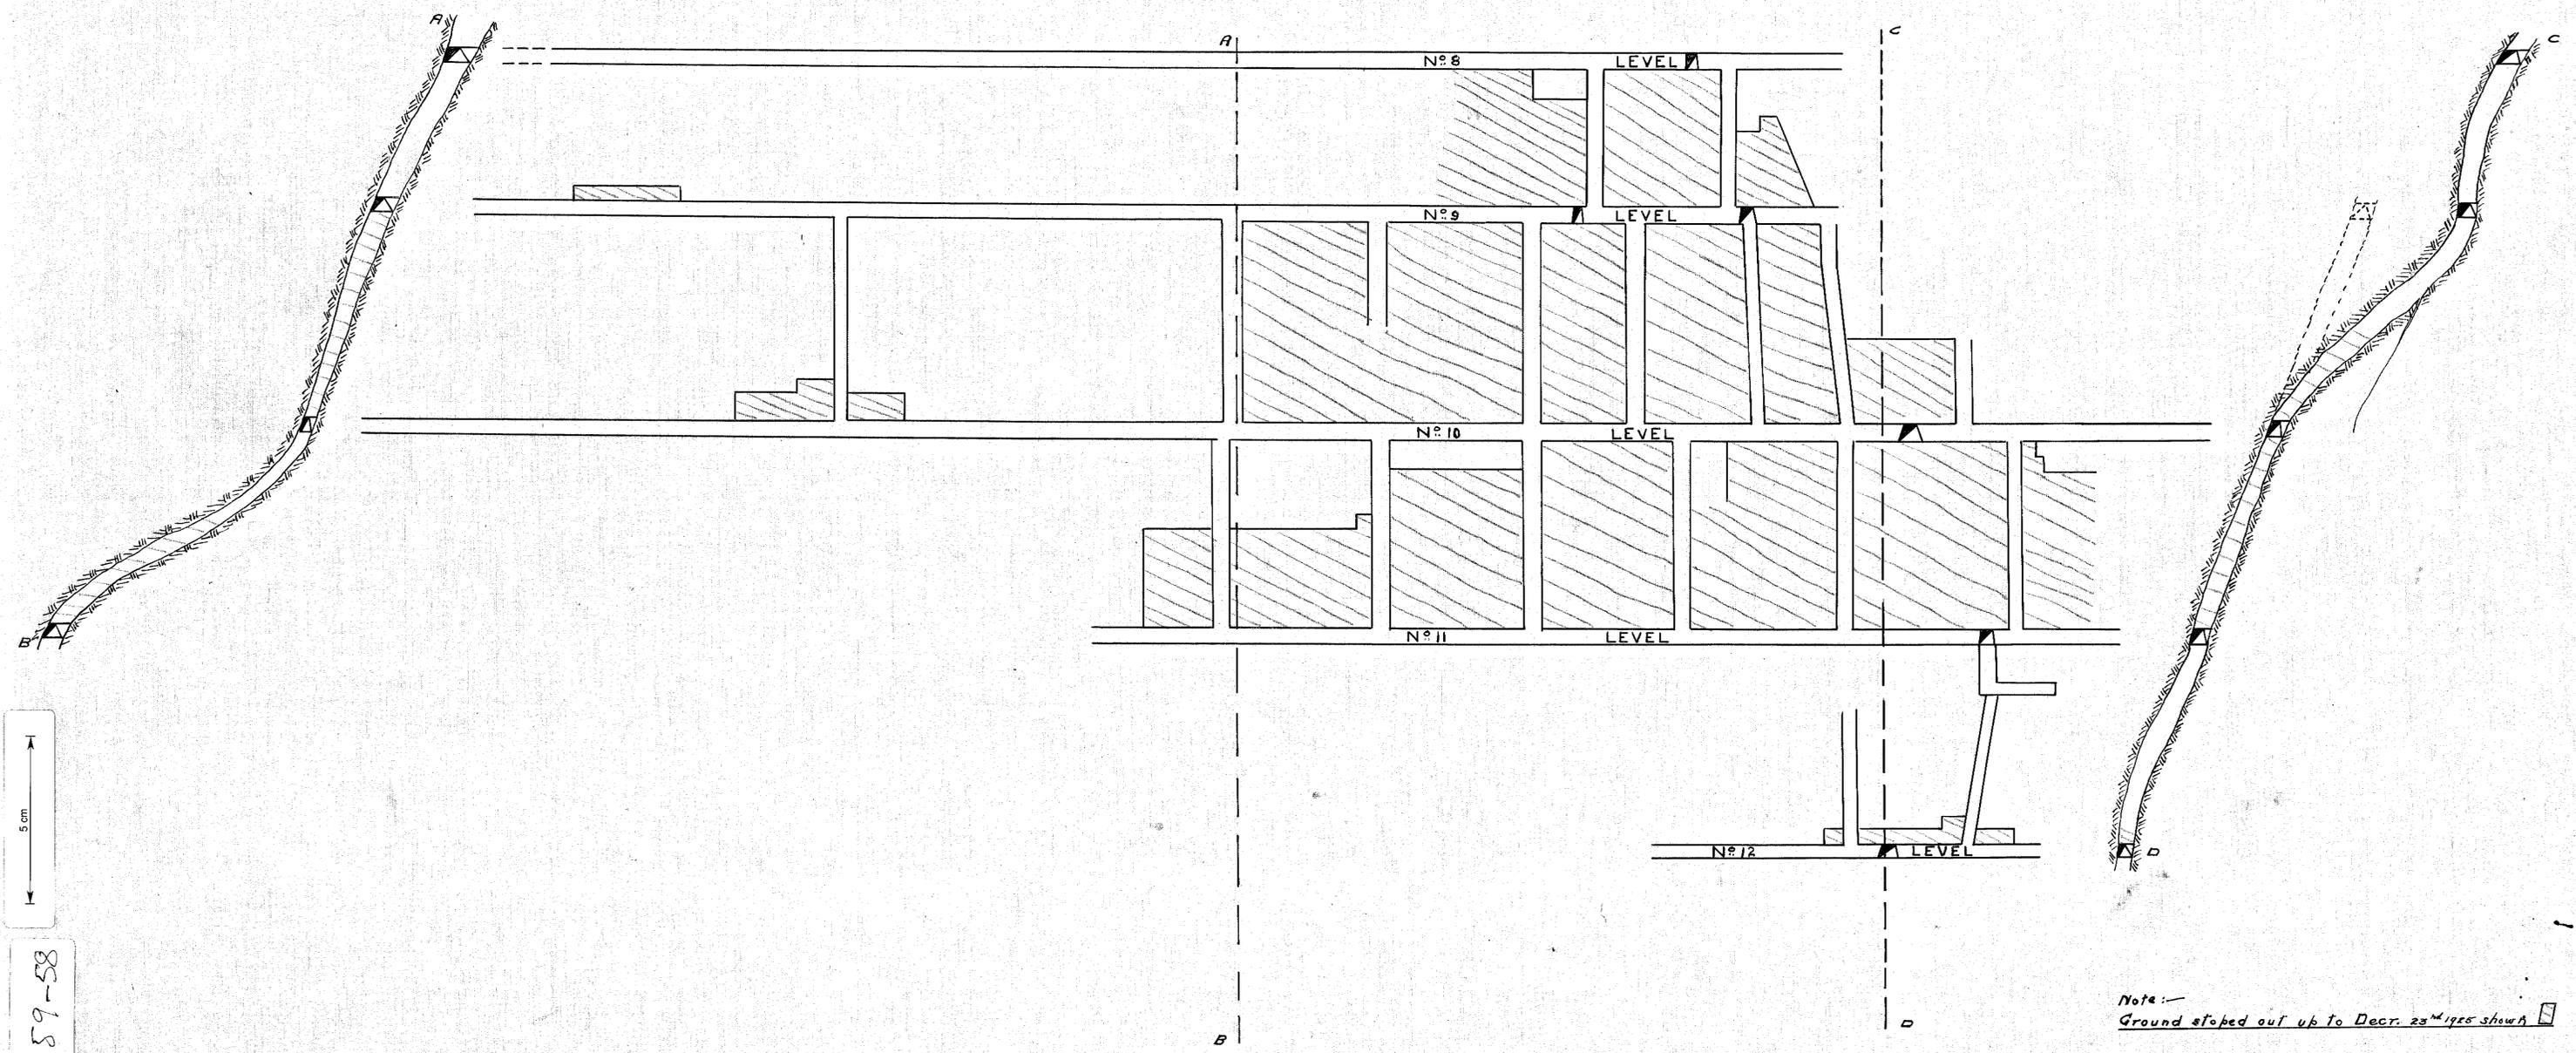

5 cm

85-68

Note:—  
Ground sloped out up to Decr. 23<sup>rd</sup> 1925 shown

*H. Belmont*  
SURVEYOR  
1925