


# PLAN OF STANHOPE COLLIERY

SCALE— 40 FEET TO 1 INCH

Proposed survey by A.M. Brown shown in blue  
As surveyed by A.M. Brown - - - -  
Surveyed and plotted to date by  
W. J. Staley, S.E. AMERICAN  
June 1<sup>st</sup> 1925 - Instrument used J. T. & S. T. Handley  
May 2<sup>nd</sup> 1922 - Survey shown in purple - - - -

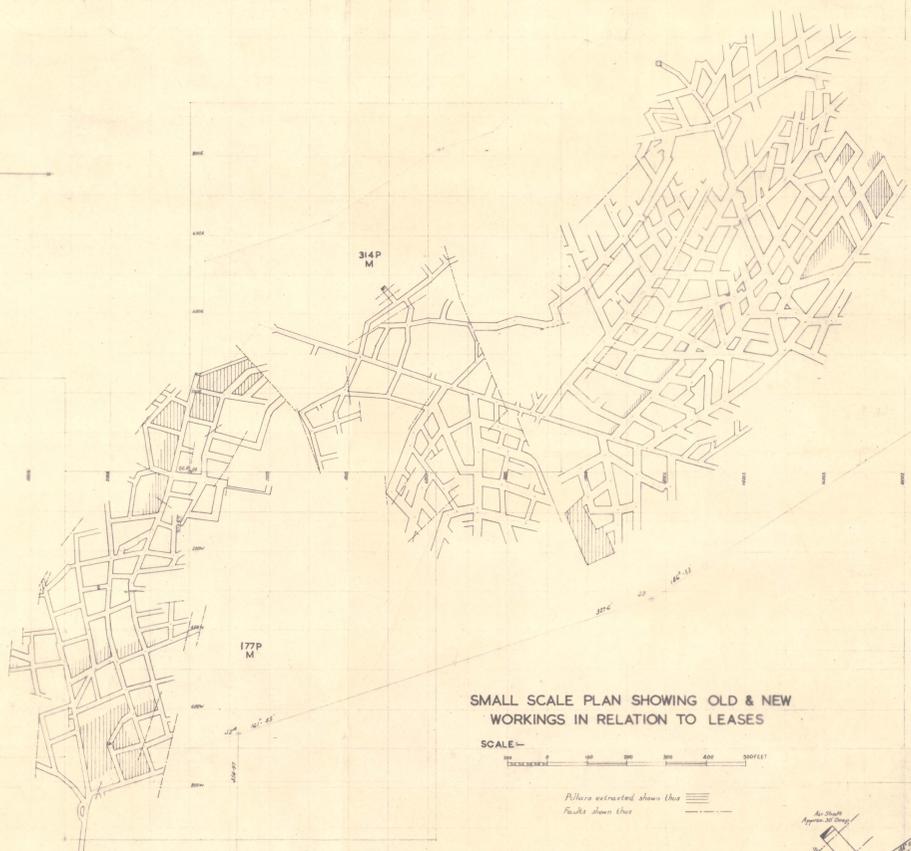

SMALL SCALE PLAN SHOWING OLD & NEW WORKINGS IN RELATION TO LEASES

SCALE— 1" = 100 FEET

Places extracted show this  
Facts show this


285P M

177P M

314P M

285P M

177P M

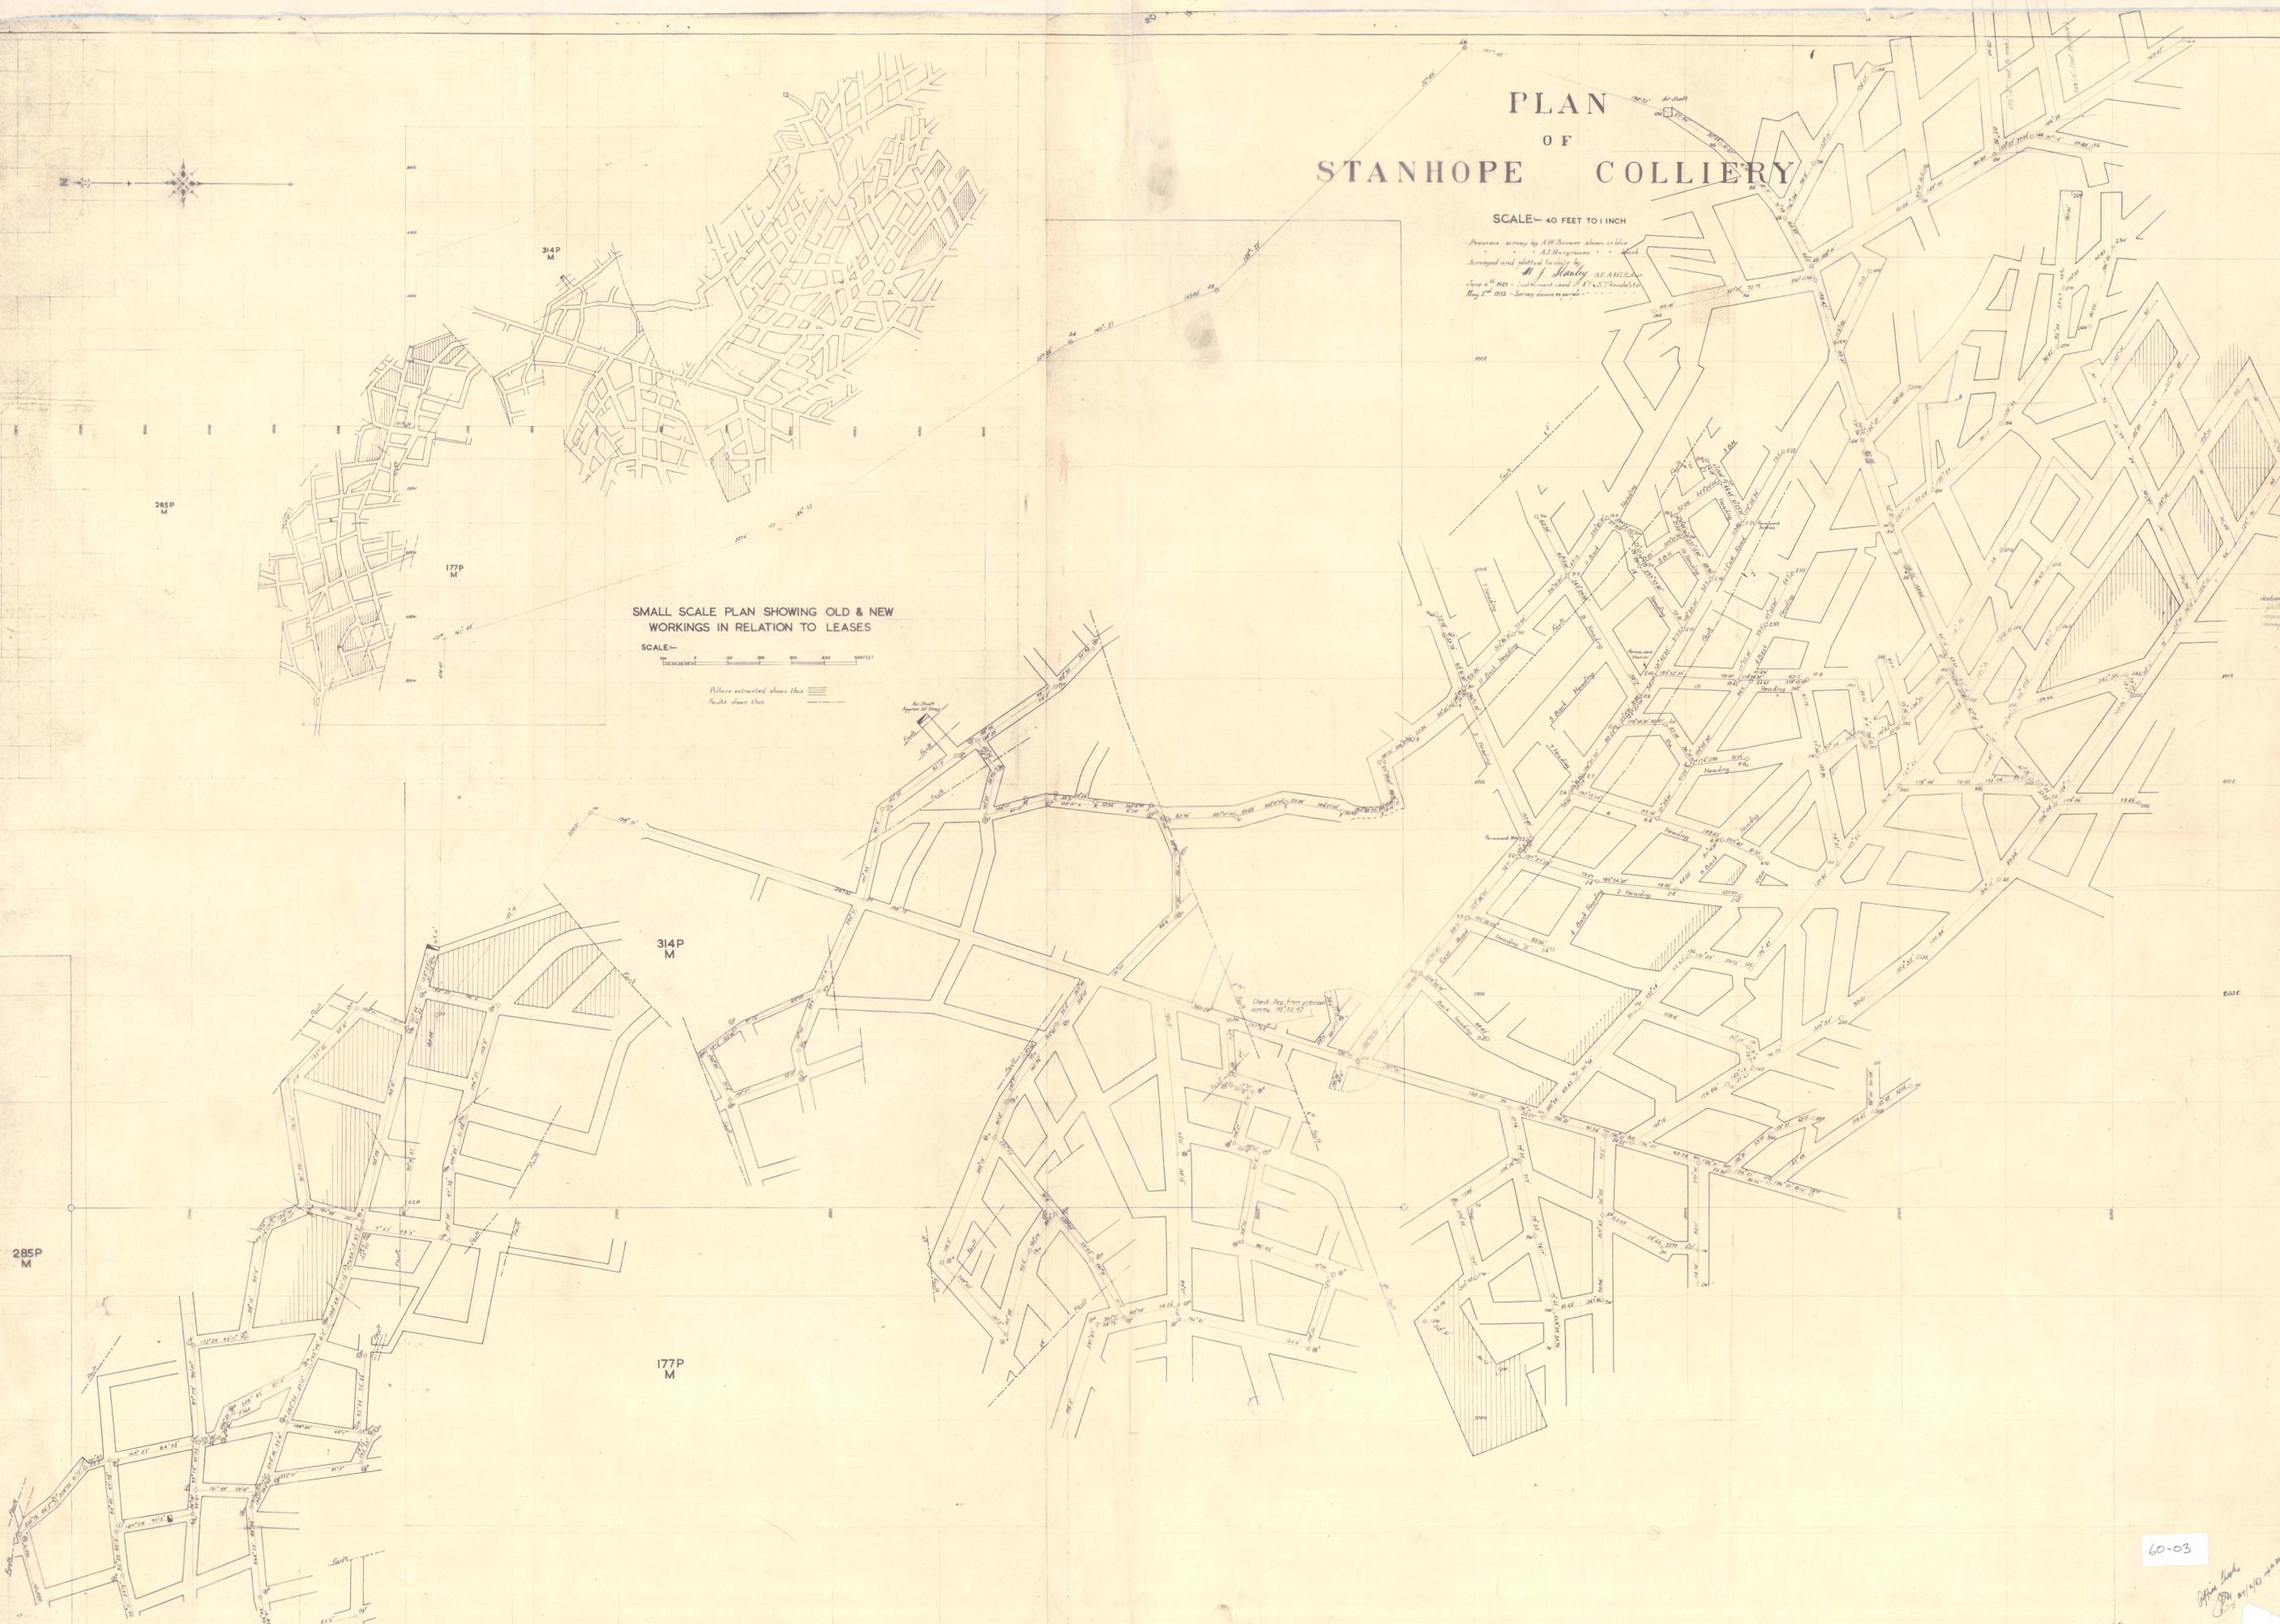

*John Smith*  
1925