
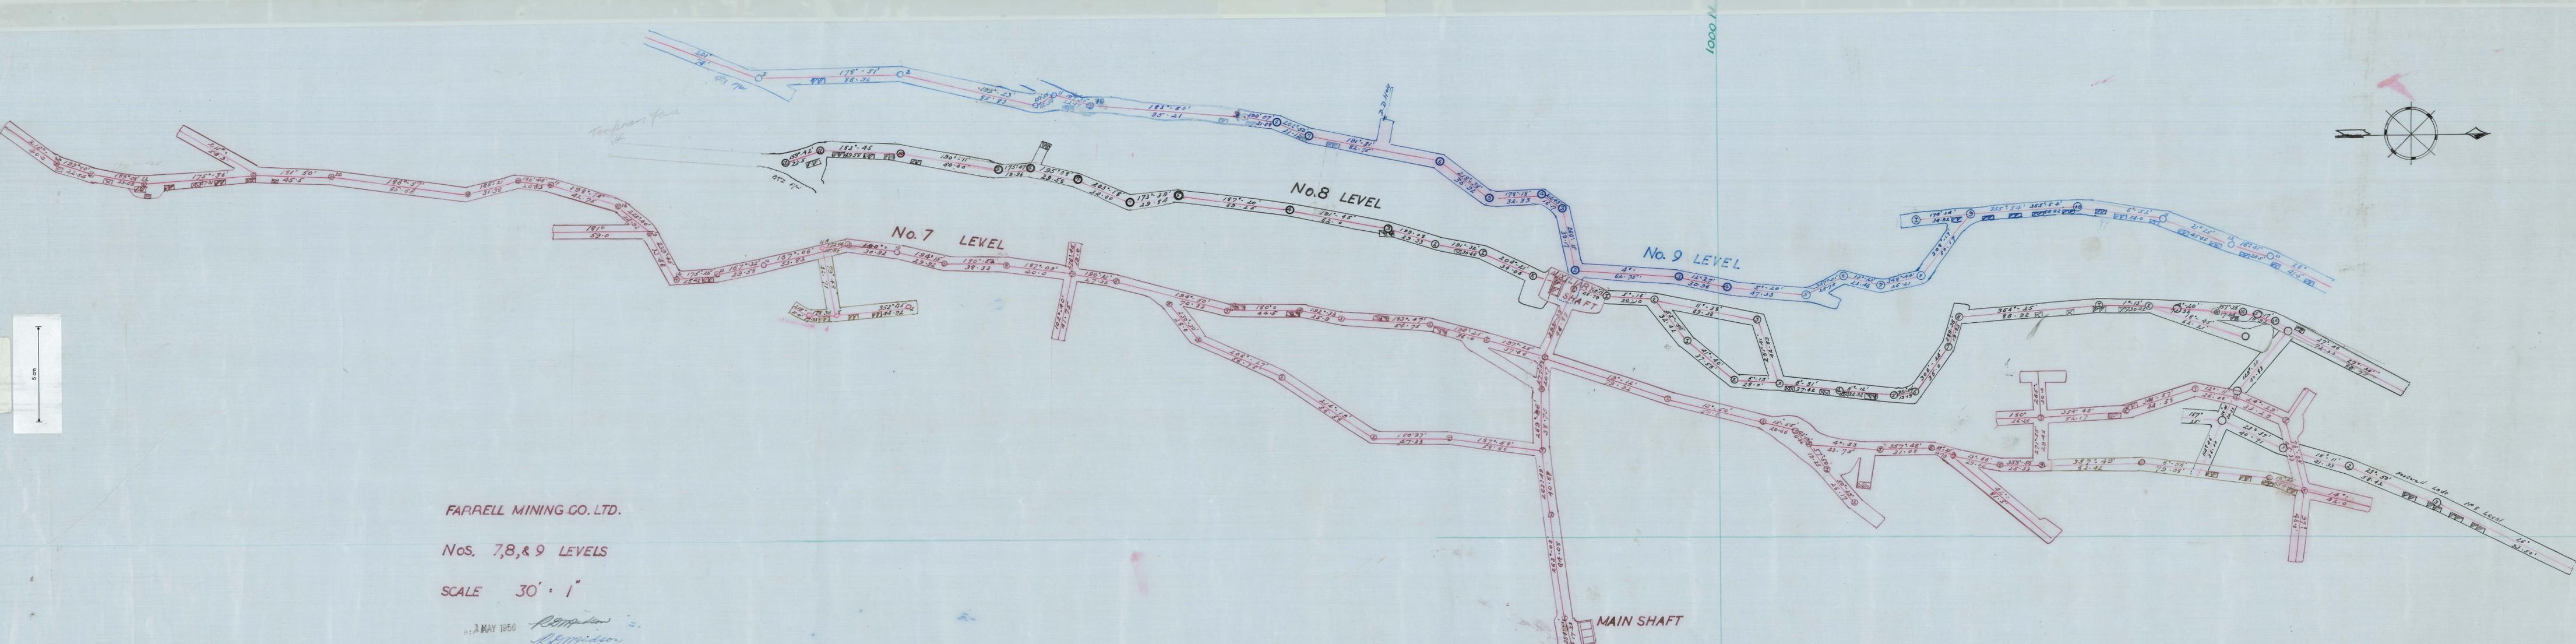


61-07

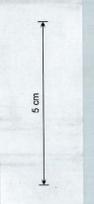

FARRELL MINING CO. LTD.

Nos. 7, 8, & 9 LEVELS

SCALE 30' = 1"

3 MAY 1959 *R. Middleton*
 4/10/58 *R. Middleton*
 6/5/59 *R. Middleton*
 8/5/63 *R. Middleton*
 23/2/63 *R. Middleton*

Development work in 1958 shown red.

500 E