
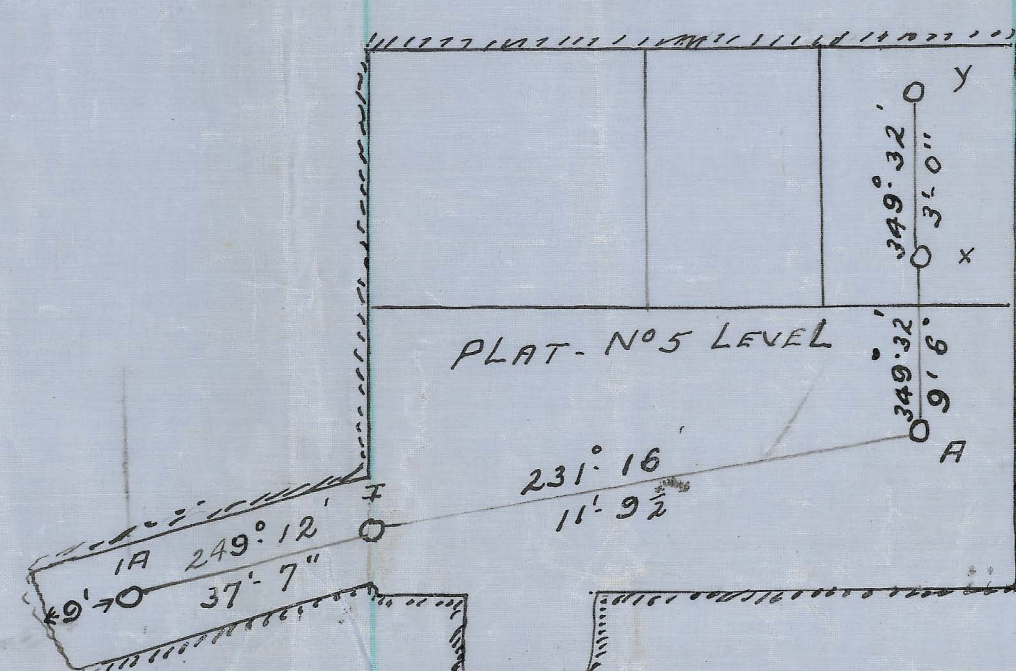



BARRELL MINING COMPANY, LIMITED
R. M. Davidson 19/7/51
R. M. Davidson 17/3/56

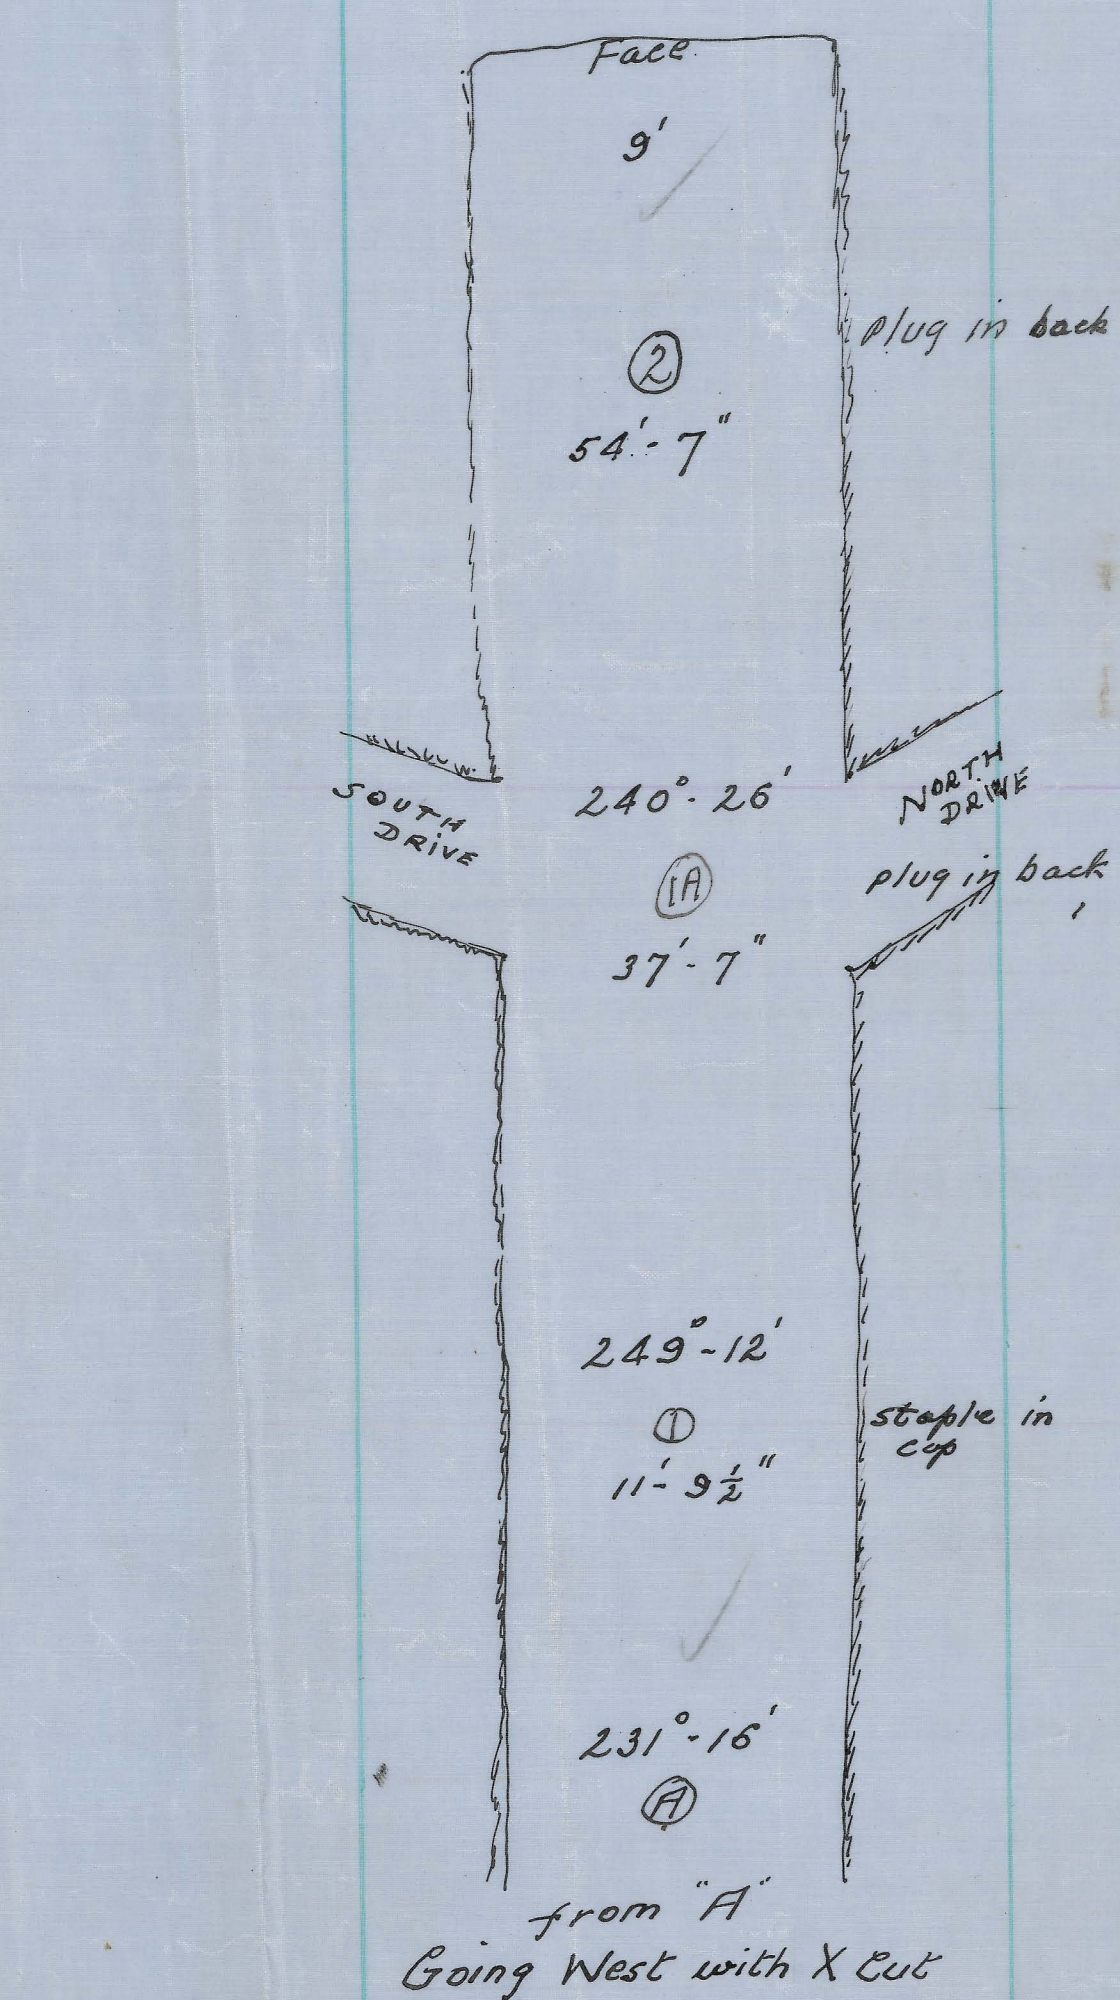


MAIN Shaft
surface.

A₂ ON Brass

N°5 Level Connection from Surface.

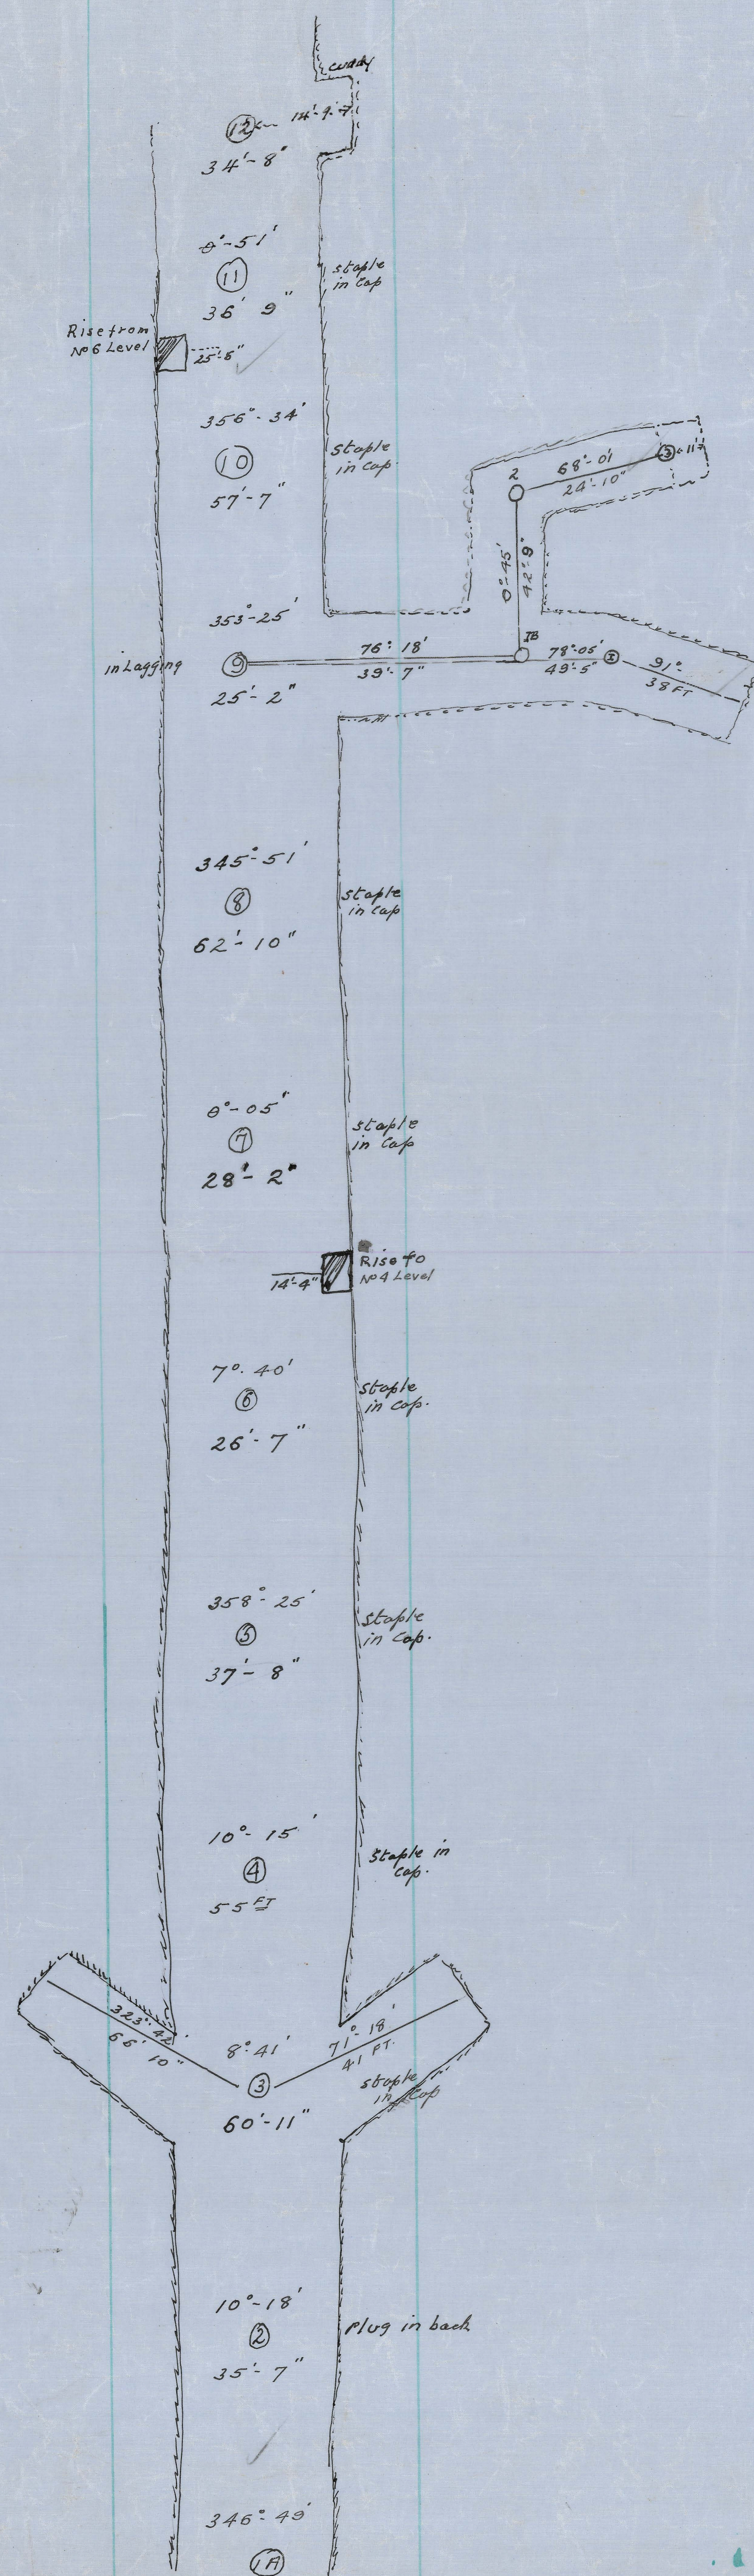

GOING NORTH FROM IA

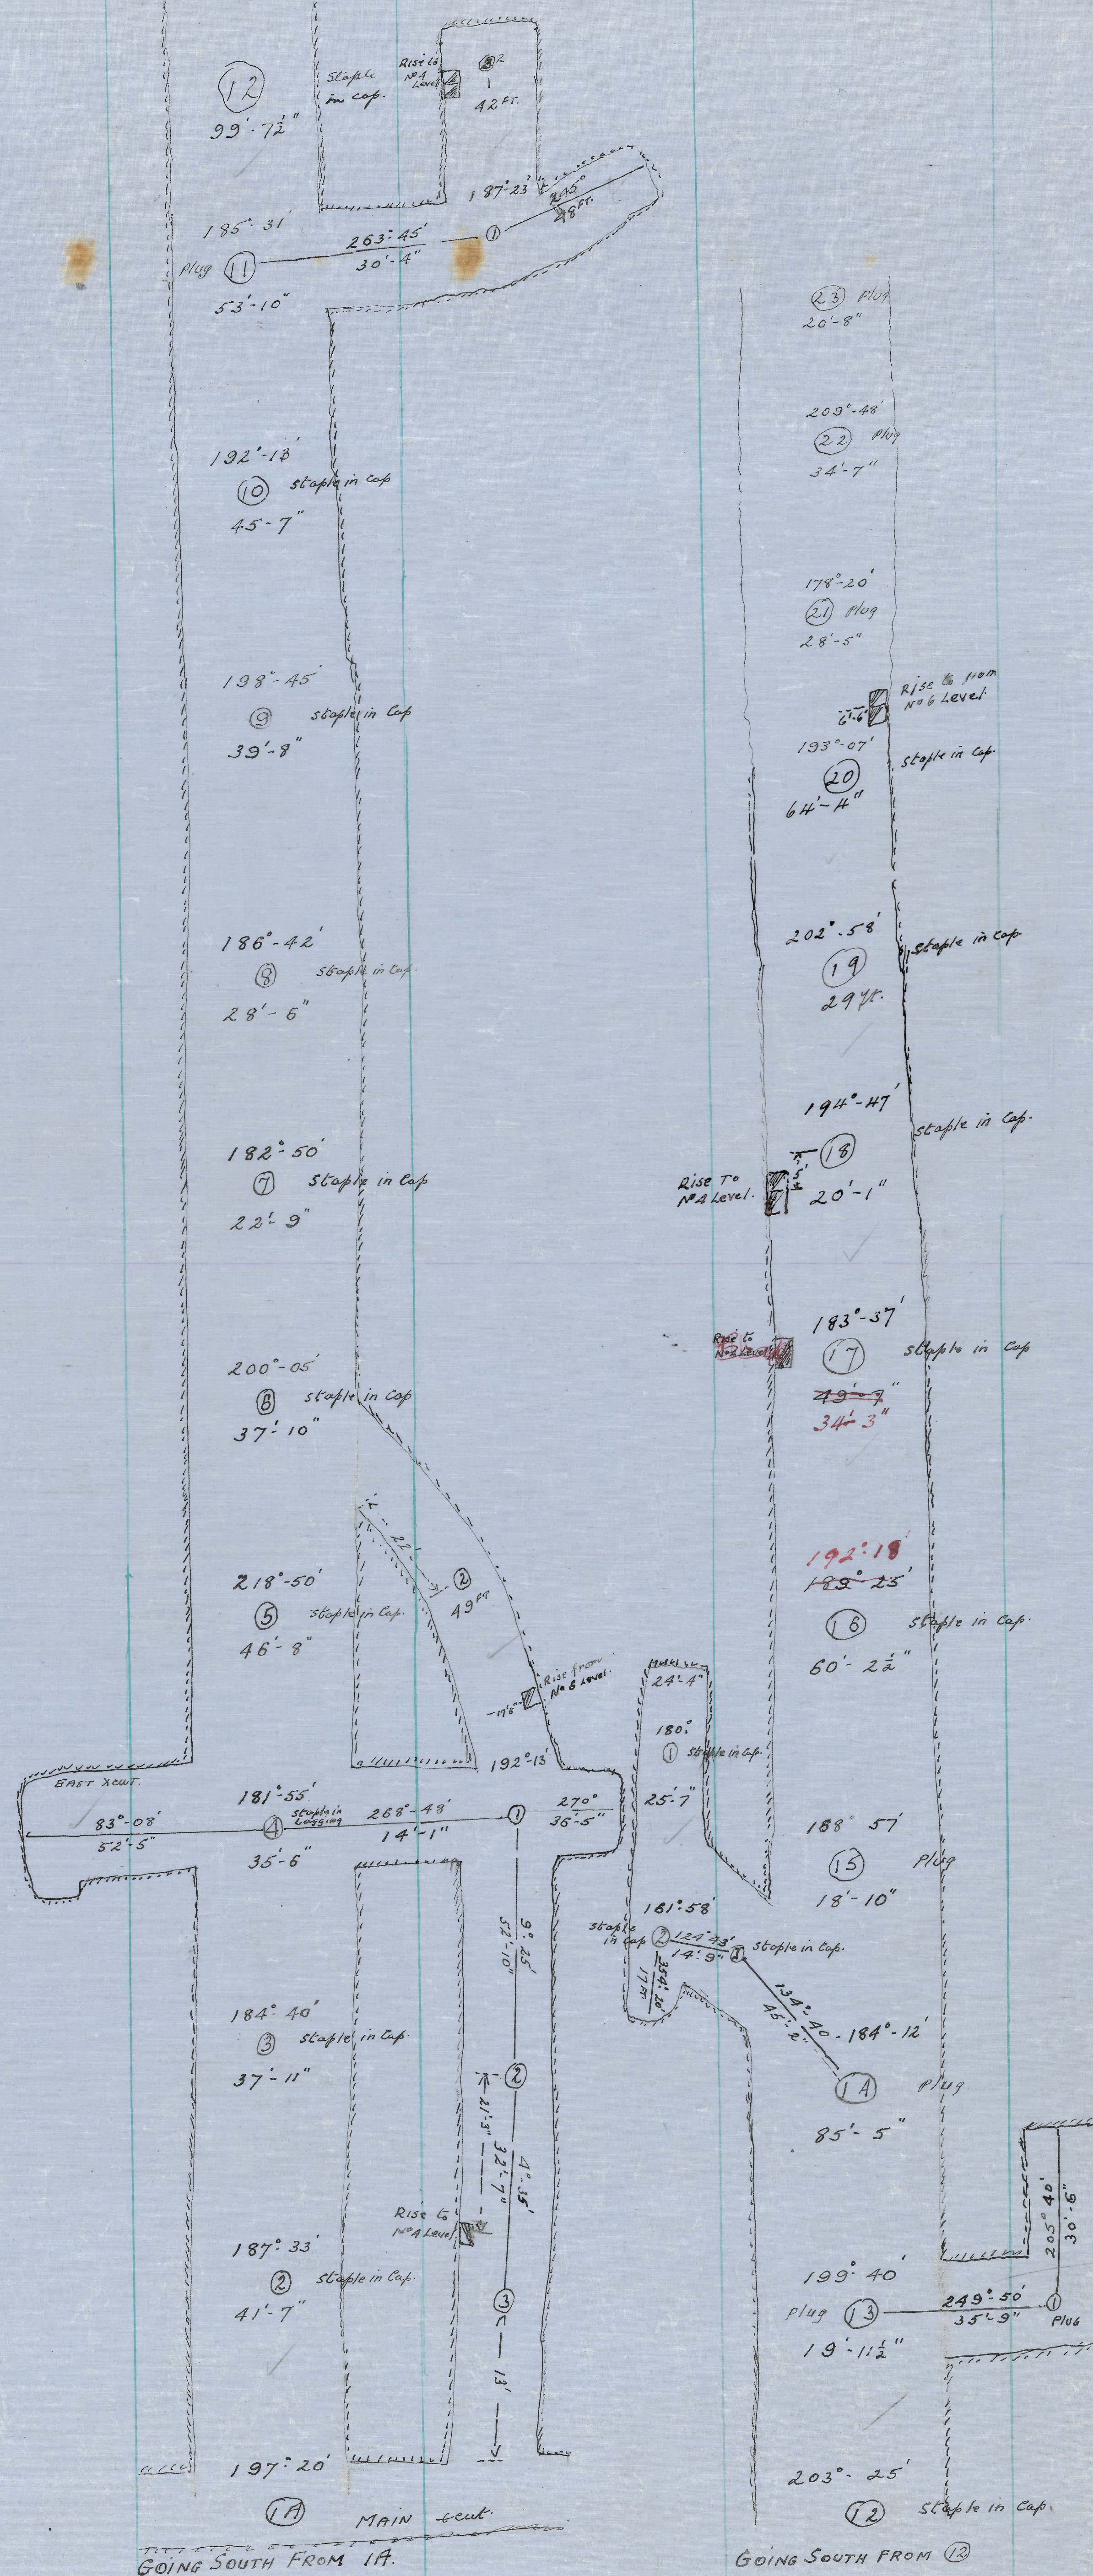

GOING SOUTH FROM 1A

GOING SOUTH FROM (12)

Office Week