



0061-023

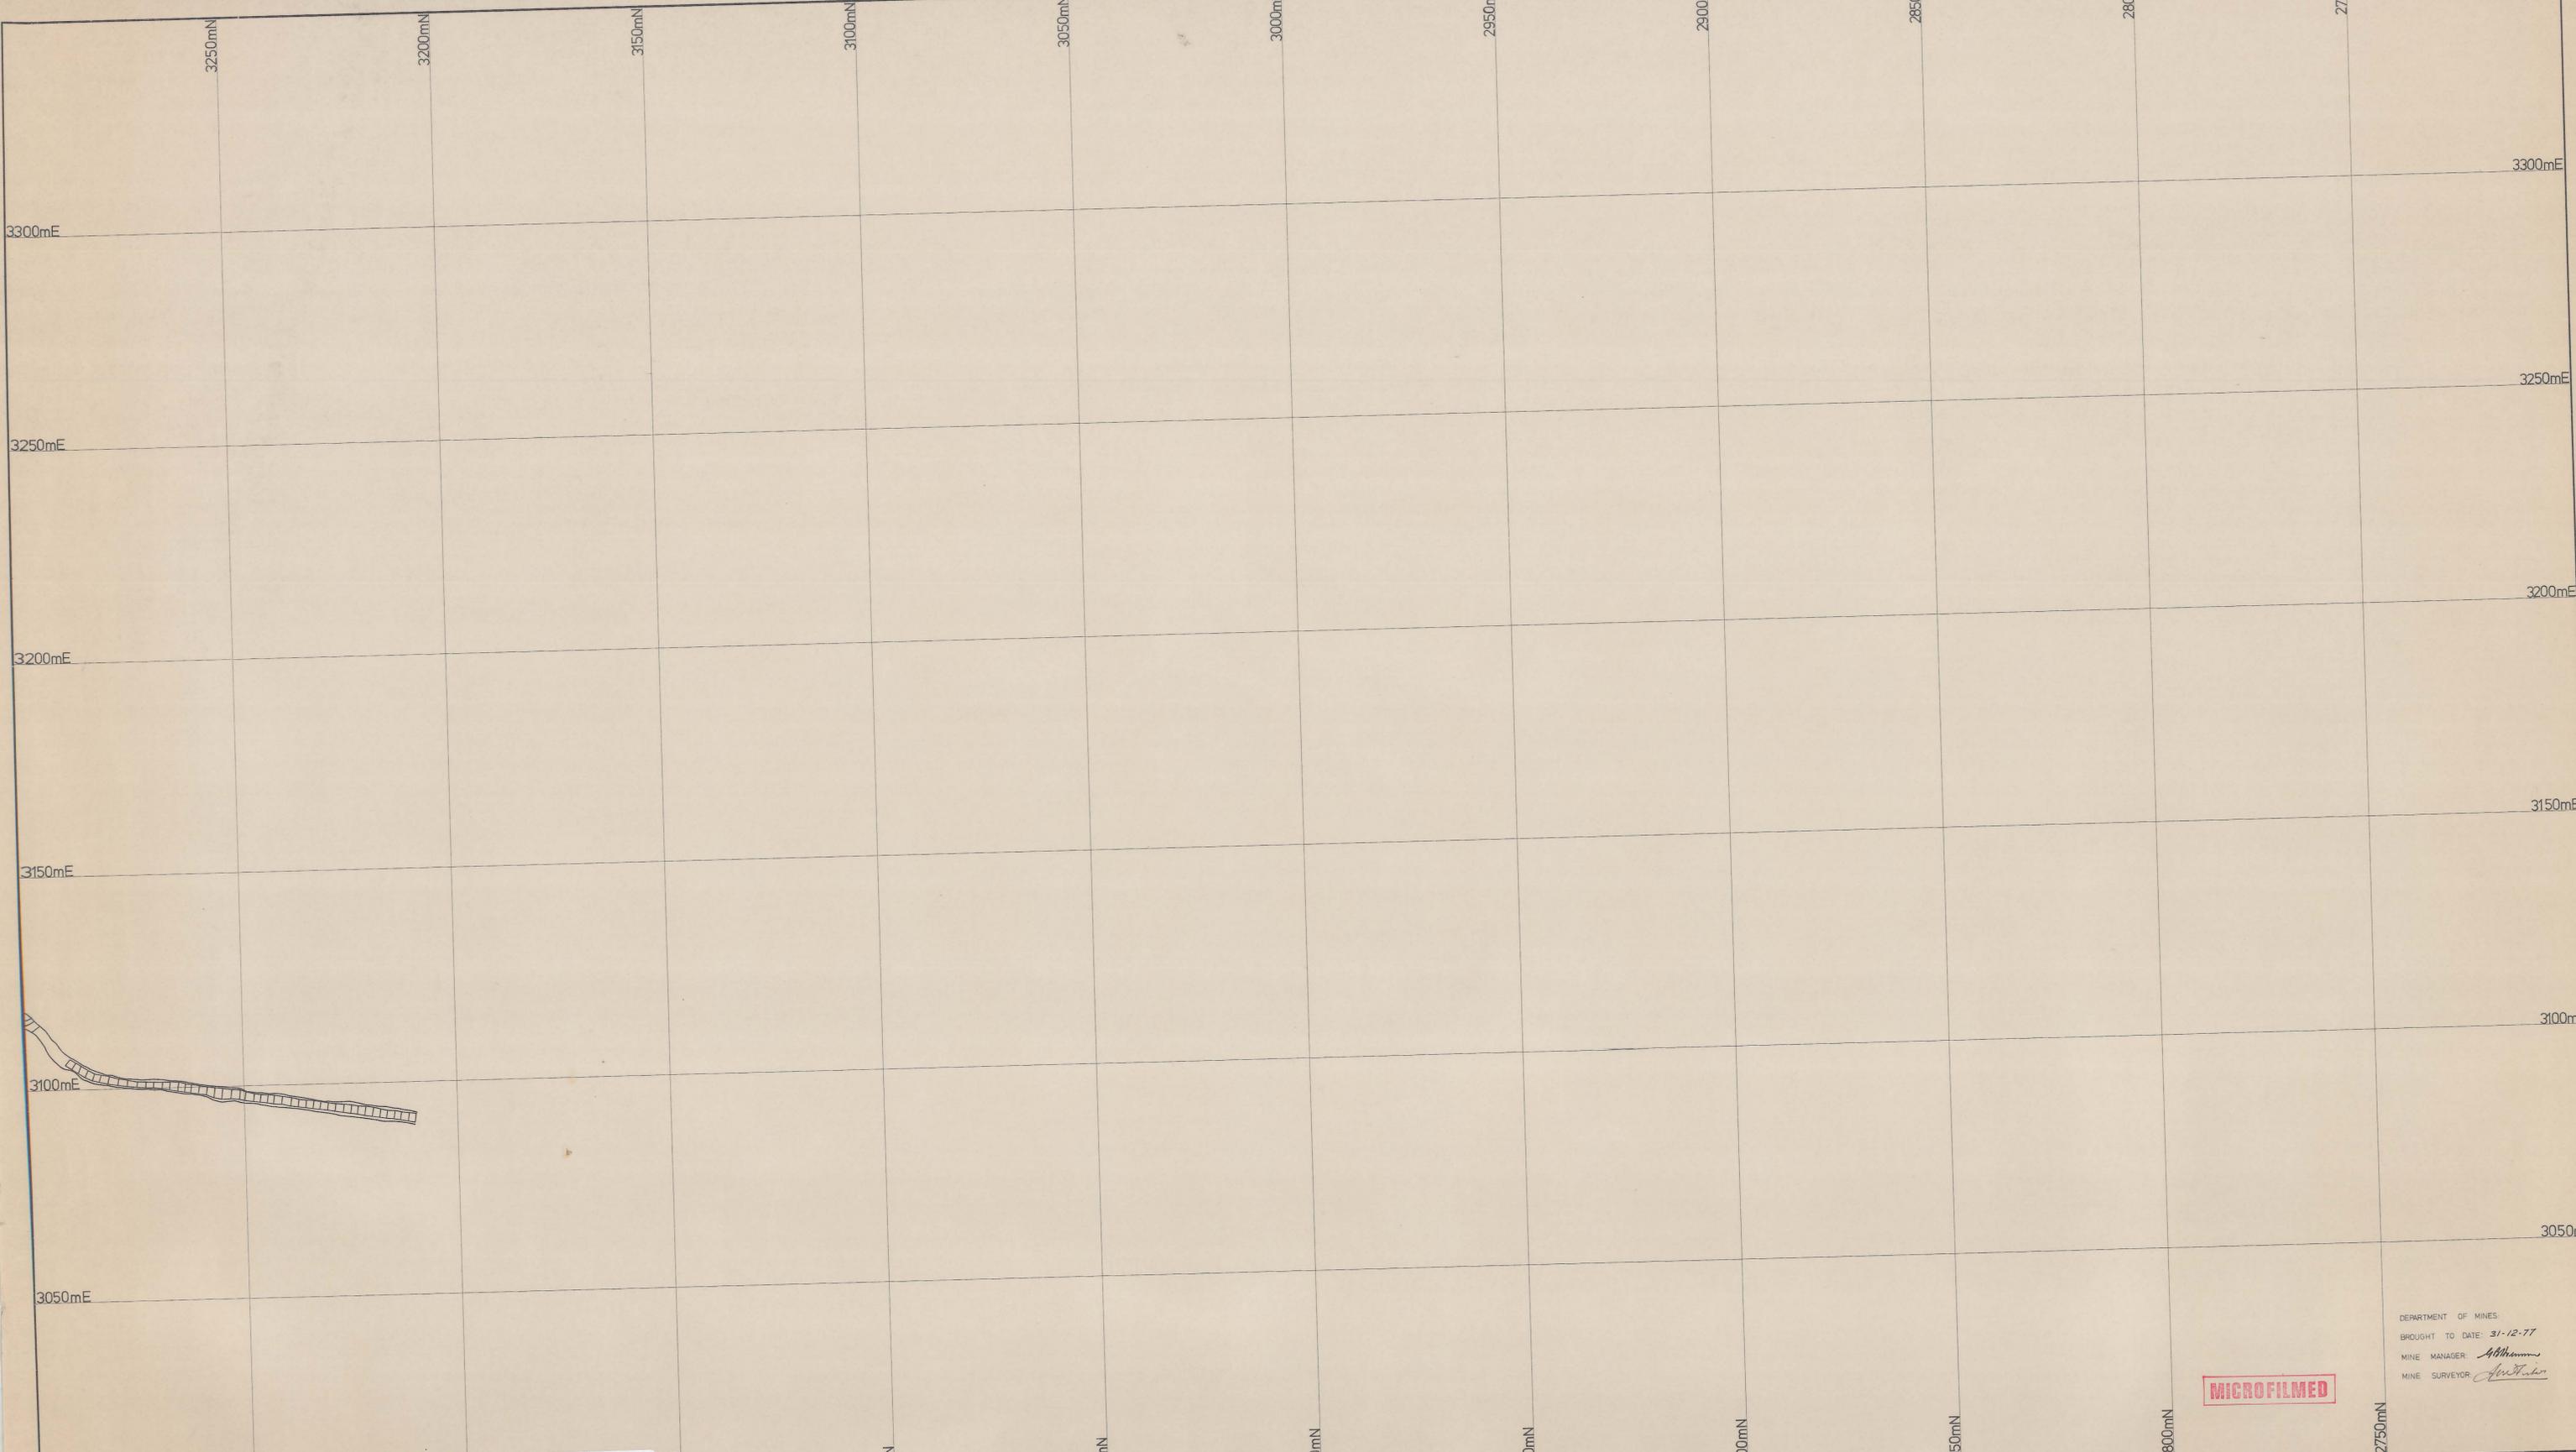

0061-023
0m

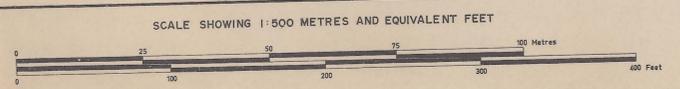

ELECTROLYTIC ZINC COMPANY OF AUSTRALASIA LIMITED
WEST COAST MINES, T.A.S.

SURVEY BY	SCALE	1:500
DRAWN BY	DATE	1975
TRACED BY	REFERENCE	

FARRELL MINE
No 10 LEVEL (2)

MICROFILMED

DEPARTMENT OF MINES
BROUGHT TO DATE: 31-12-77
MINE MANAGER: *Abraham*
MINE SURVEYOR: *Amthor*

DRAWING No: 78144