



0061-025

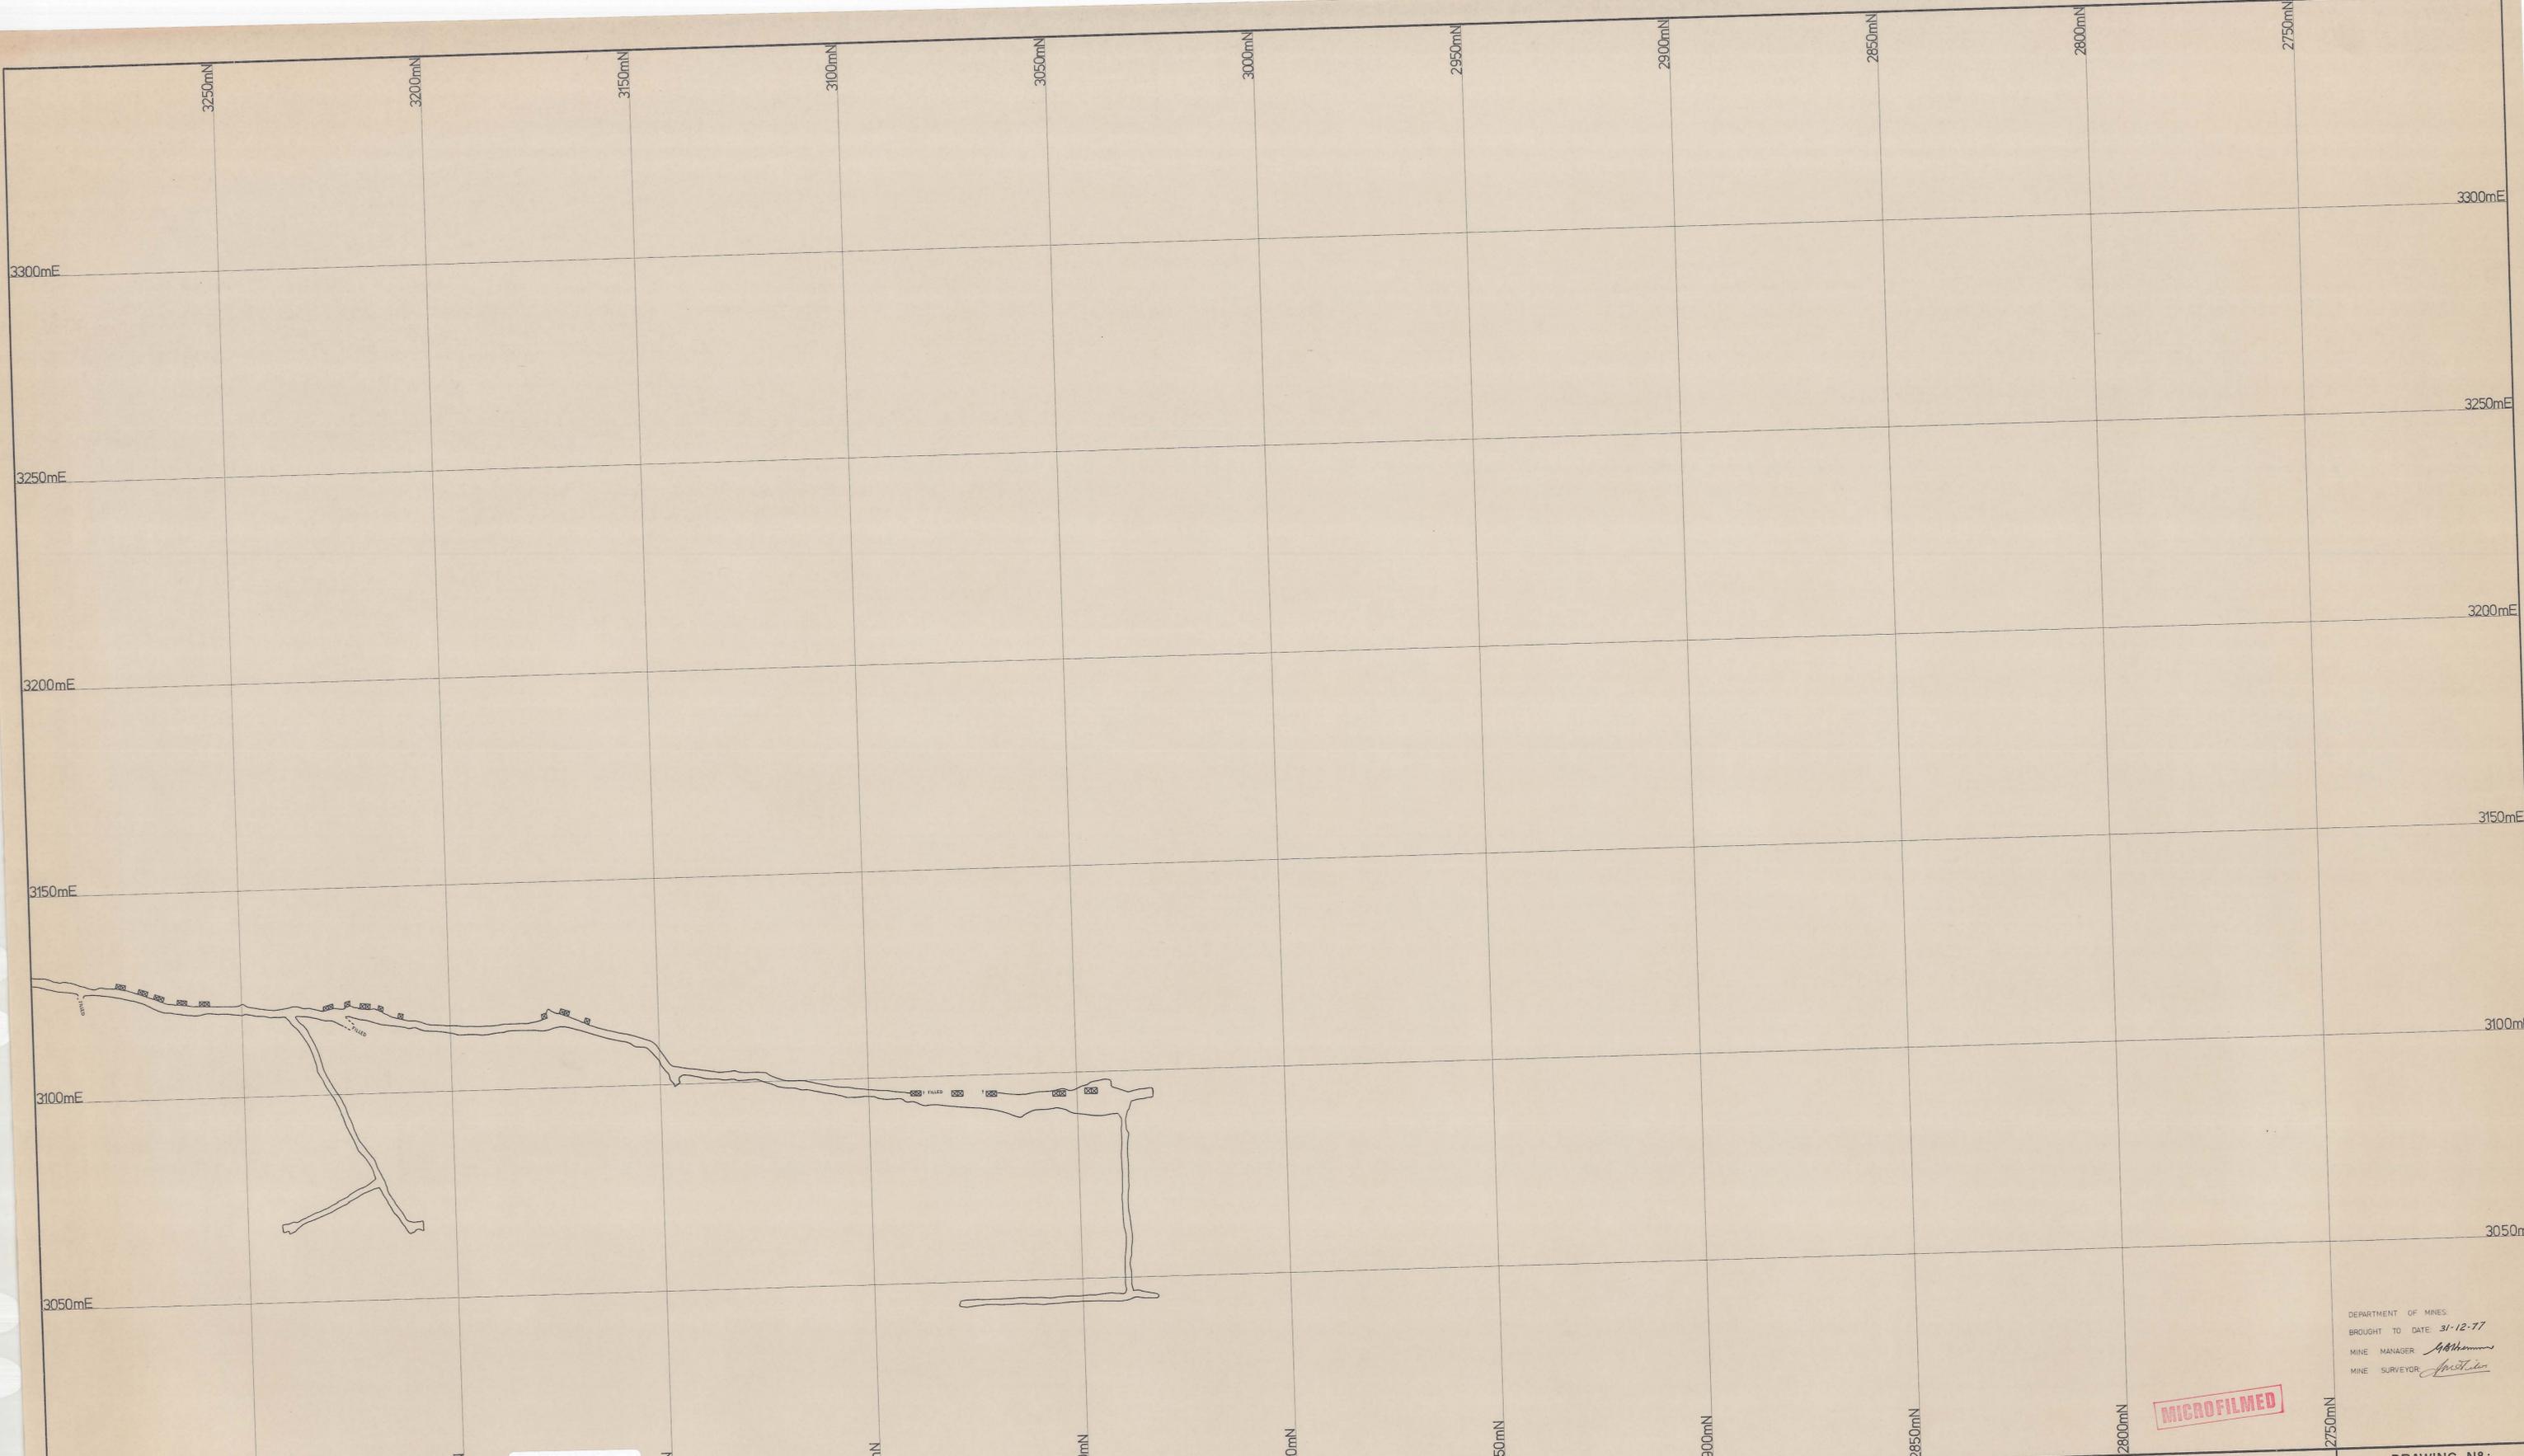

5m  
0061-025

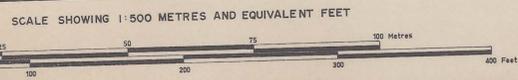

**ELECTROLYTIC ZINC COMPANY OF AUSTRALASIA LIMITED**  
 WEST COAST MINES, T.A.S.

SURVEY BY		SCALE	1:500
DRAWN BY		DATE	1975
TRACED BY		REFERENCE	

**MICROFILMED**

FARRELL MINE  
 No 9 LEVEL (2)

DEPARTMENT OF MINES  
 BROUGHT TO DATE: 31-12-77  
 MINE MANAGER: *A. H. Hemm*  
 MINE SURVEYOR: *J. M. ...*

DRAWING NO.:  
 78142