


0061 - 026



0061 - 026

MICROFILMED

DEPARTMENT OF MINES:
 BROUGHT TO DATE 31-12-77
 MINE MANAGER *MBM*
 MINE SURVEYOR *ITM*

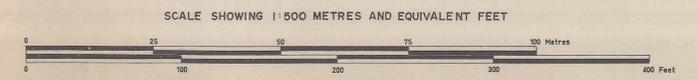

ELECTROLYTIC ZINC COMPANY OF AUSTRALASIA LIMITED
 WEST COAST MINES, T.A.S.

SURVEY BY		SCALE	1: 500
DRAWN BY		DATE	1975
TRACED BY	ITMoore	REFERENCE	

FARRELL MINE
 No 9 LEVEL (1)

DRAWING No: (2) *78164*