


0061-027

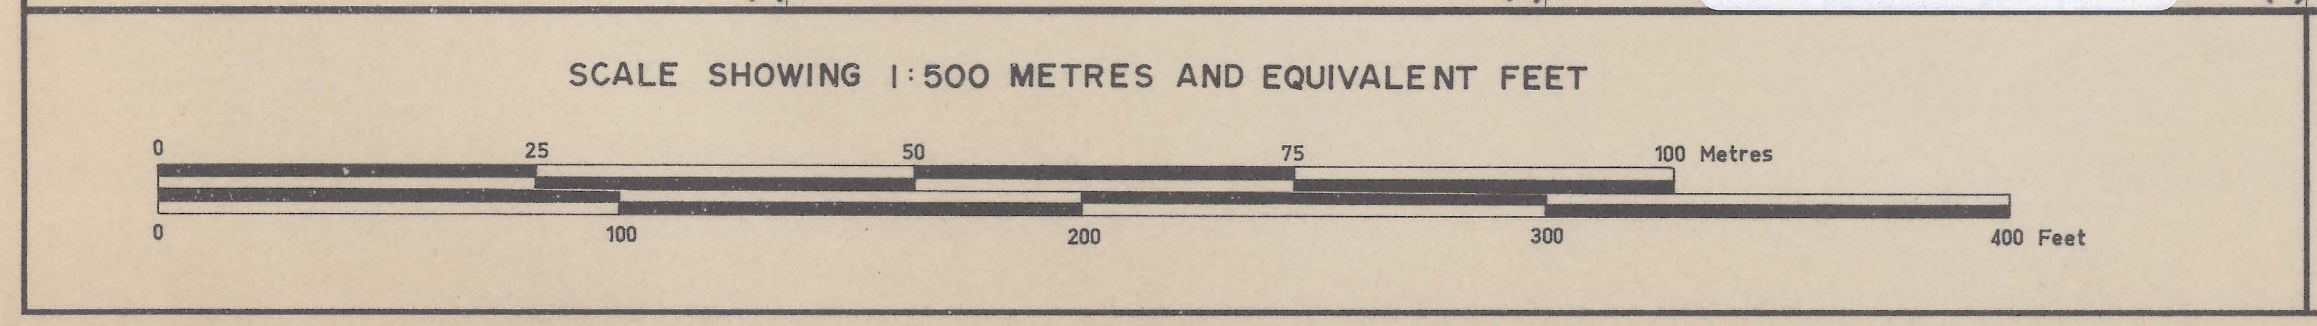

ELECTROLYTIC ZINC COMPANY OF AUSTRALASIA LIMITED
WEST COAST MINES, TAS.

SURVEY BY		SCALE	1:500
DRAWN BY		DATE	1975
TRACED BY		REFERENCE	

FARRELL MINE
No 8 LEVEL (2)

DRAWING No: 78160

MICROFILMED

DEPARTMENT OF MINES
BROUGHT TO DATE: 31-12-77
MINE MANAGER: *A. H. Hume*
MINE SURVEYOR: *A. H. Hume*