


0061-028



5m
0061-028

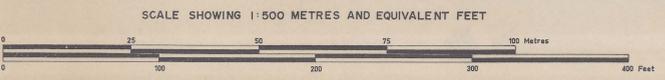

ELECTROLYTIC ZINC COMPANY OF AUSTRALASIA LIMITED
 WEST COAST MINES, T.A.S.

SURVEY BY		SCALE	1:500
DRAWN BY		DATE	1975
TRACED BY	I.T. Moore.	REFERENCE	

FARRELL MINE
 No 8 LEVEL (1)

MICROFILMED

DEPARTMENT OF MINES
 BROUGHT TO DATE 31-12-77
 MINE MANAGER *[Signature]*
 MINE SURVEYOR *[Signature]*

DRAWING No: (2) 78139