



0061 - 030

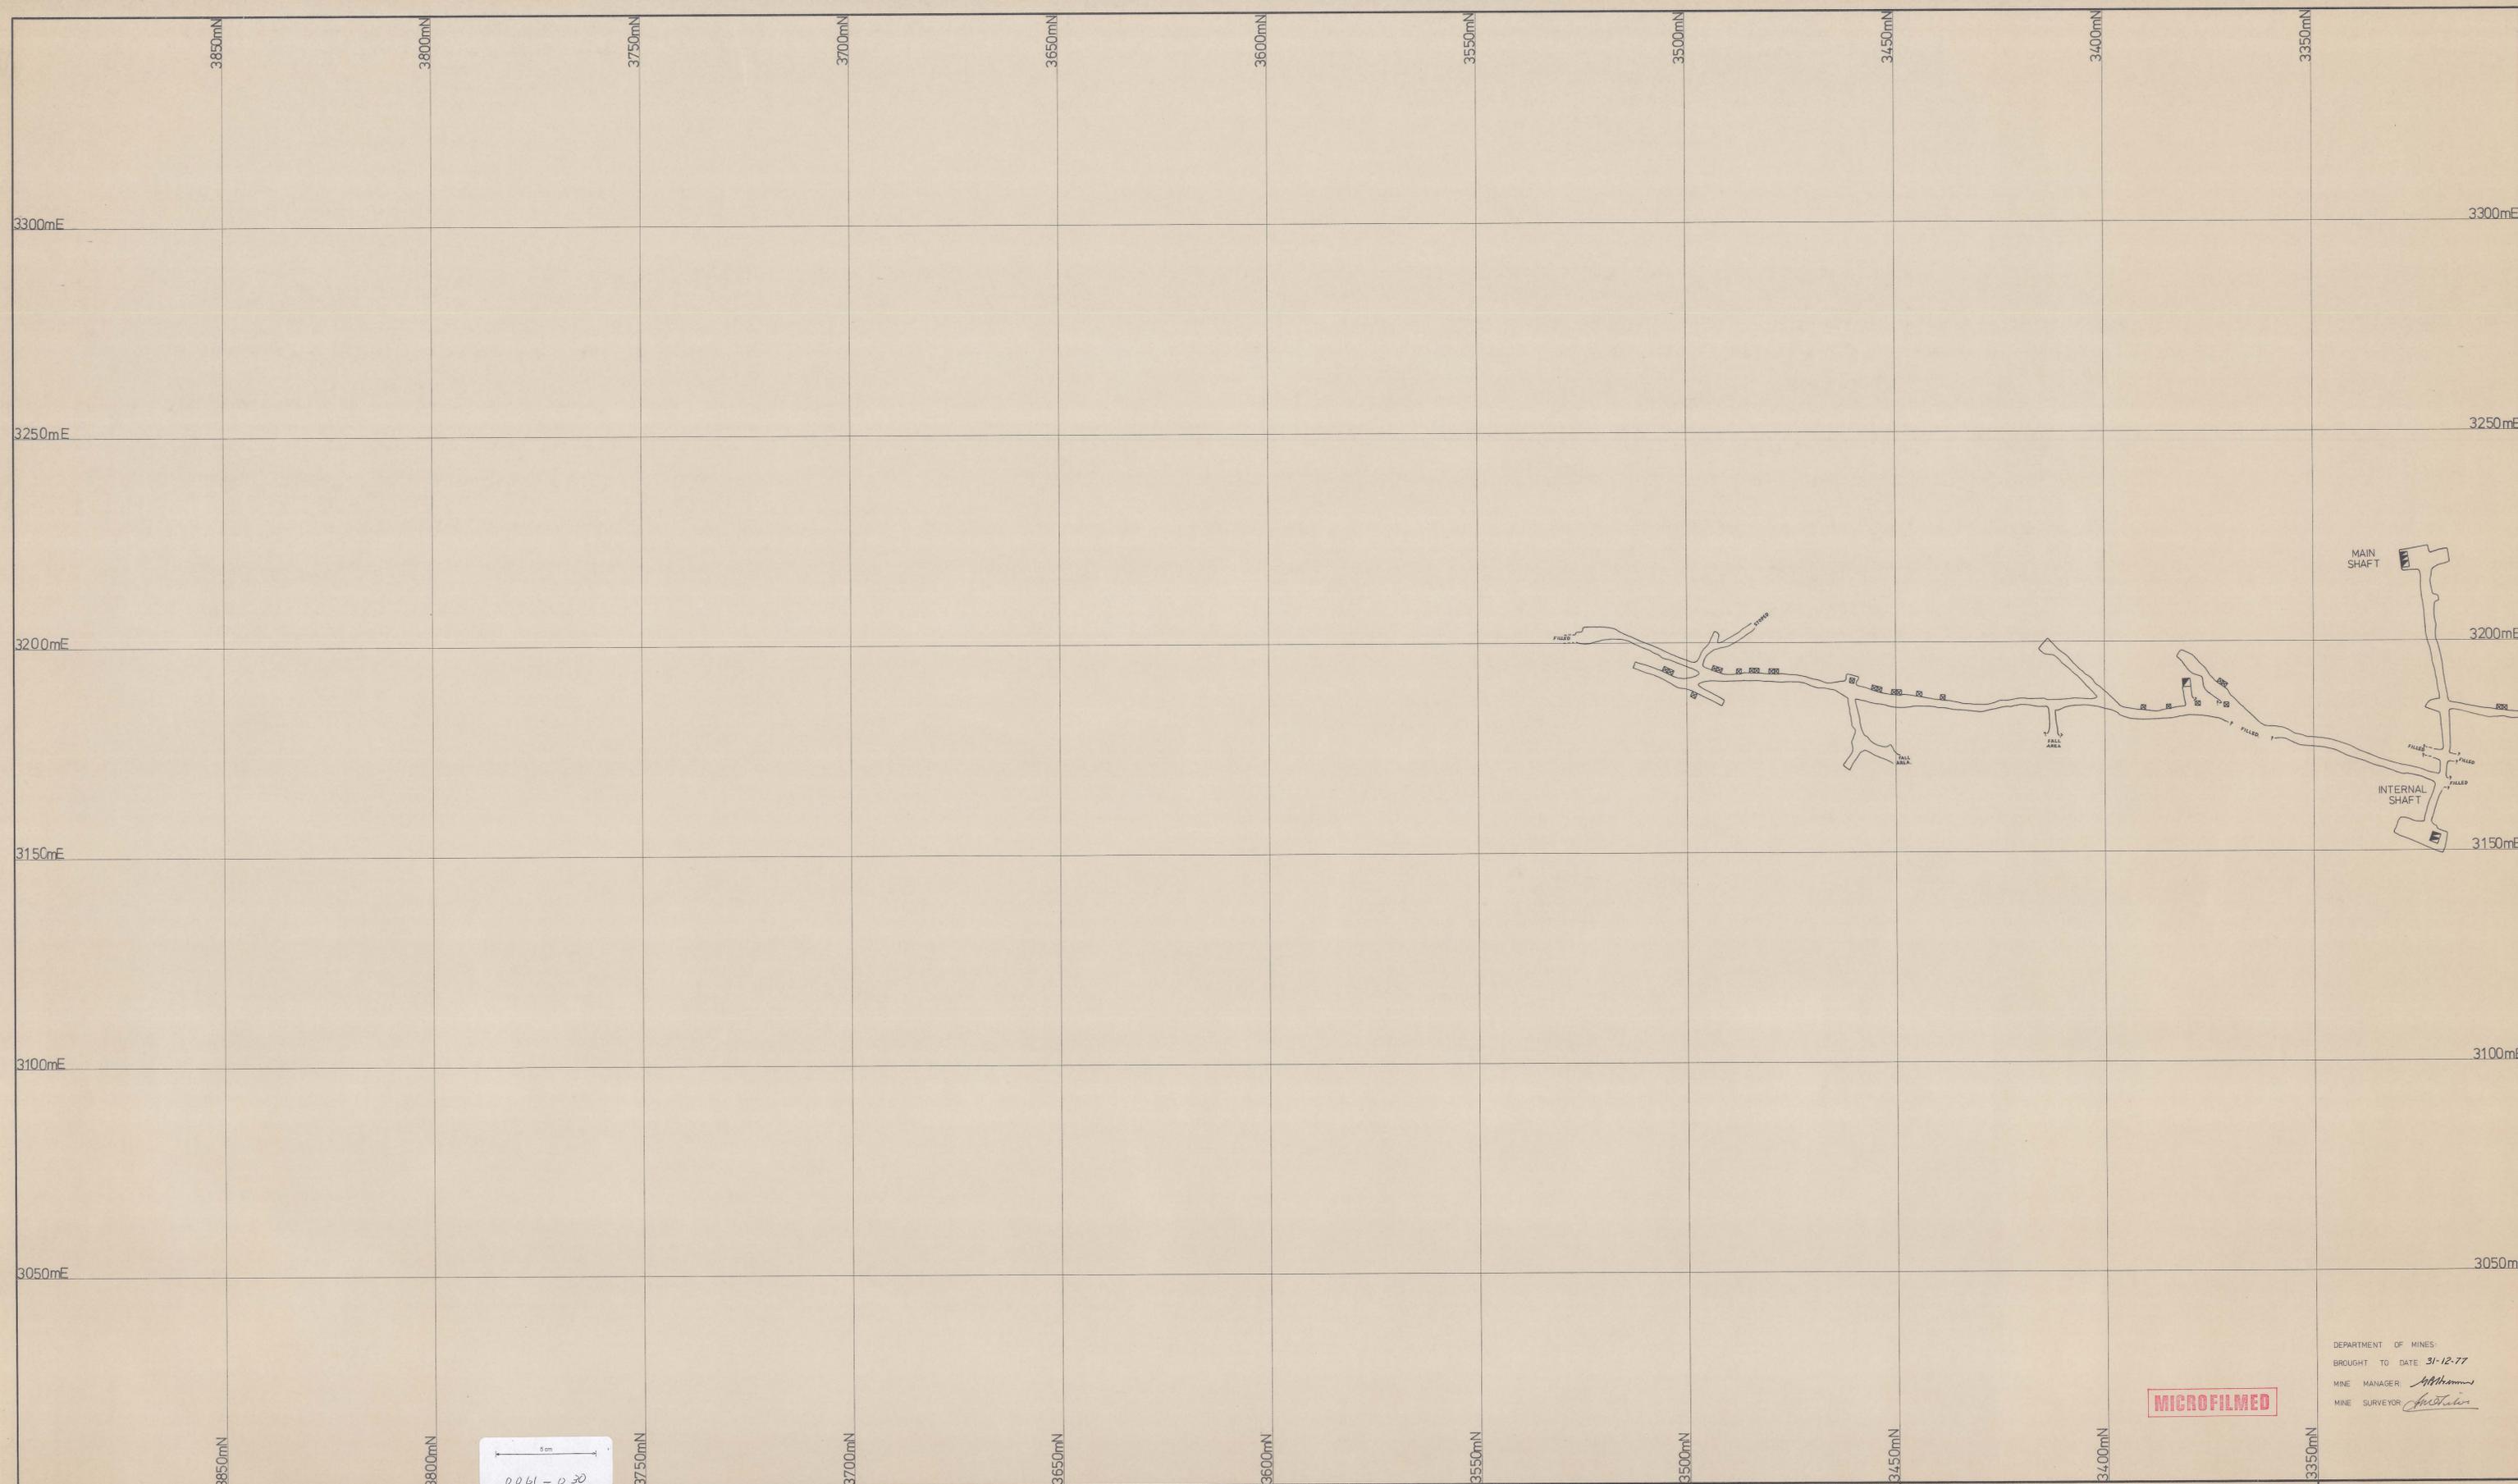

5m
0061 - 030

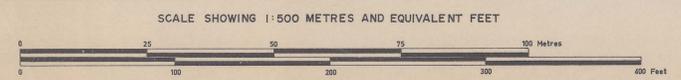

ELECTROLYTIC ZINC COMPANY OF AUSTRALASIA LIMITED
WEST COAST MINES, TAS.

SURVEY BY		SCALE	1:500
DRAWN BY		DATE	1975
TRACED BY	I.T. Moore	REFERENCE	

FARRELL MINE
No 7 LEVEL (1)

MICROFILMED

DEPARTMENT OF MINES
BROUGHT TO DATE 31-12-77
MINE MANAGER *A. Williams*
MINE SURVEYOR *A. Williams*

DRAWING No: (2) 78137