



0061-032

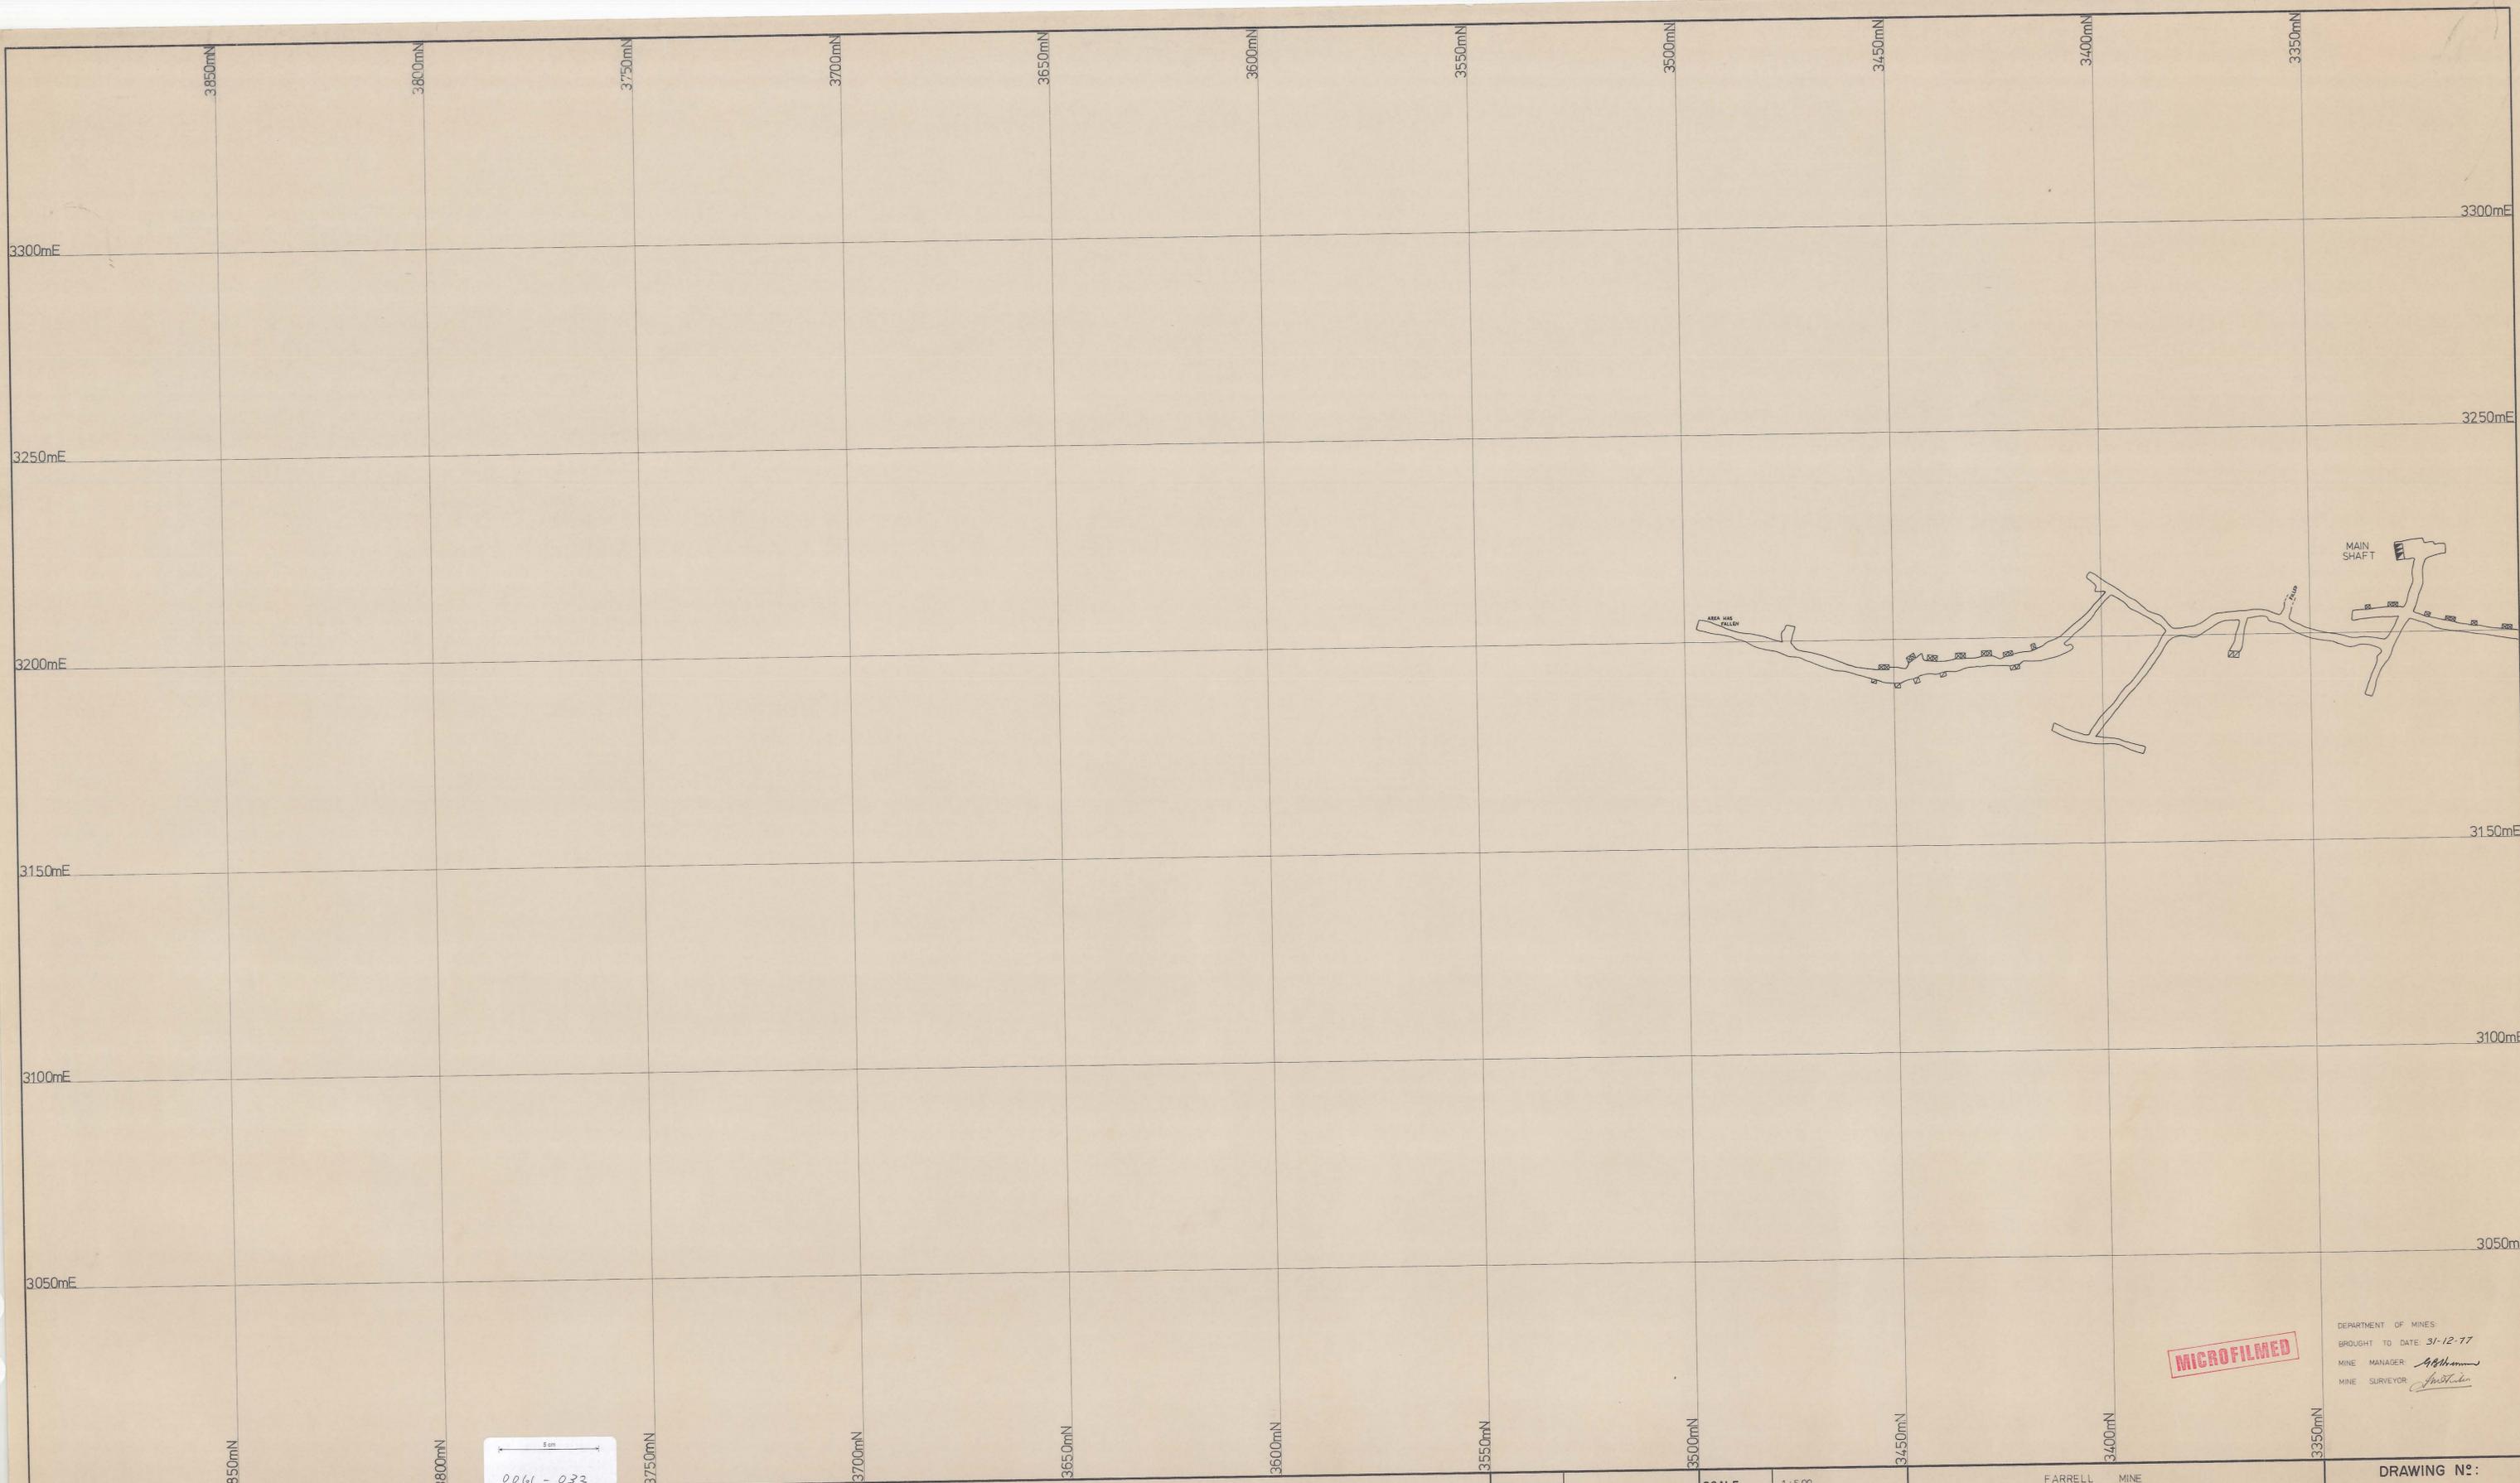

0061-032

MICROFILMED

DEPARTMENT OF MINES
 BROUGHT TO DATE 31-12-77
 MINE MANAGER: *[Signature]*
 MINE SURVEYOR: *[Signature]*

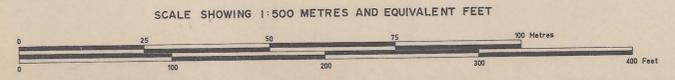

ELECTROLYTIC ZINC COMPANY OF AUSTRALASIA LIMITED
 WEST COAST MINES, T.A.S.

SURVEY BY		SCALE	1:500
DRAWN BY		DATE	1975
TRACED BY	I.T. Moore	REFERENCE	

FARRELL MINE
 No 6 LEVEL (1)

DRAWING No: 78135