

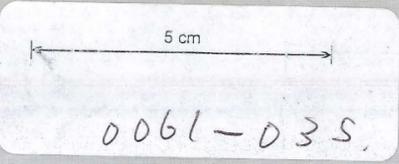
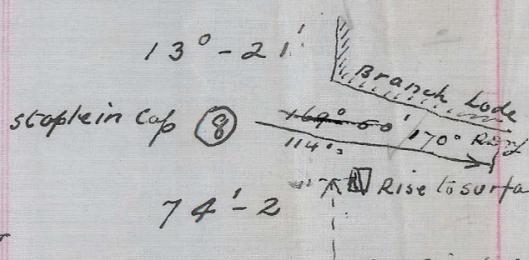
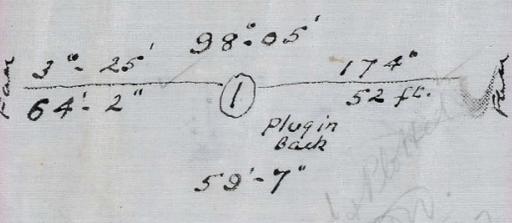
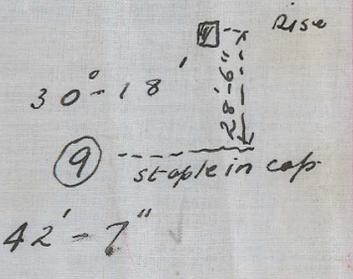




Old mine 8/2/42  
Quarry 3/7/44  
12/5/45  
R. Morrison 5/12/56  
R. Morrison 1/4/59

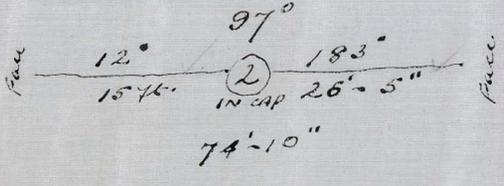

Face East + Cut  
112 ft

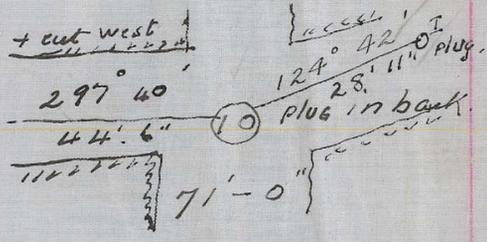


95°-58'  
8A In Lagging  
Main Drive  
29 ft

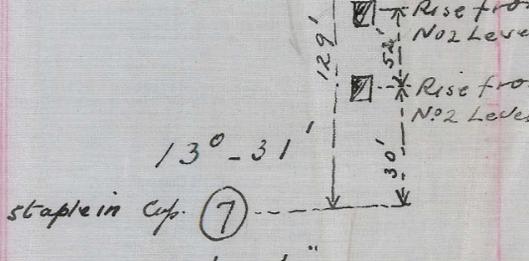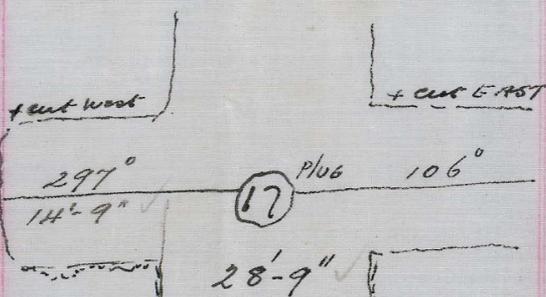


12°-06'  
8 in Main Drive North  
Branch Lode from 8

Face SW + Cut  
17'-6" RISE TO SURFACE  
199°-12'  
3 IN CAP  
87'-4"

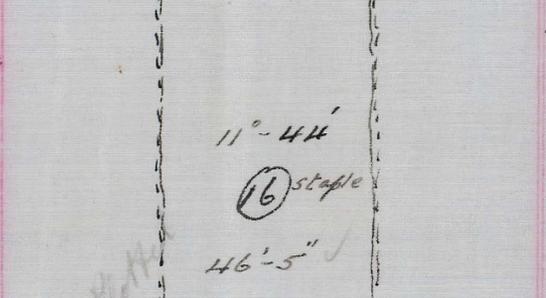


13°-31'  
staple in cap 7  
48'-3 1/2"  
0°-51'  
6 staple in cap

227°-24'  
2 Plug in Back.  
61 ft

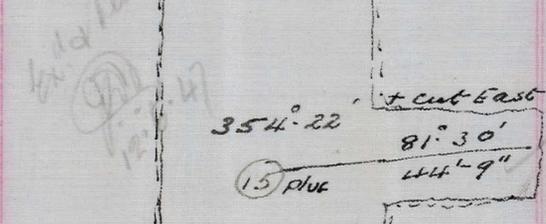

92'-7"  
2°-46'  
5 Staple in cap  
32'-4"


214°-35'  
1 staple in cap  
15'-1"

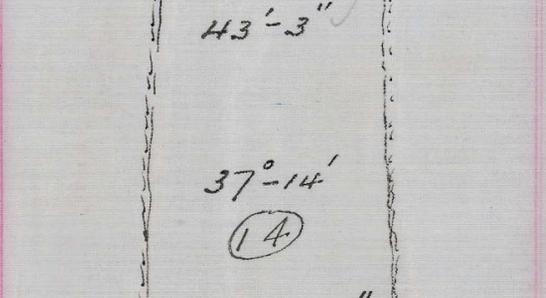

356°-19' + cut  
plug in roof 4  
97°  
20'  
8'-11"



228°-31'  
again from 5A

5A in Main North Drive  
S.W. Crosscut from


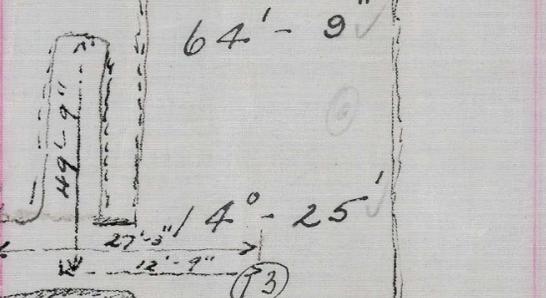


80°-18'  
3 Plug in roof  
66'

Face of + cut  
57 ft

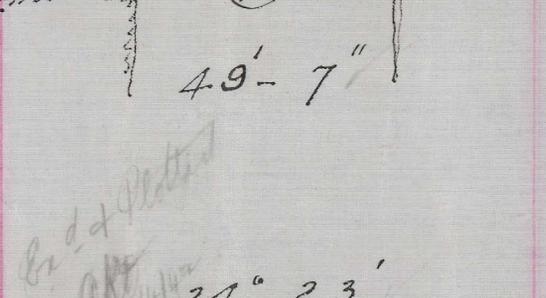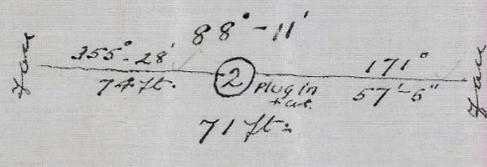


9°-31'  
2 staple in cap  
67'

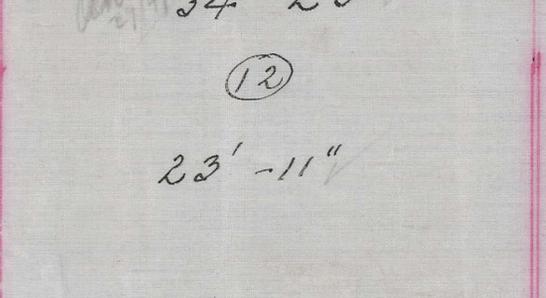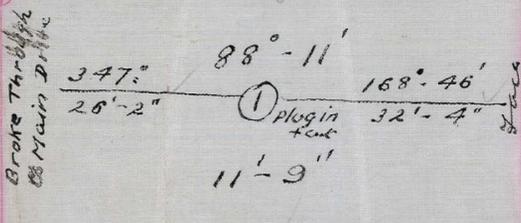

8°-10'  
1 staple in cap  
24'-11"

91°-06'  
5A staple in Lagging  
25'-5"

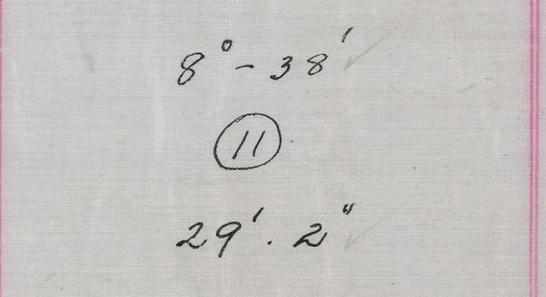

358°-06'  
2 Plug in roof  
from station Z  
No 1 Level - Going North

6°-16'  
5 North Drive  
Lode from 5 in Main  
No 1 Level - Branch

