

FARRELL MINING CO. LTD.

0061-036

No 6 Level South - Going SE from 7A, then NE on Lateral Lode

No.	Bearing	Course	Length	LATITUDE		DEPARTURE		PERPENDICULARS				
				North	South	East	West	North	South	East	West	
7A								437.60		355.64		
7A-1A	152°-05'	SE 27°-55'	35.21		31.11	16.48		406.49		372.12		
1A-2	67°-10'	NE 67°-10'	13.04	5.06				411.55		384.14		
2-3	33°-20'	NE 33°-20'	27.12	22.66				434.21		399.04		
3-Face	3°-20'	NE 3°-20'	55.00	54.91				489.12		402.24		
<u>Again from 2 to South Face</u>												
2								411.55		384.14		
2-Face	173°	SE 7°	19.25		19.10	2.35		392.45		386.49		
<u>Again from 2 to East X Cut</u>												
2								411.55		384.14		
2-Face	95°-40'	SE 84°-20'	19.50		1.93	19.40		409.62		403.54		
<u>Again from 2 to H/W Drive</u>												
2								411.55		384.14		
2-H/W	354°-40'	NW 5°-20'	36.00	35.84			3.35	447.39		380.79		
H/W Face			6 ft									

*Station 7A in Main Drive
" 1A in Plug
" 2 in Plug
" 3 in Sleeper
Face*


*Station 2
Face*

*Station 2
Face*


*Station 2
H/W
Face*

FARRELL MINING COMPANY LIMITED
R. M. Jackson General Manager
8/5/63


1917/51
1917/51
1917/51

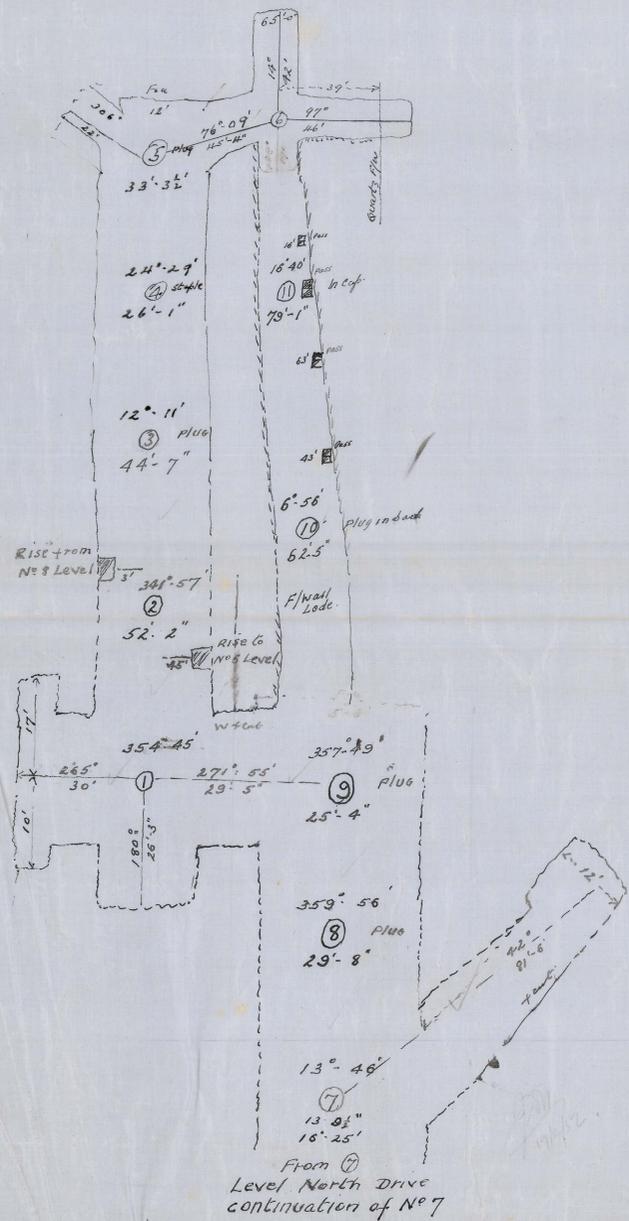


From ⑦ Level North Drive continuation of No 7

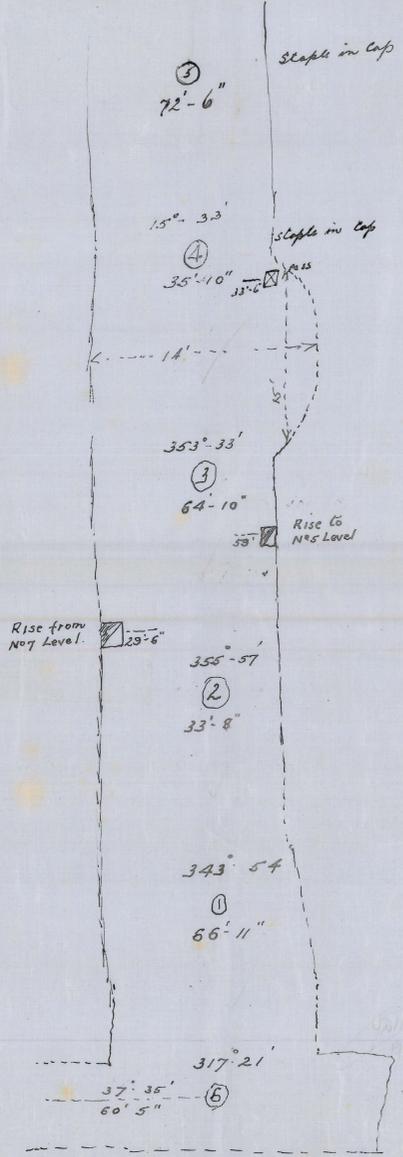


North Drive from ⑥ Continuation of No 6 Level

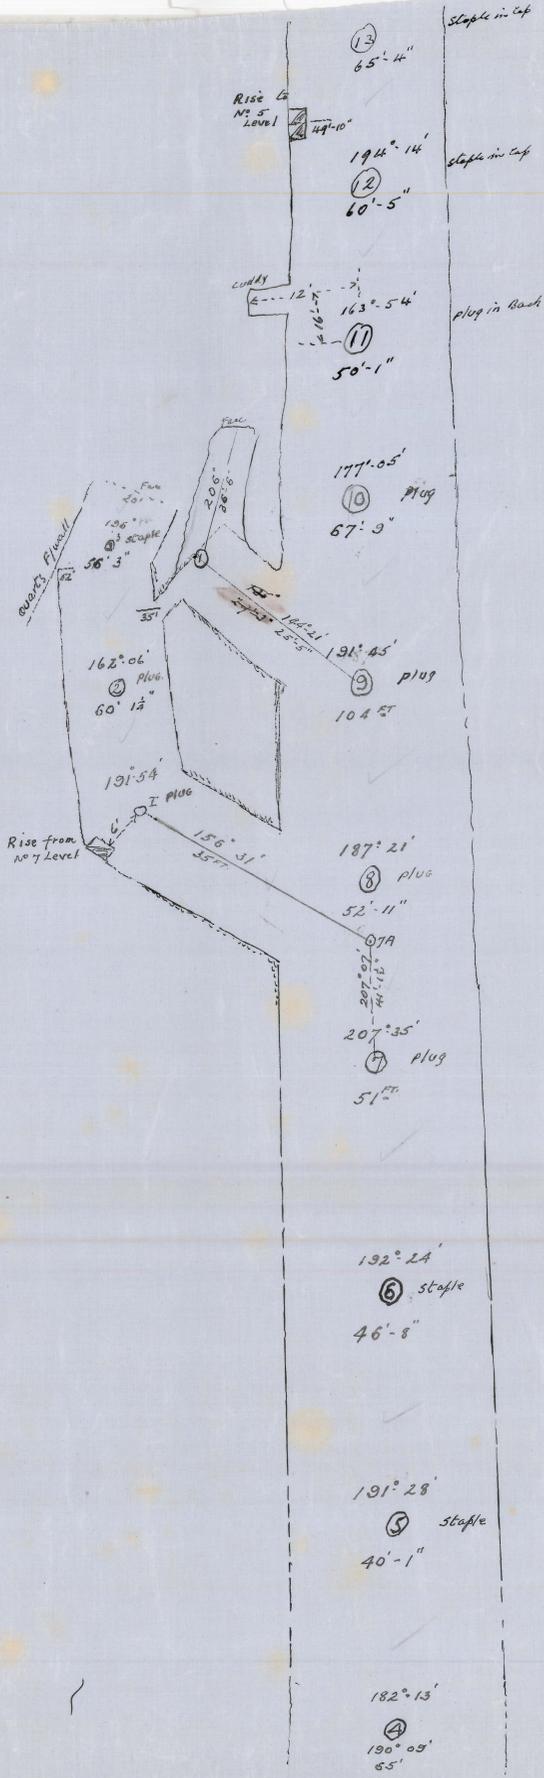

from ④ Level Going South Continuation of No 6

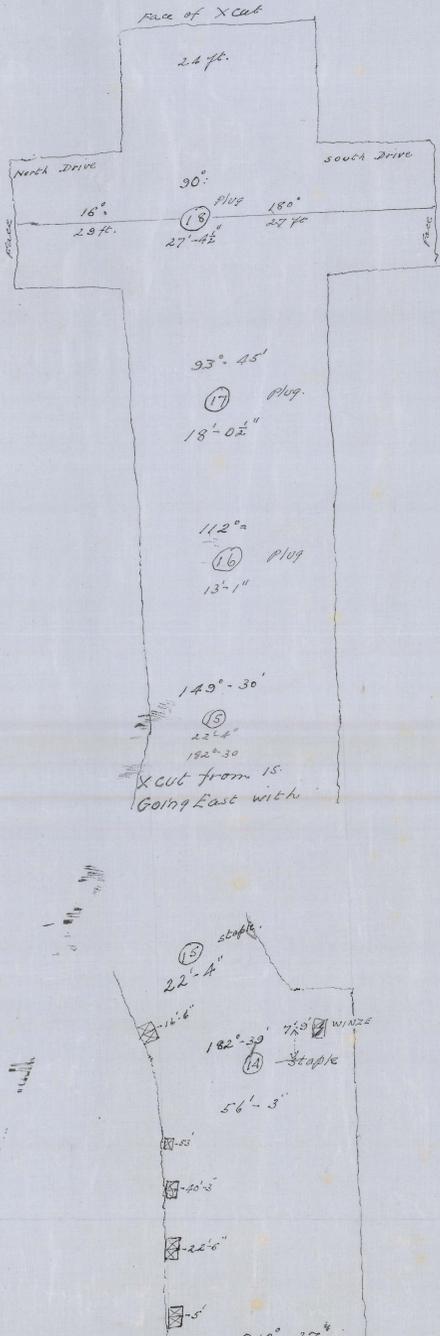

from ⑬ Level Going South Continuation of No 6

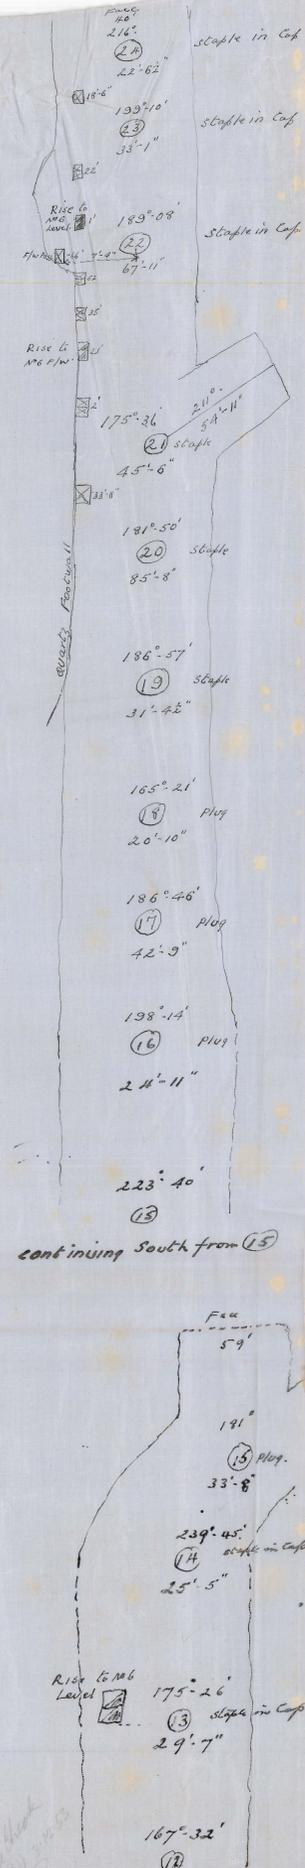

South from ⑩ Continuation of No 7 level

0061-036

FARRELL MINING CO. LTD.

No 7 Level North - Going North on F/Wall Lode from Stn 9 in Main Drive

No.	Bearing	Course	Length	LATITUDE		DEPARTURE		PERPENDICULARS				
				North	South	East	West	North	South	East	West	
9								1197.16		455.51		Station 9 plug in back
9-10	357°-49'	NW 2°-11'	62.42	62.37			2.38	1259.53		453.13		" 10 Plug in back
10-11	6°-56'	NE 6°-56'	79.08	78.50		9.55		1338.03		462.68		" 11 In Cap
11-Face	16°-40'	NE 16°-40'	65.00	62.27		18.64		1400.30		481.32		Face

No 7 Level South - Going South from Stn 11 then East to F/Wall Lode

11								466.82		315.71		Station 11
11-11A	172°-04'	SE 7°-56'	15.67		15.52	2.16		451.30		317.87		" 11A In Logging
11A-1	79°-48'	NE 79°-48'	42.71	7.56		42.03		458.86		359.90		" 1 In Logging

Now Going North from Stn 1 in Xcut on F/Wall Lode

1								458.86		359.90		Station 1 in Xcut
1-2	352°-45'	NW 7°-15'	44.92	44.56			5.67	503.42		354.23		" 2 in Cap
2-Face	352°-45'	NW 7°-15'	5.50	5.46			0.69	508.88		353.54		Face

Now Going South from Stn 1 in Xcut on F/Wall Lode

1								458.86		359.90		Station 1 in Xcut
1-2	178°-36'	SE 1°-24'	17.83		17.82	0.44		441.04		360.34		" 2 in Cap
2-Face	216°	SW 36°	11.00		8.90		6.47	432.14		353.87		Face

FARRELL MINING COMPANY LIMITED
 General Manager
 R. D. [Signature]
 5/15/63

Face
11 FT

216°
② In Cap.
17'-10"

178°-36'
①

Again from ① going South

Face
5'-6"
② In Cap.
44'-11"

24'

352°-45'
①

Now going North from ①


① In Lagging
42'-8 1/2"

79°-48'
①A In Lagging
15'-7"

172°-04'
①①
190°
30'-11"

To F/W Lode
DRIVE to ①A then East
Again from ①① in Main
N°7 Level South

5 cm
0061-036

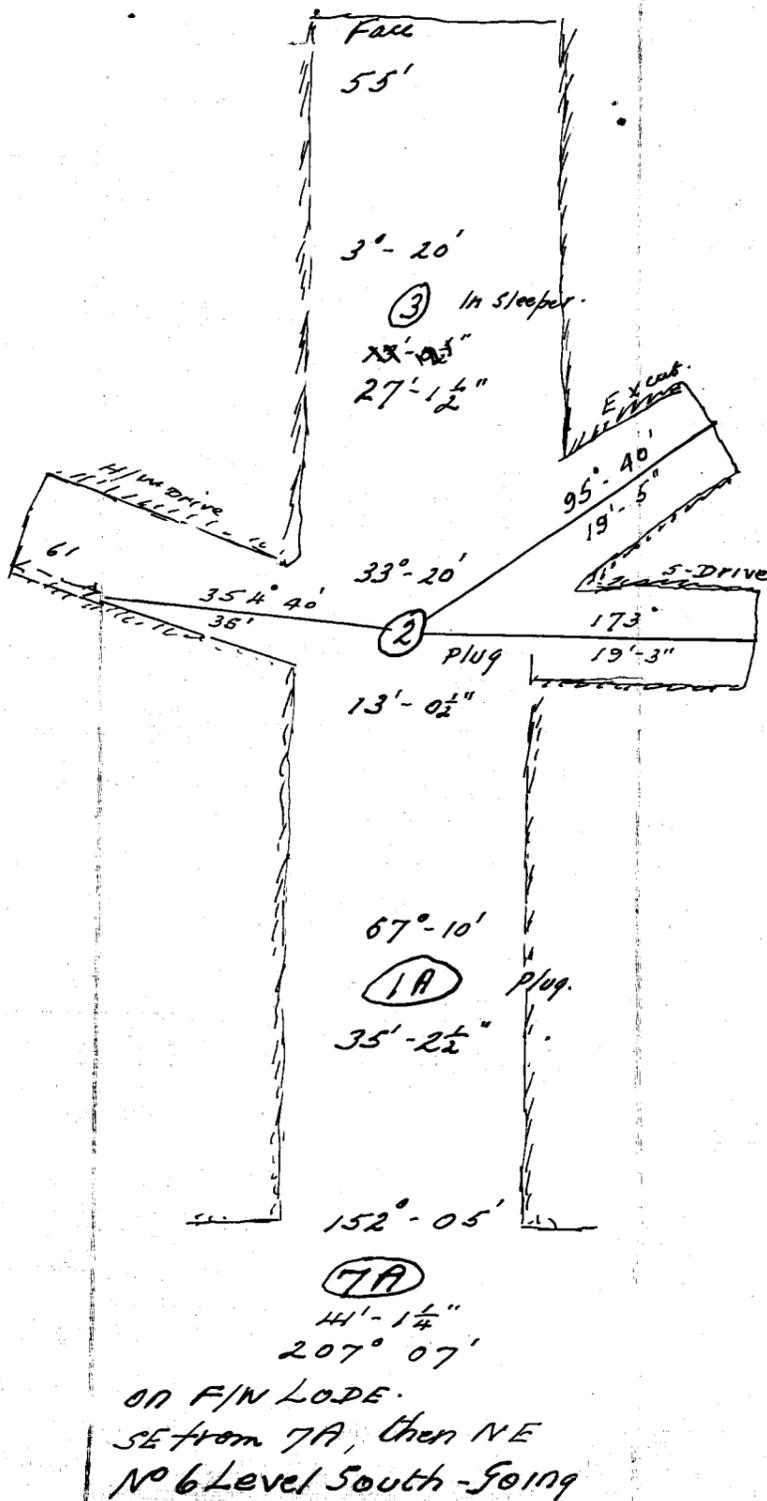

8/5/63

FARRELL MINING COMPANY LIMITED
FARRELL MINING COMPANY LIMITED