


0061_048


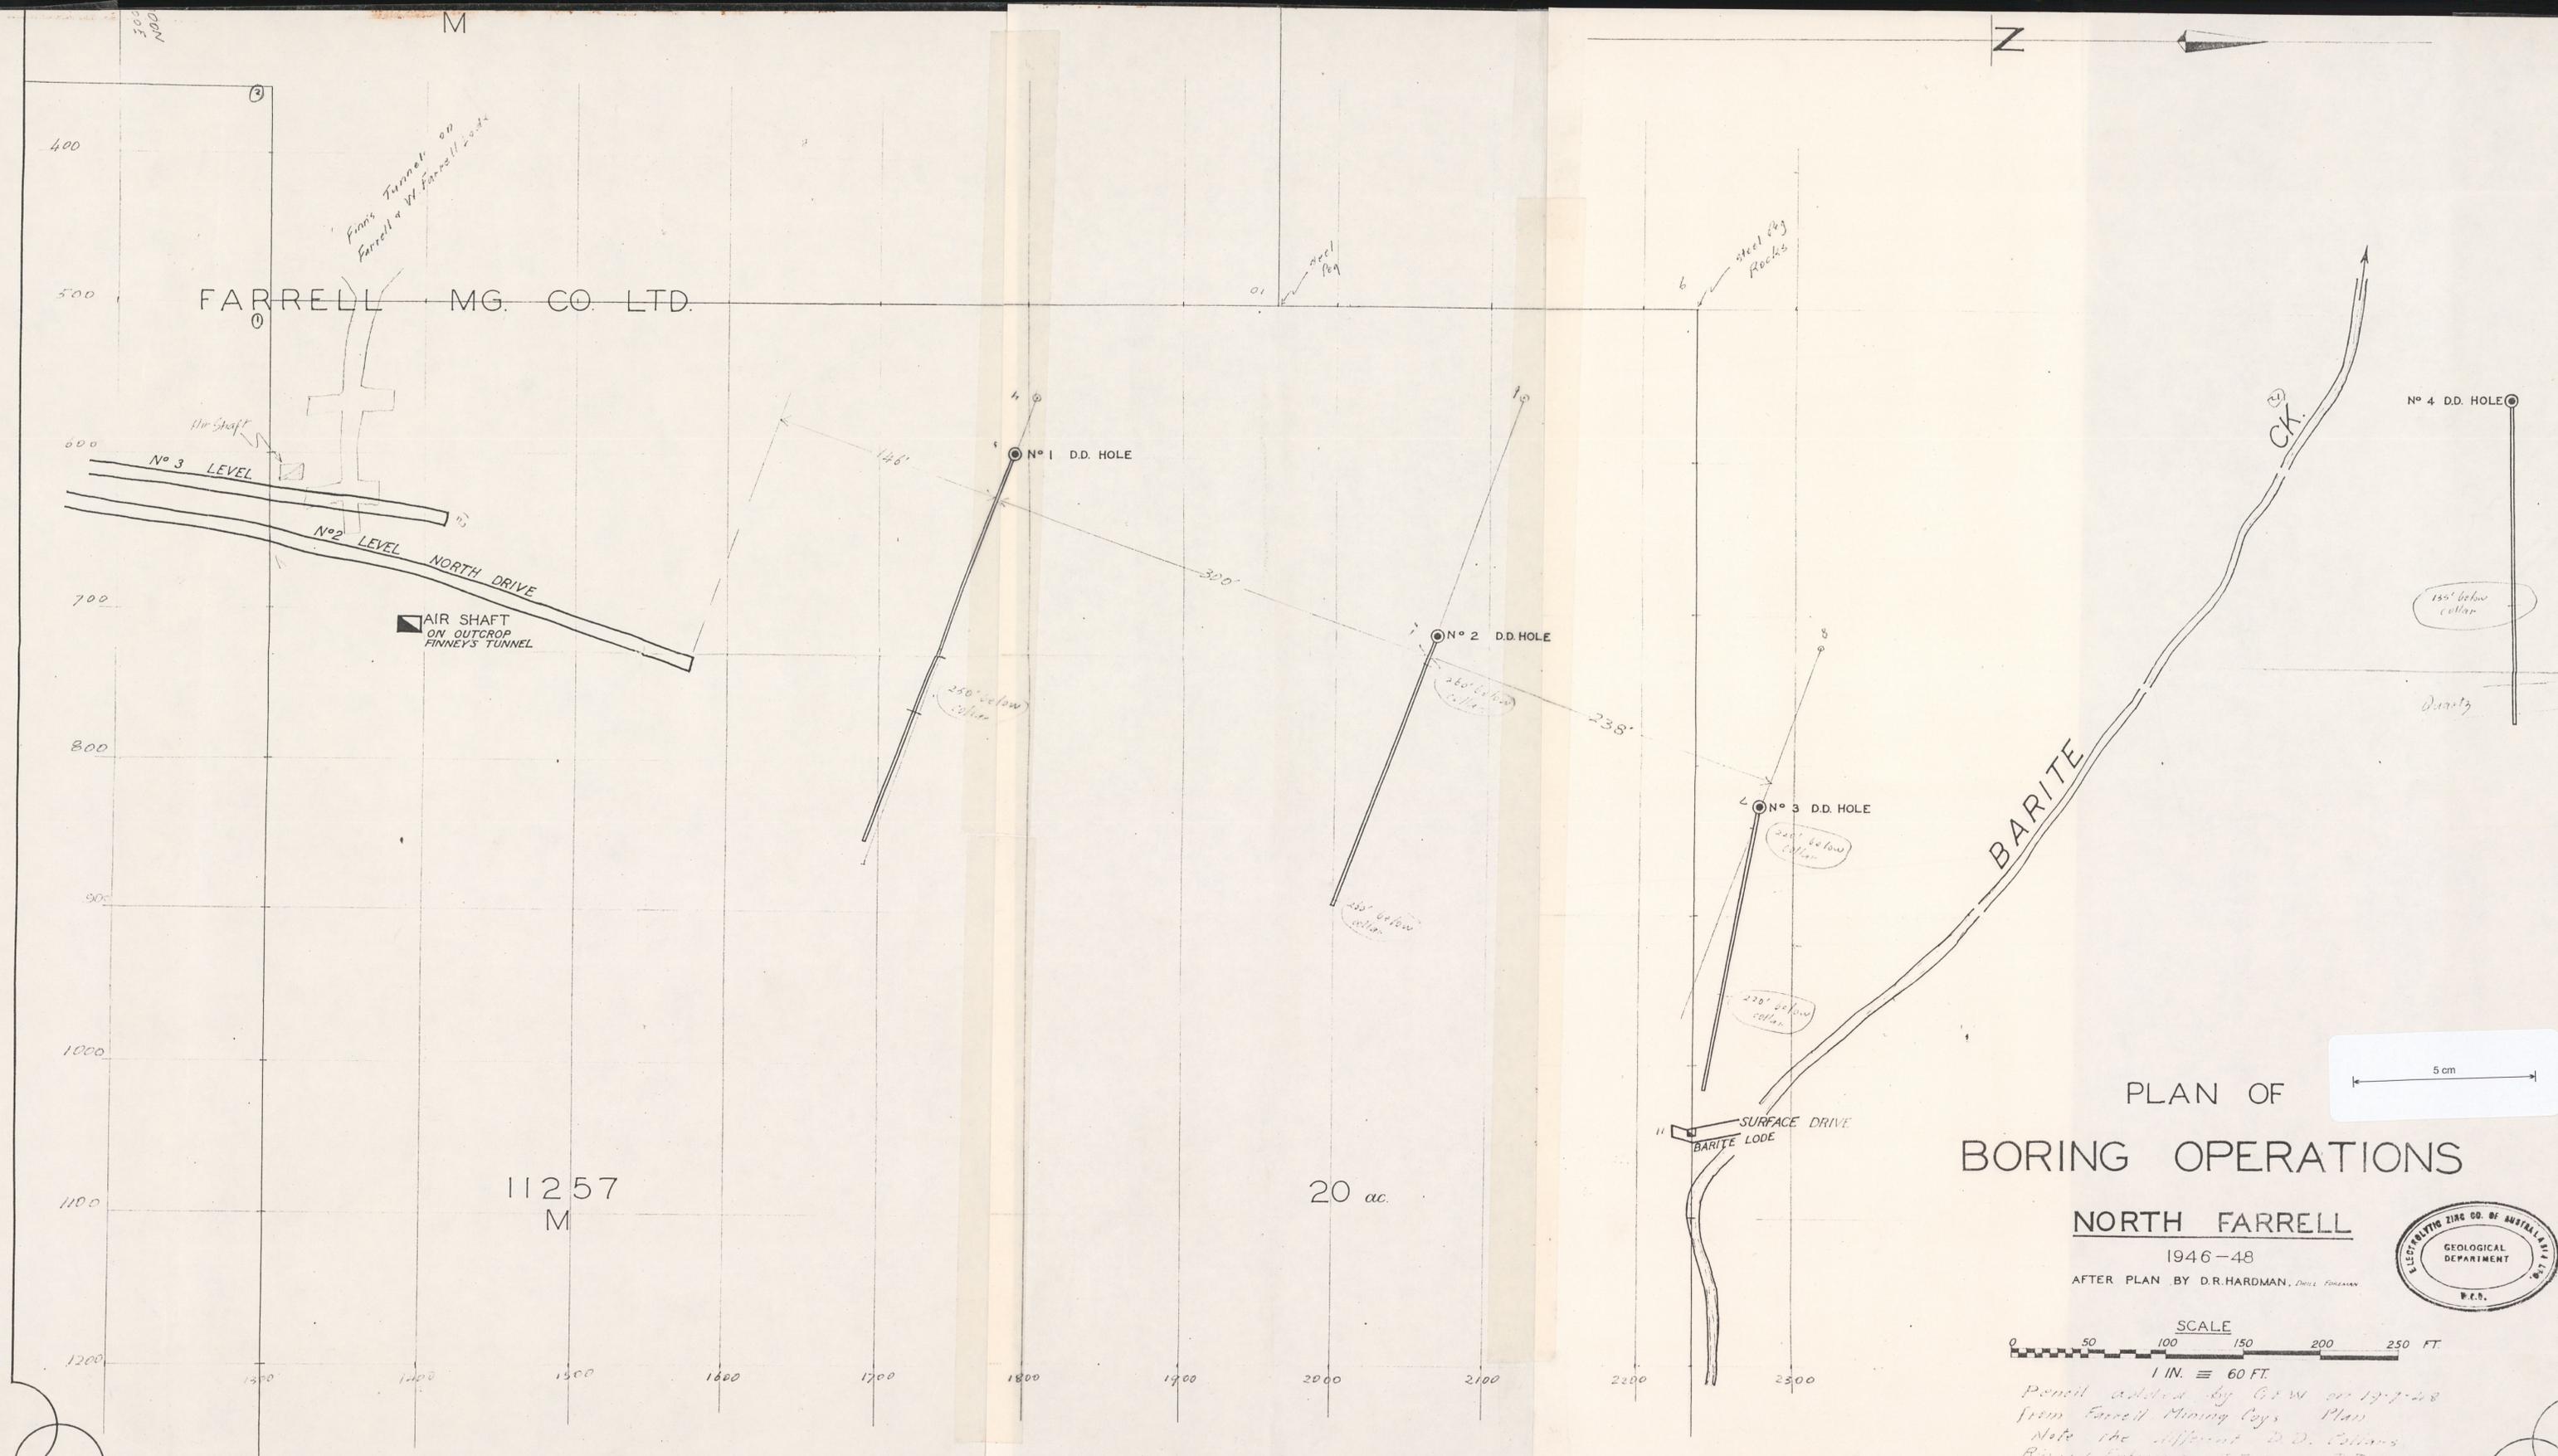


PLAN OF
BORING OPERATIONS

NORTH FARRELL

1946-48

AFTER PLAN BY D.R. HARDMAN, DEPT. GEOL.

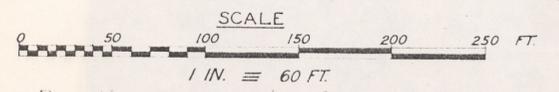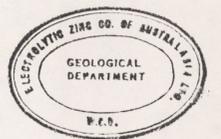

Pencil added by G.W. on 12-1-48
from Farrell Mining Coys. Plan
Note the different D.D. Collars
Ringed Entries by G.W. from D.D. Records
Channel intersected on #3 level being 8.7' (48) R.K.

File P. Murchison 5

1048-44