


0061_053

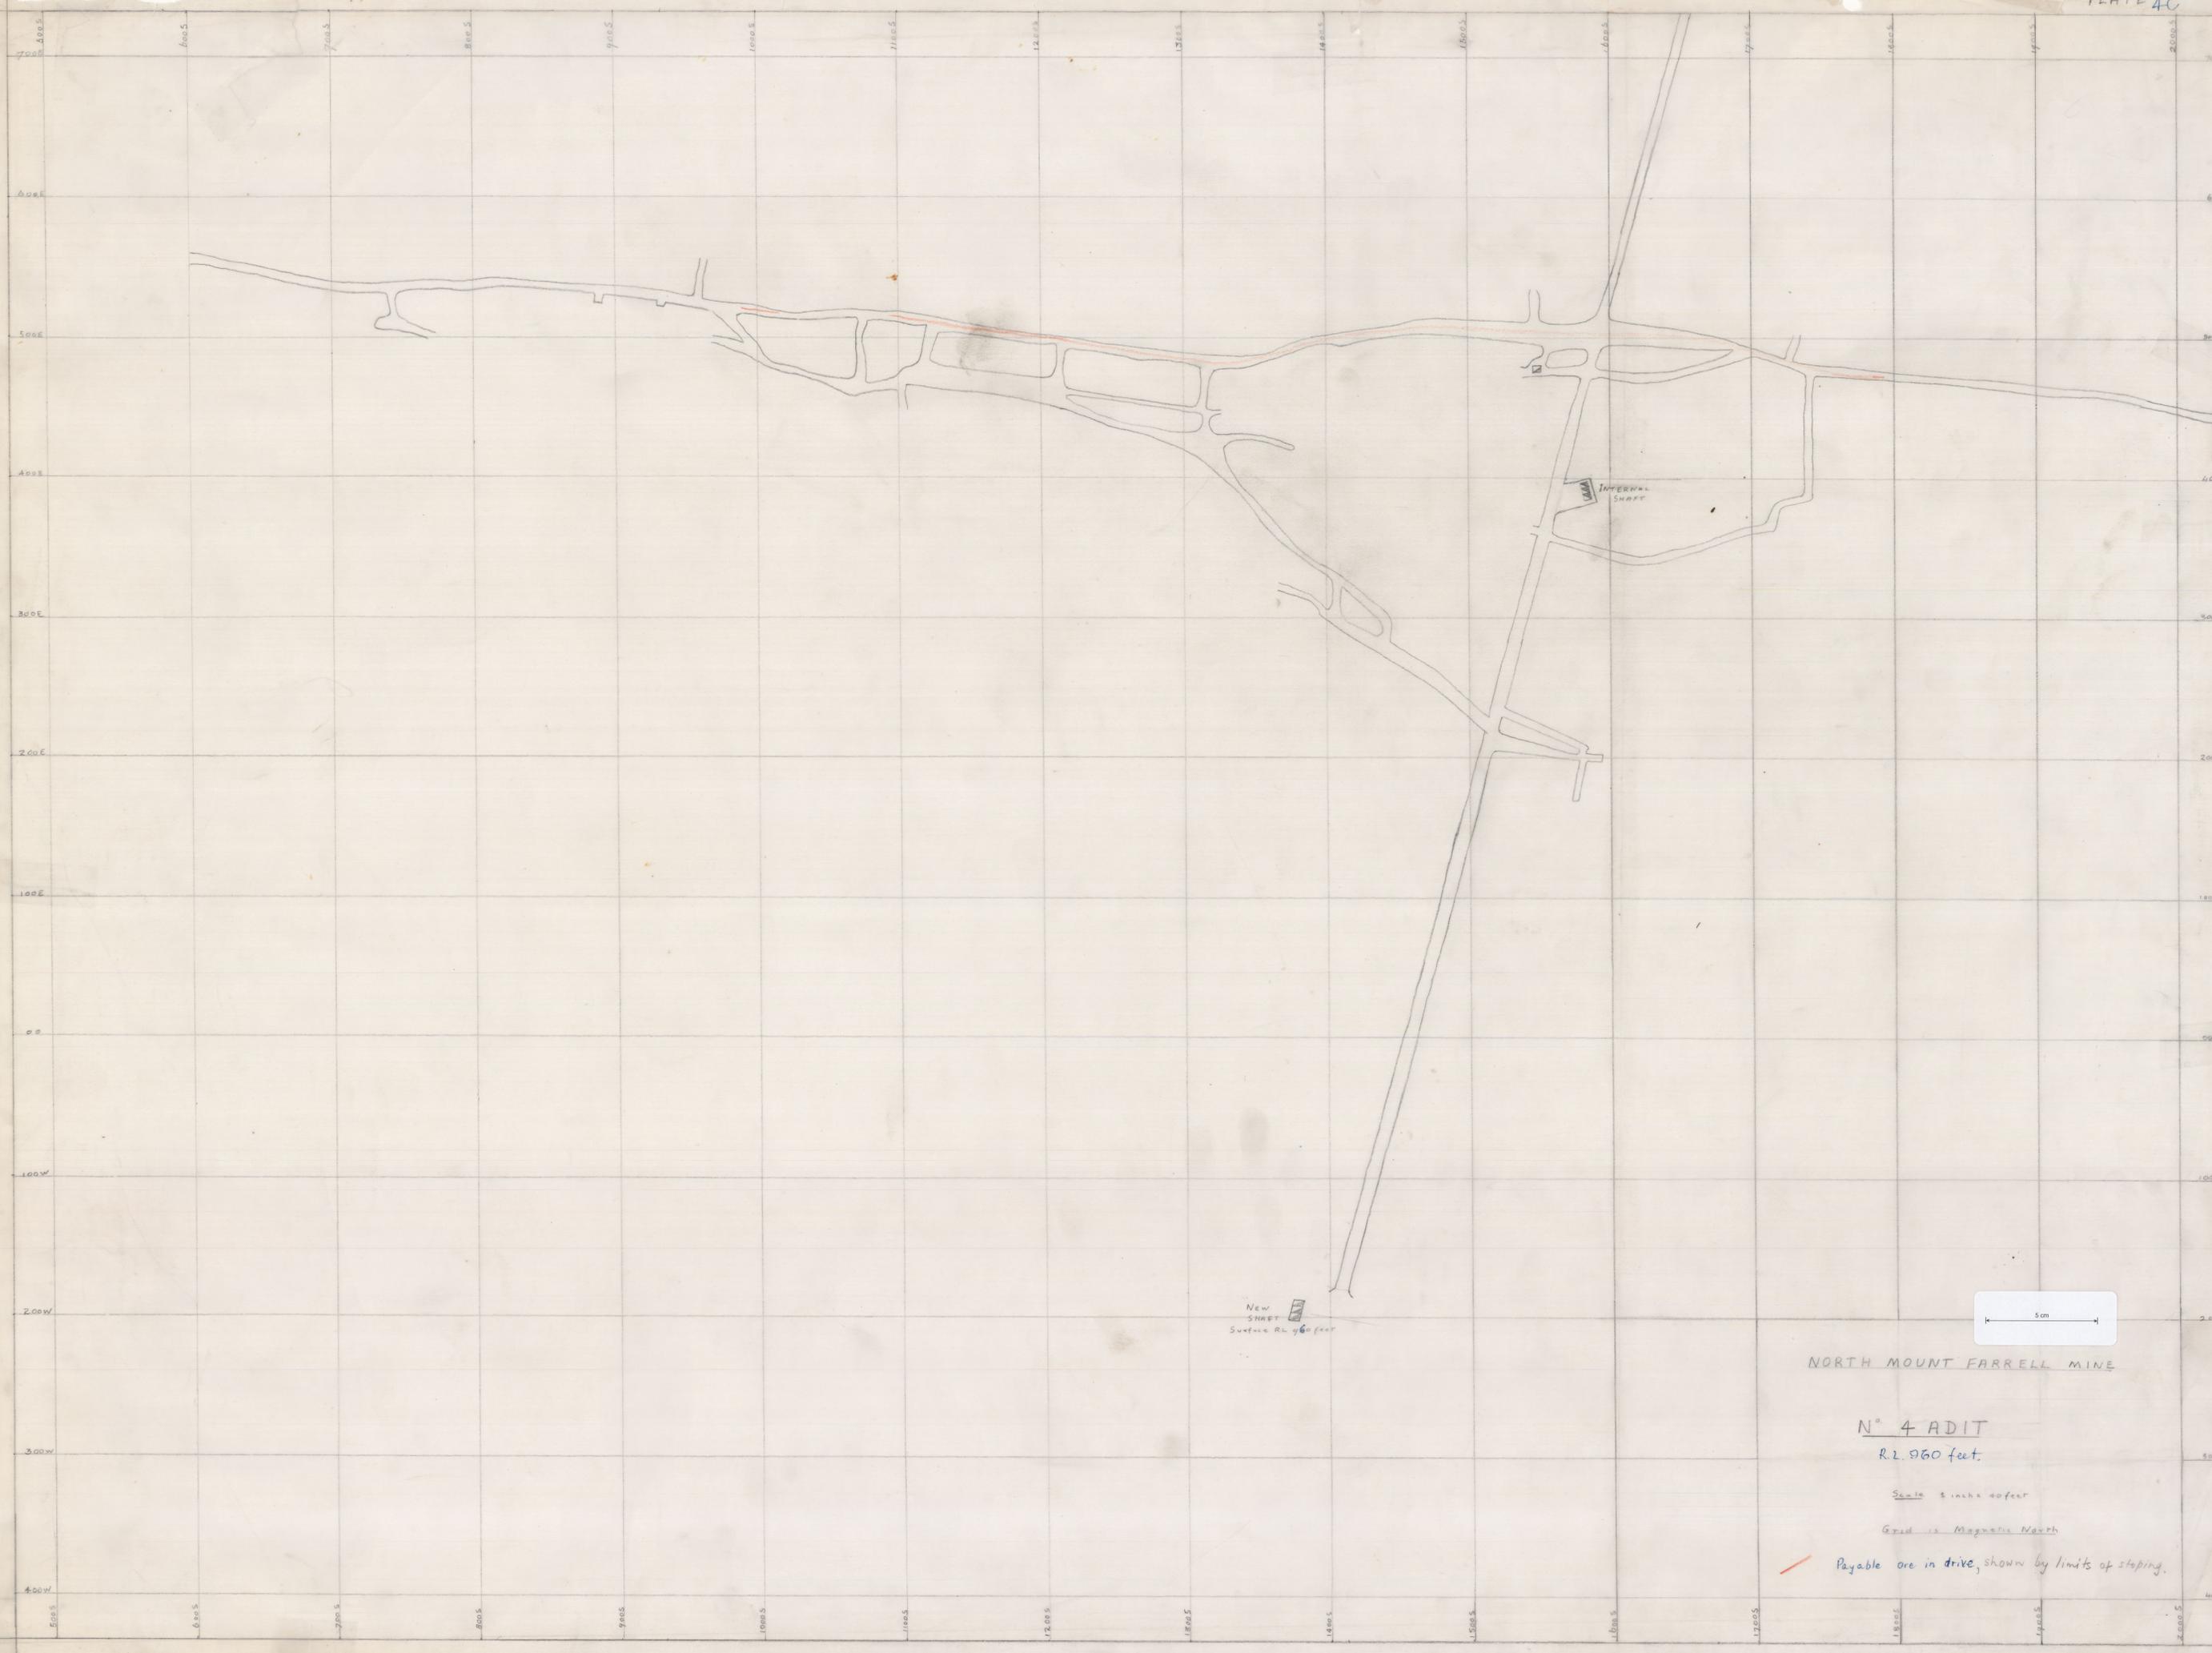

NORTH MOUNT FARRELL MINE

N° 4 ADIT
R.L. 960 feet.

Scale 1 inch = 40 feet
Grid is Magnetic North

Payable ore in drive, shown by limits of stoping.