


0061_059A



Flw x-cut Fanell
S end of 9 level?
10 "
(J.O.D. - 1979)

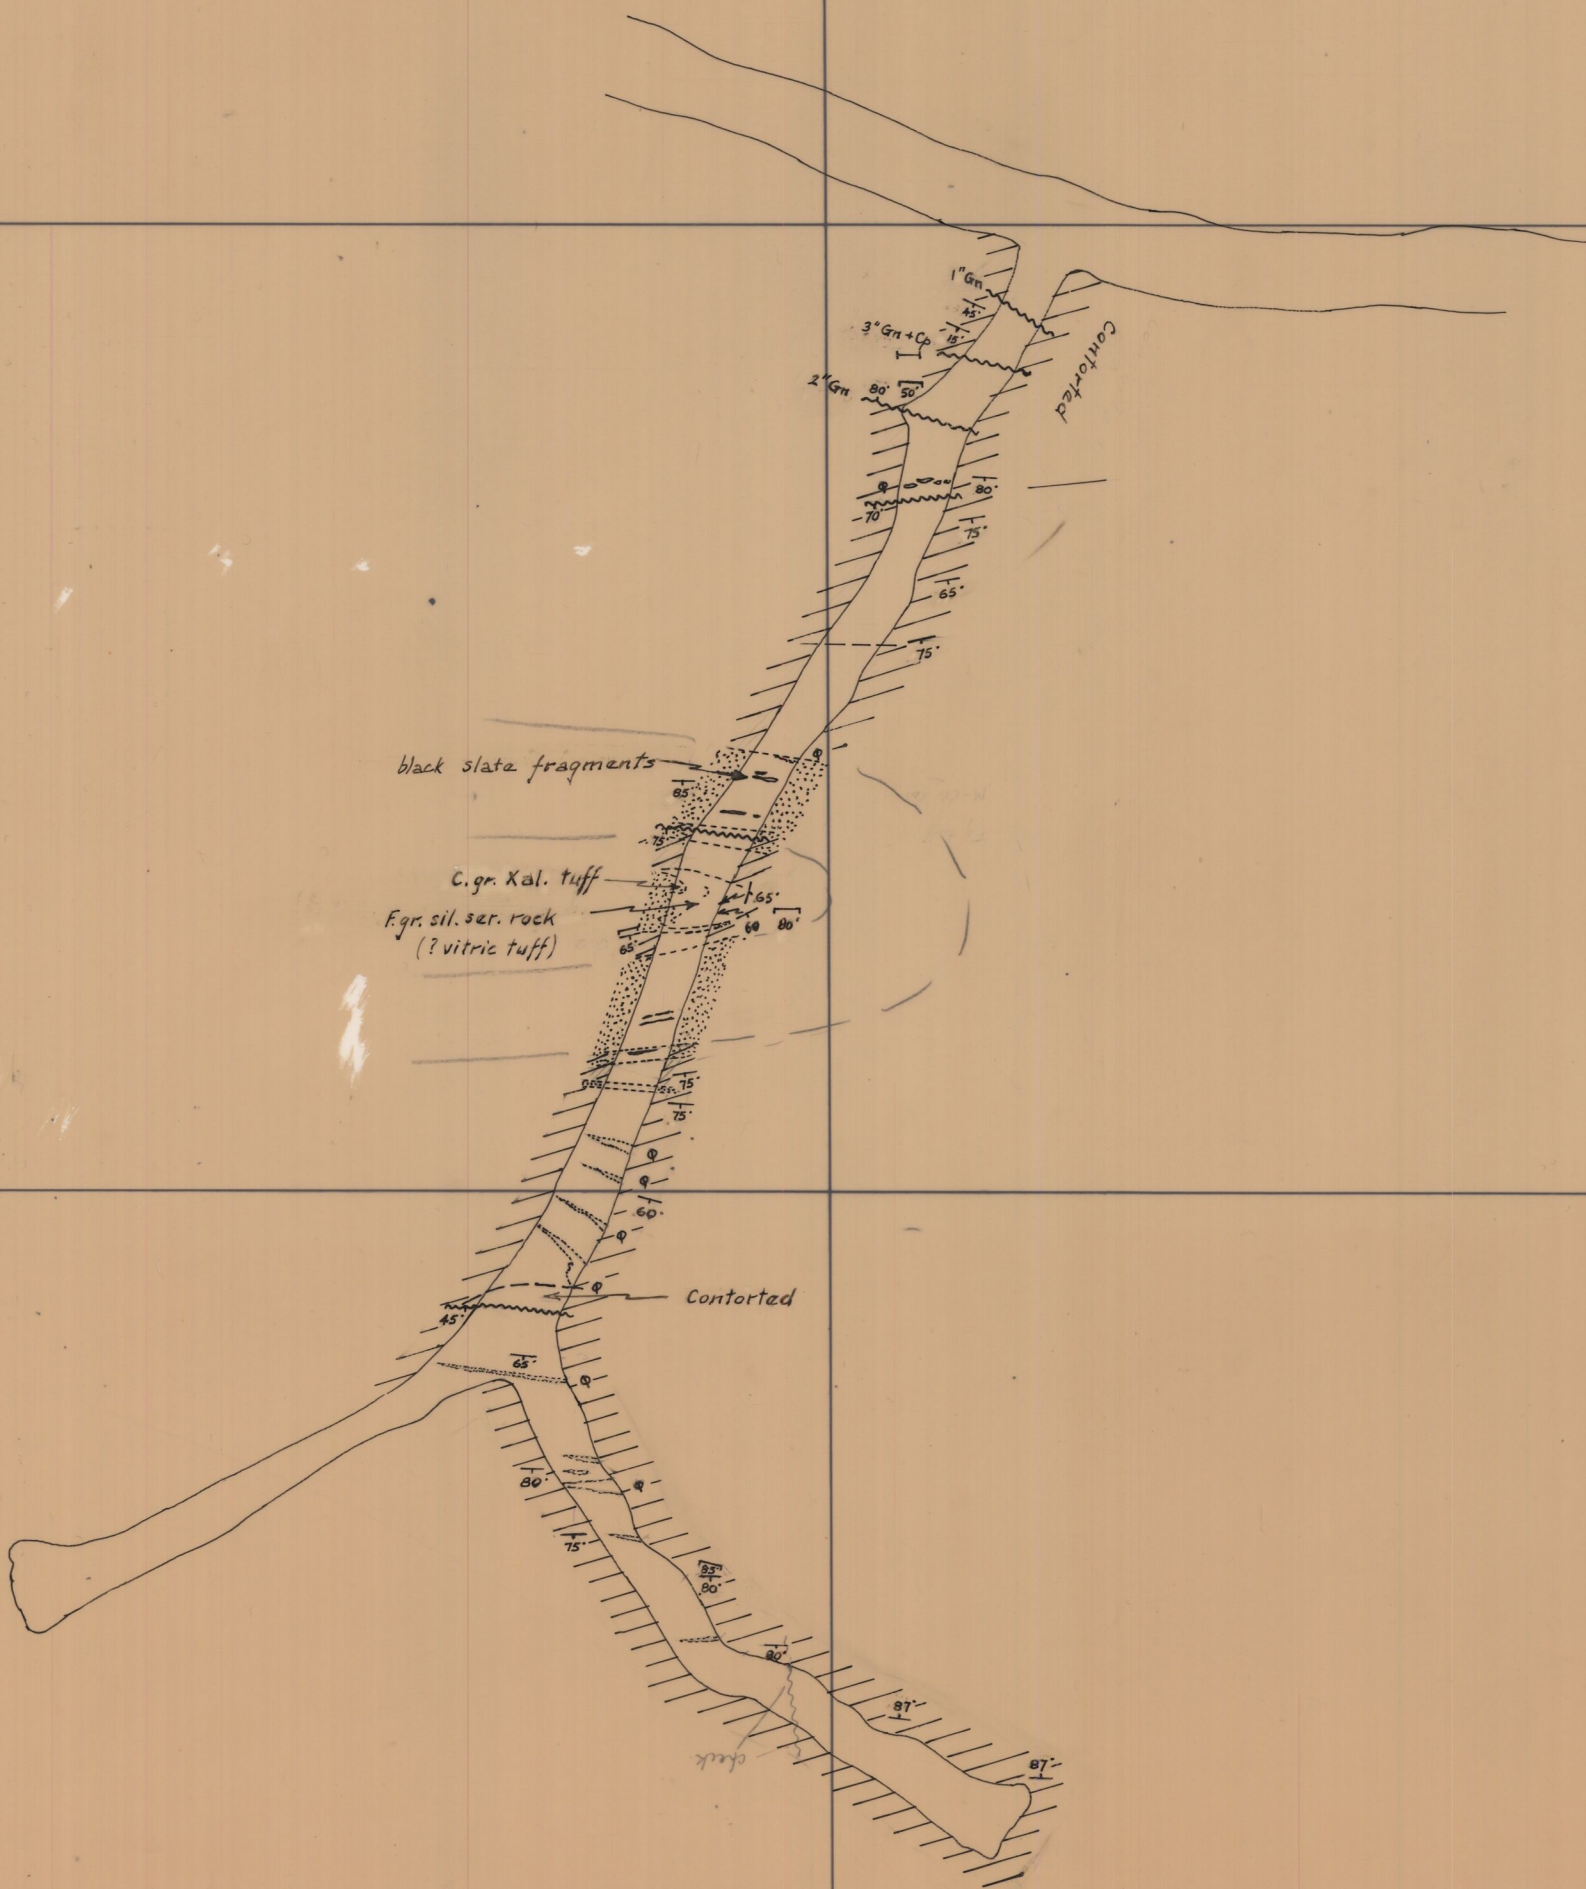