


0061_059D

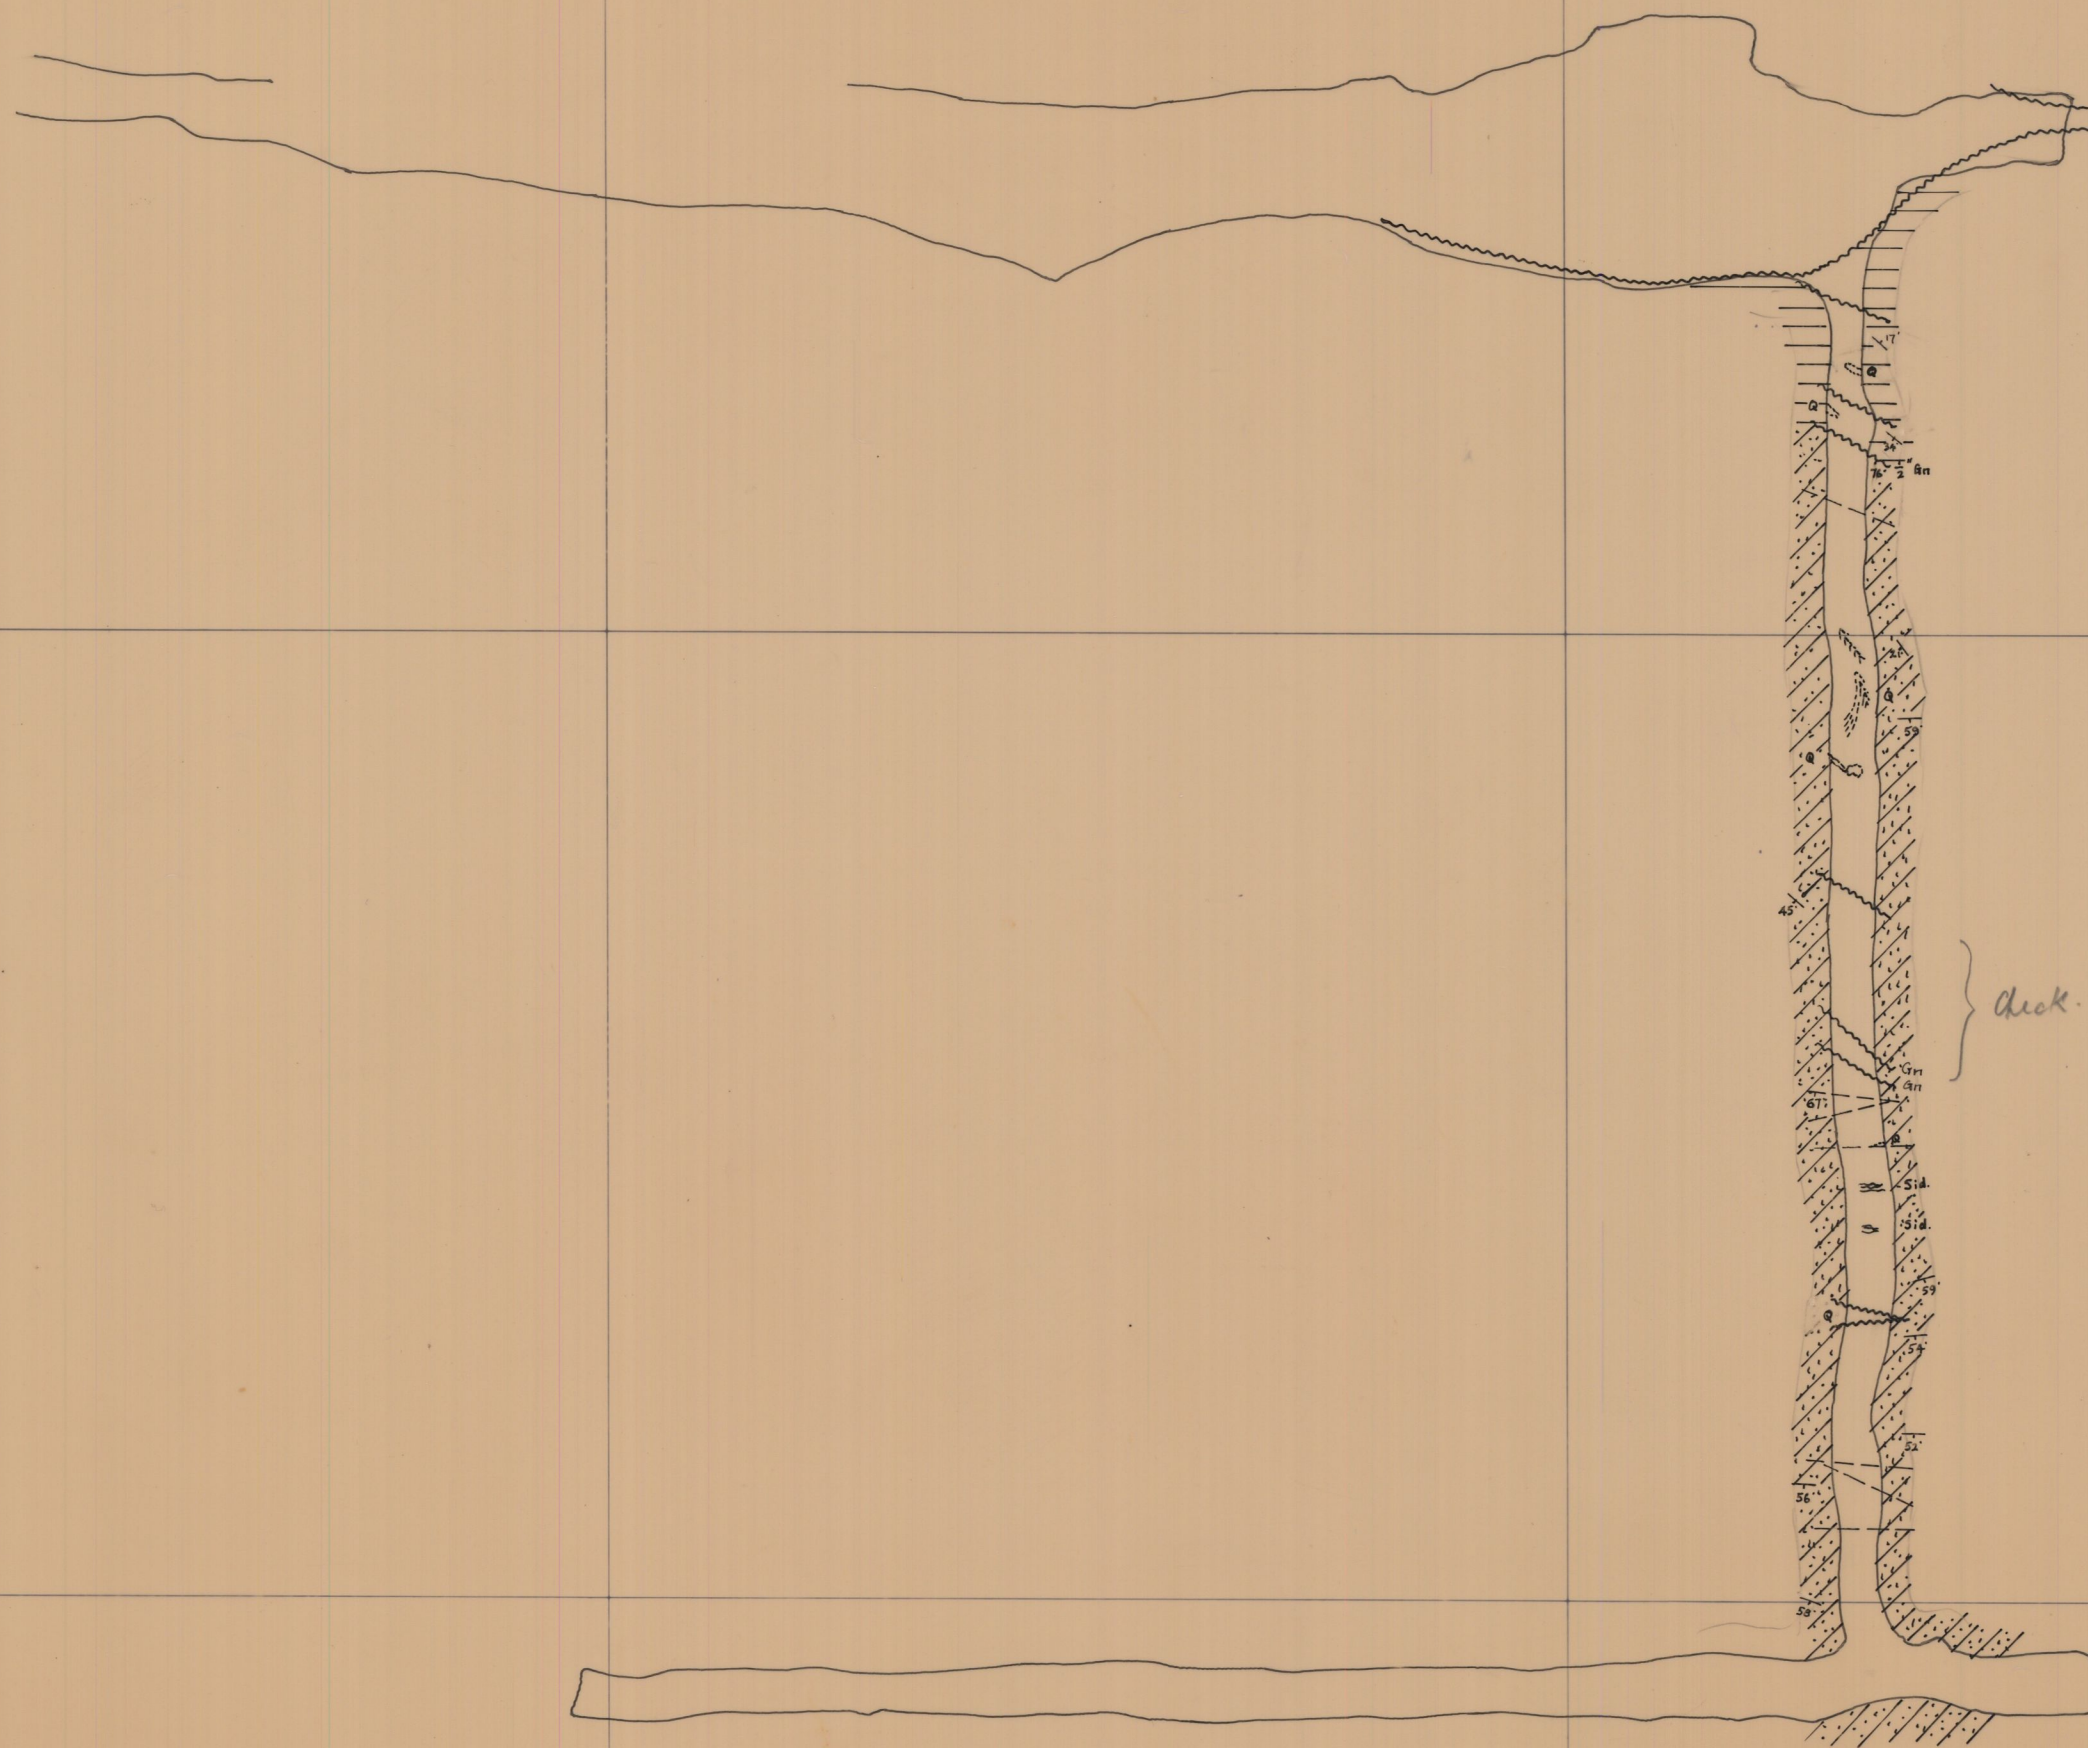

9 level
Farnell.
(1967-1979)

5 cm