



0061\_070

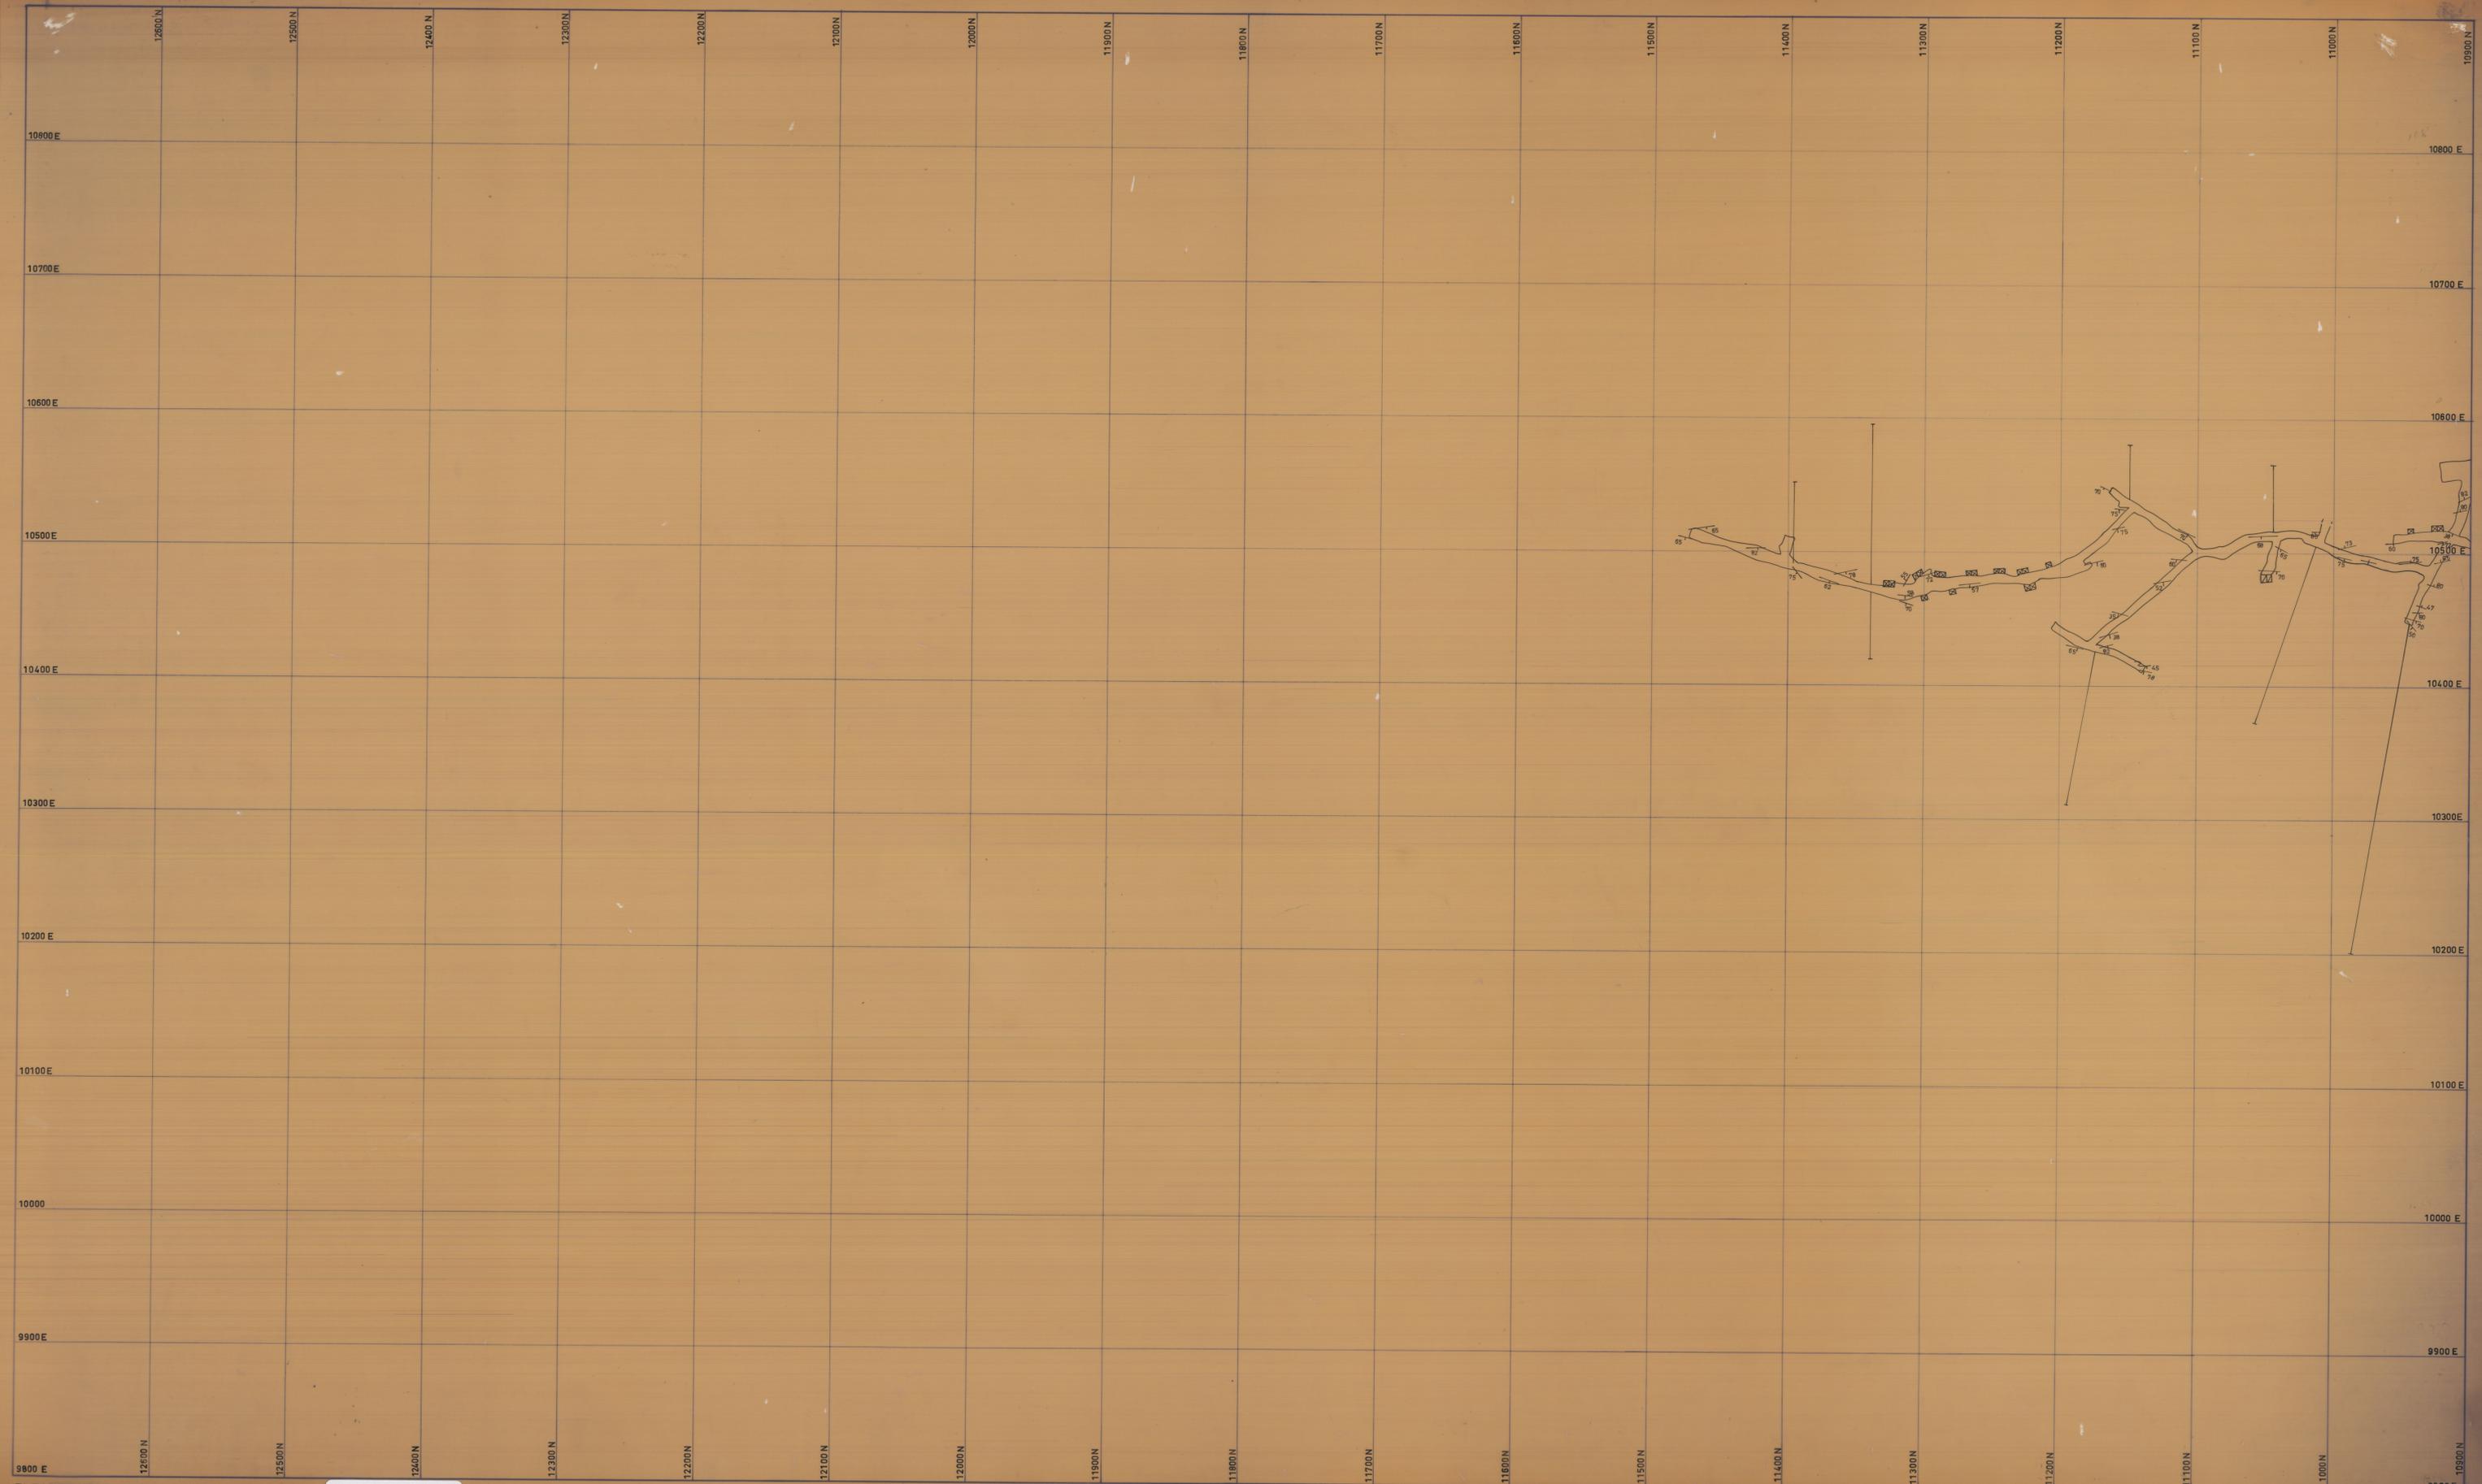

ELECTROLYTIC ZINC COMPANY OF A'ASIA  
 Geological Department.

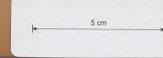

6 LEVEL  
 NORTH END

SCALE 1" = 40'

NEW NORTH MT. FARRELL MINE  
 6 LEVEL  
 10900 N — 12700 N