



0061_072

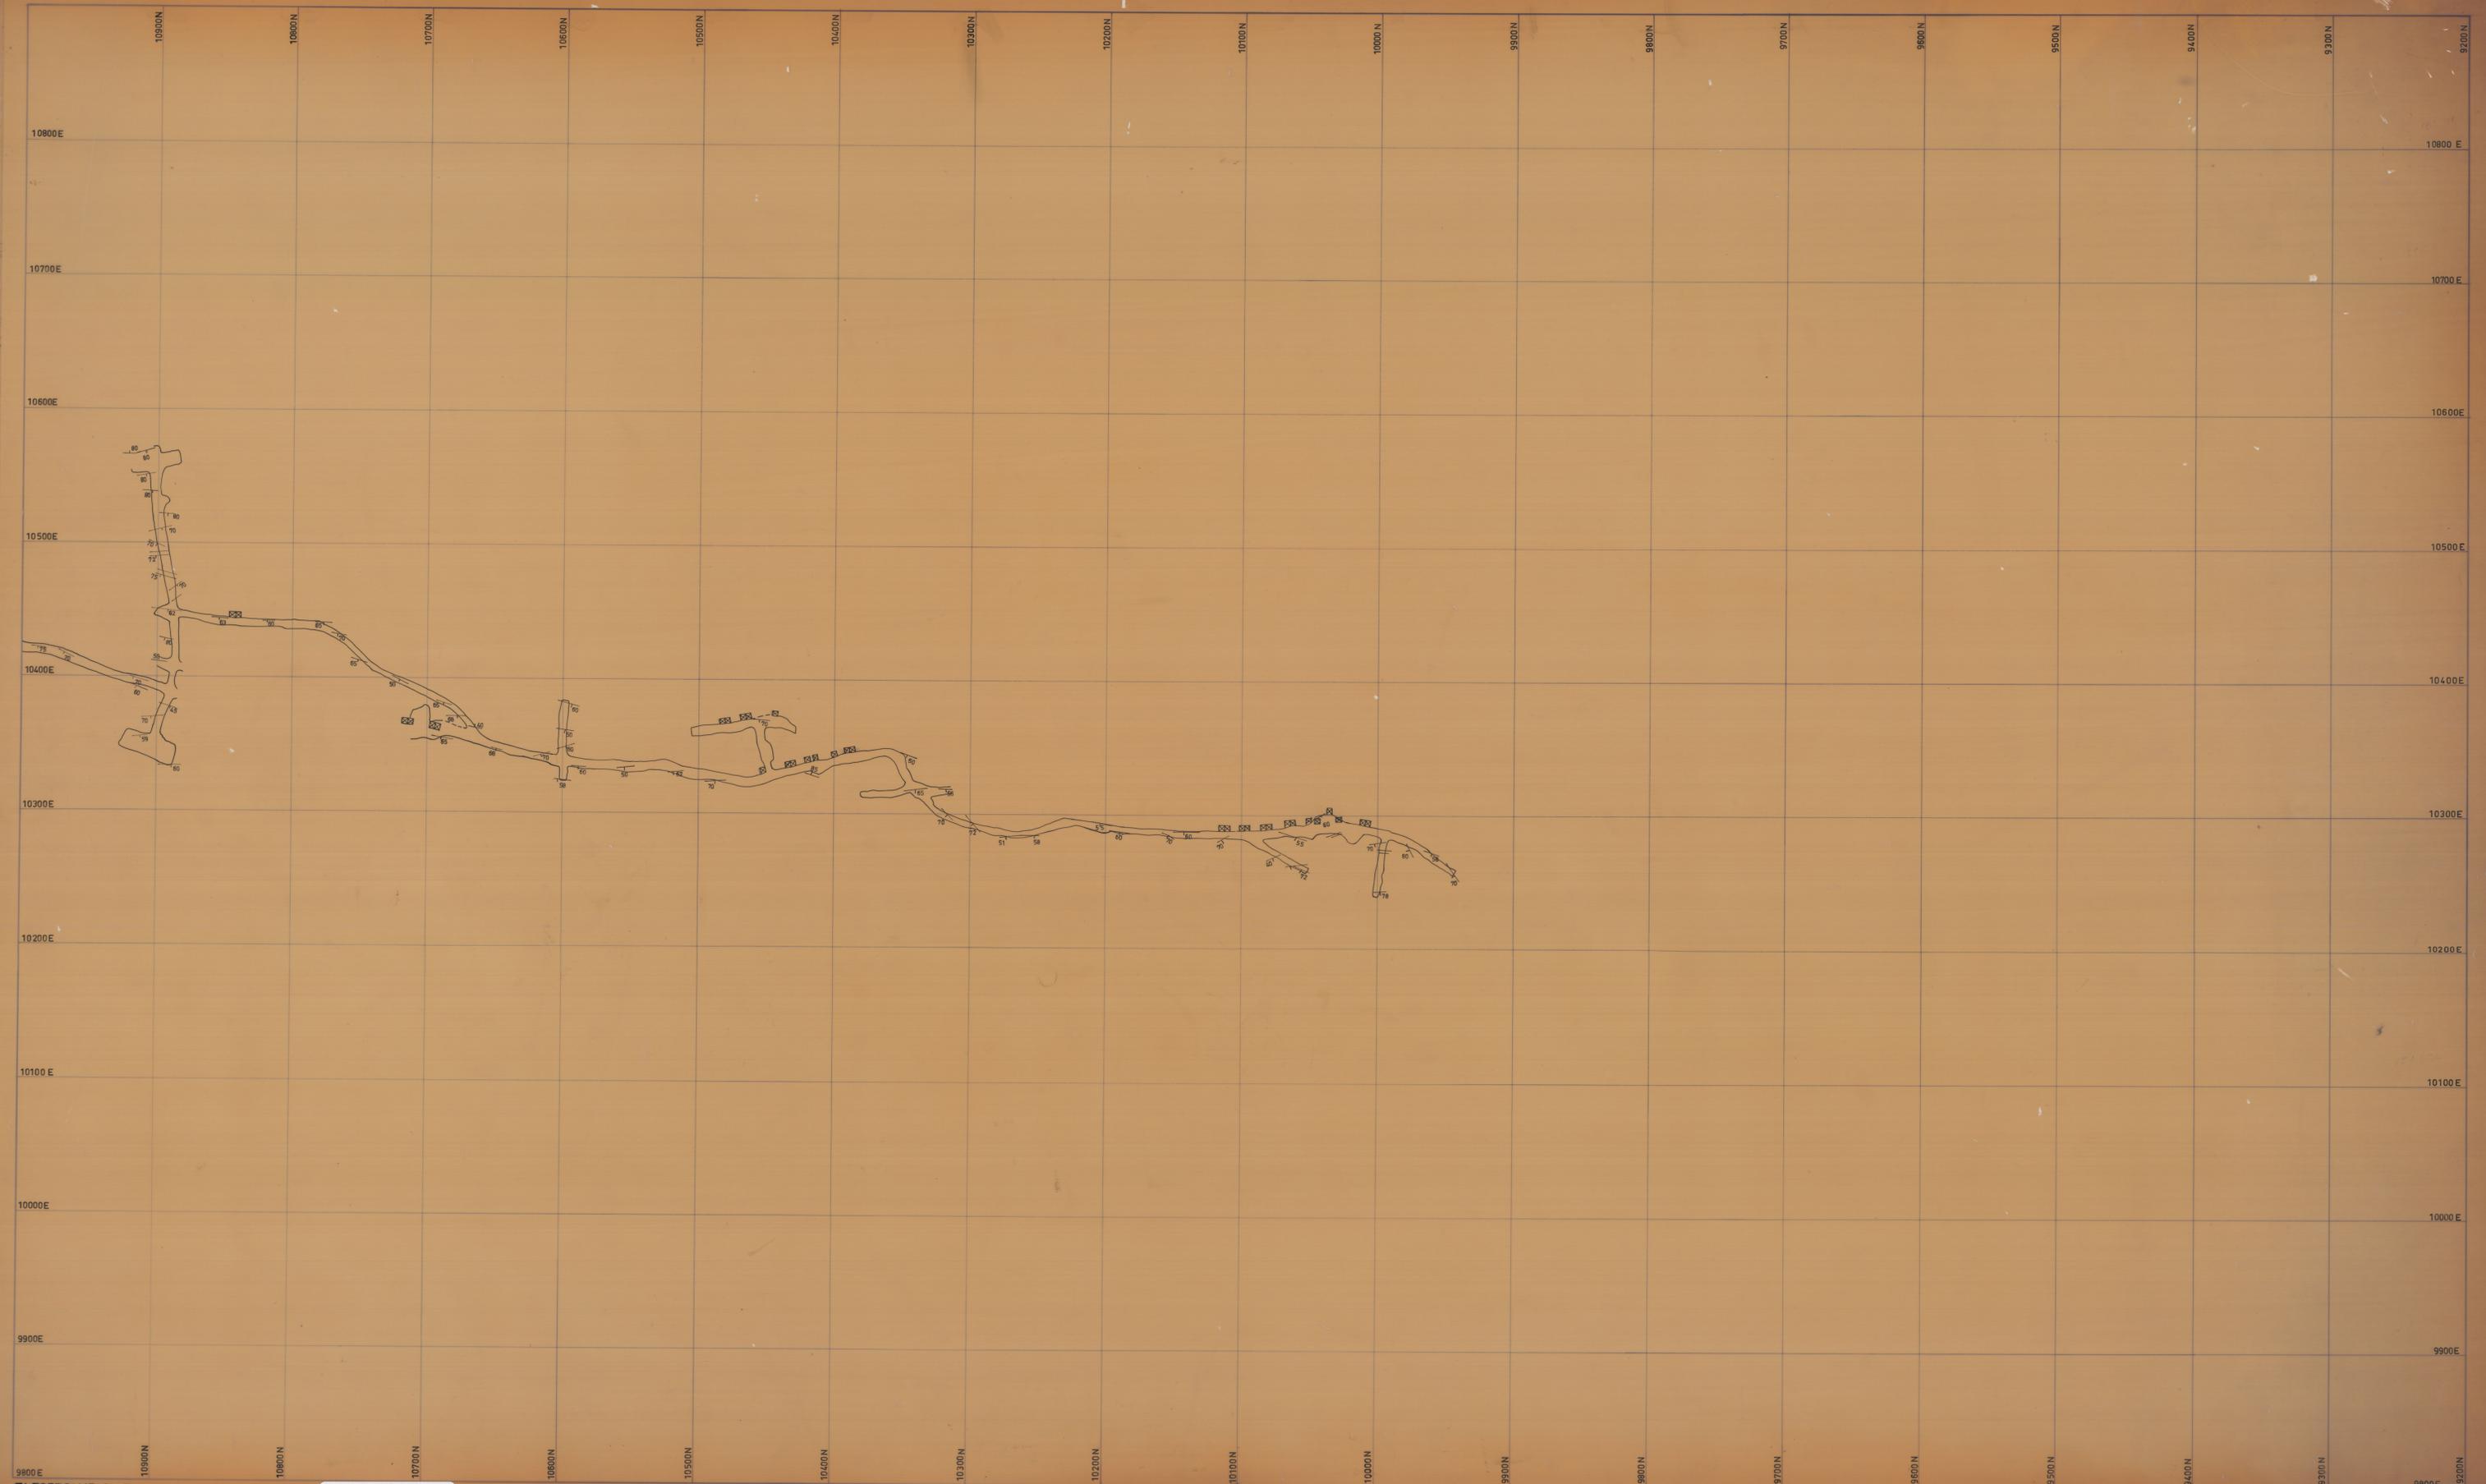

ELECTROLYTIC ZINC COMPANY OF ASIA
 Geological Department

Date: _____ Copy for: _____

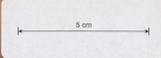

7 LEVEL
 NORTH END

SCALE 1" = 40'

NEW NORTH MT. FARRELL MINE
 7 LEVEL.

9200N — 11000N.