



0061_073

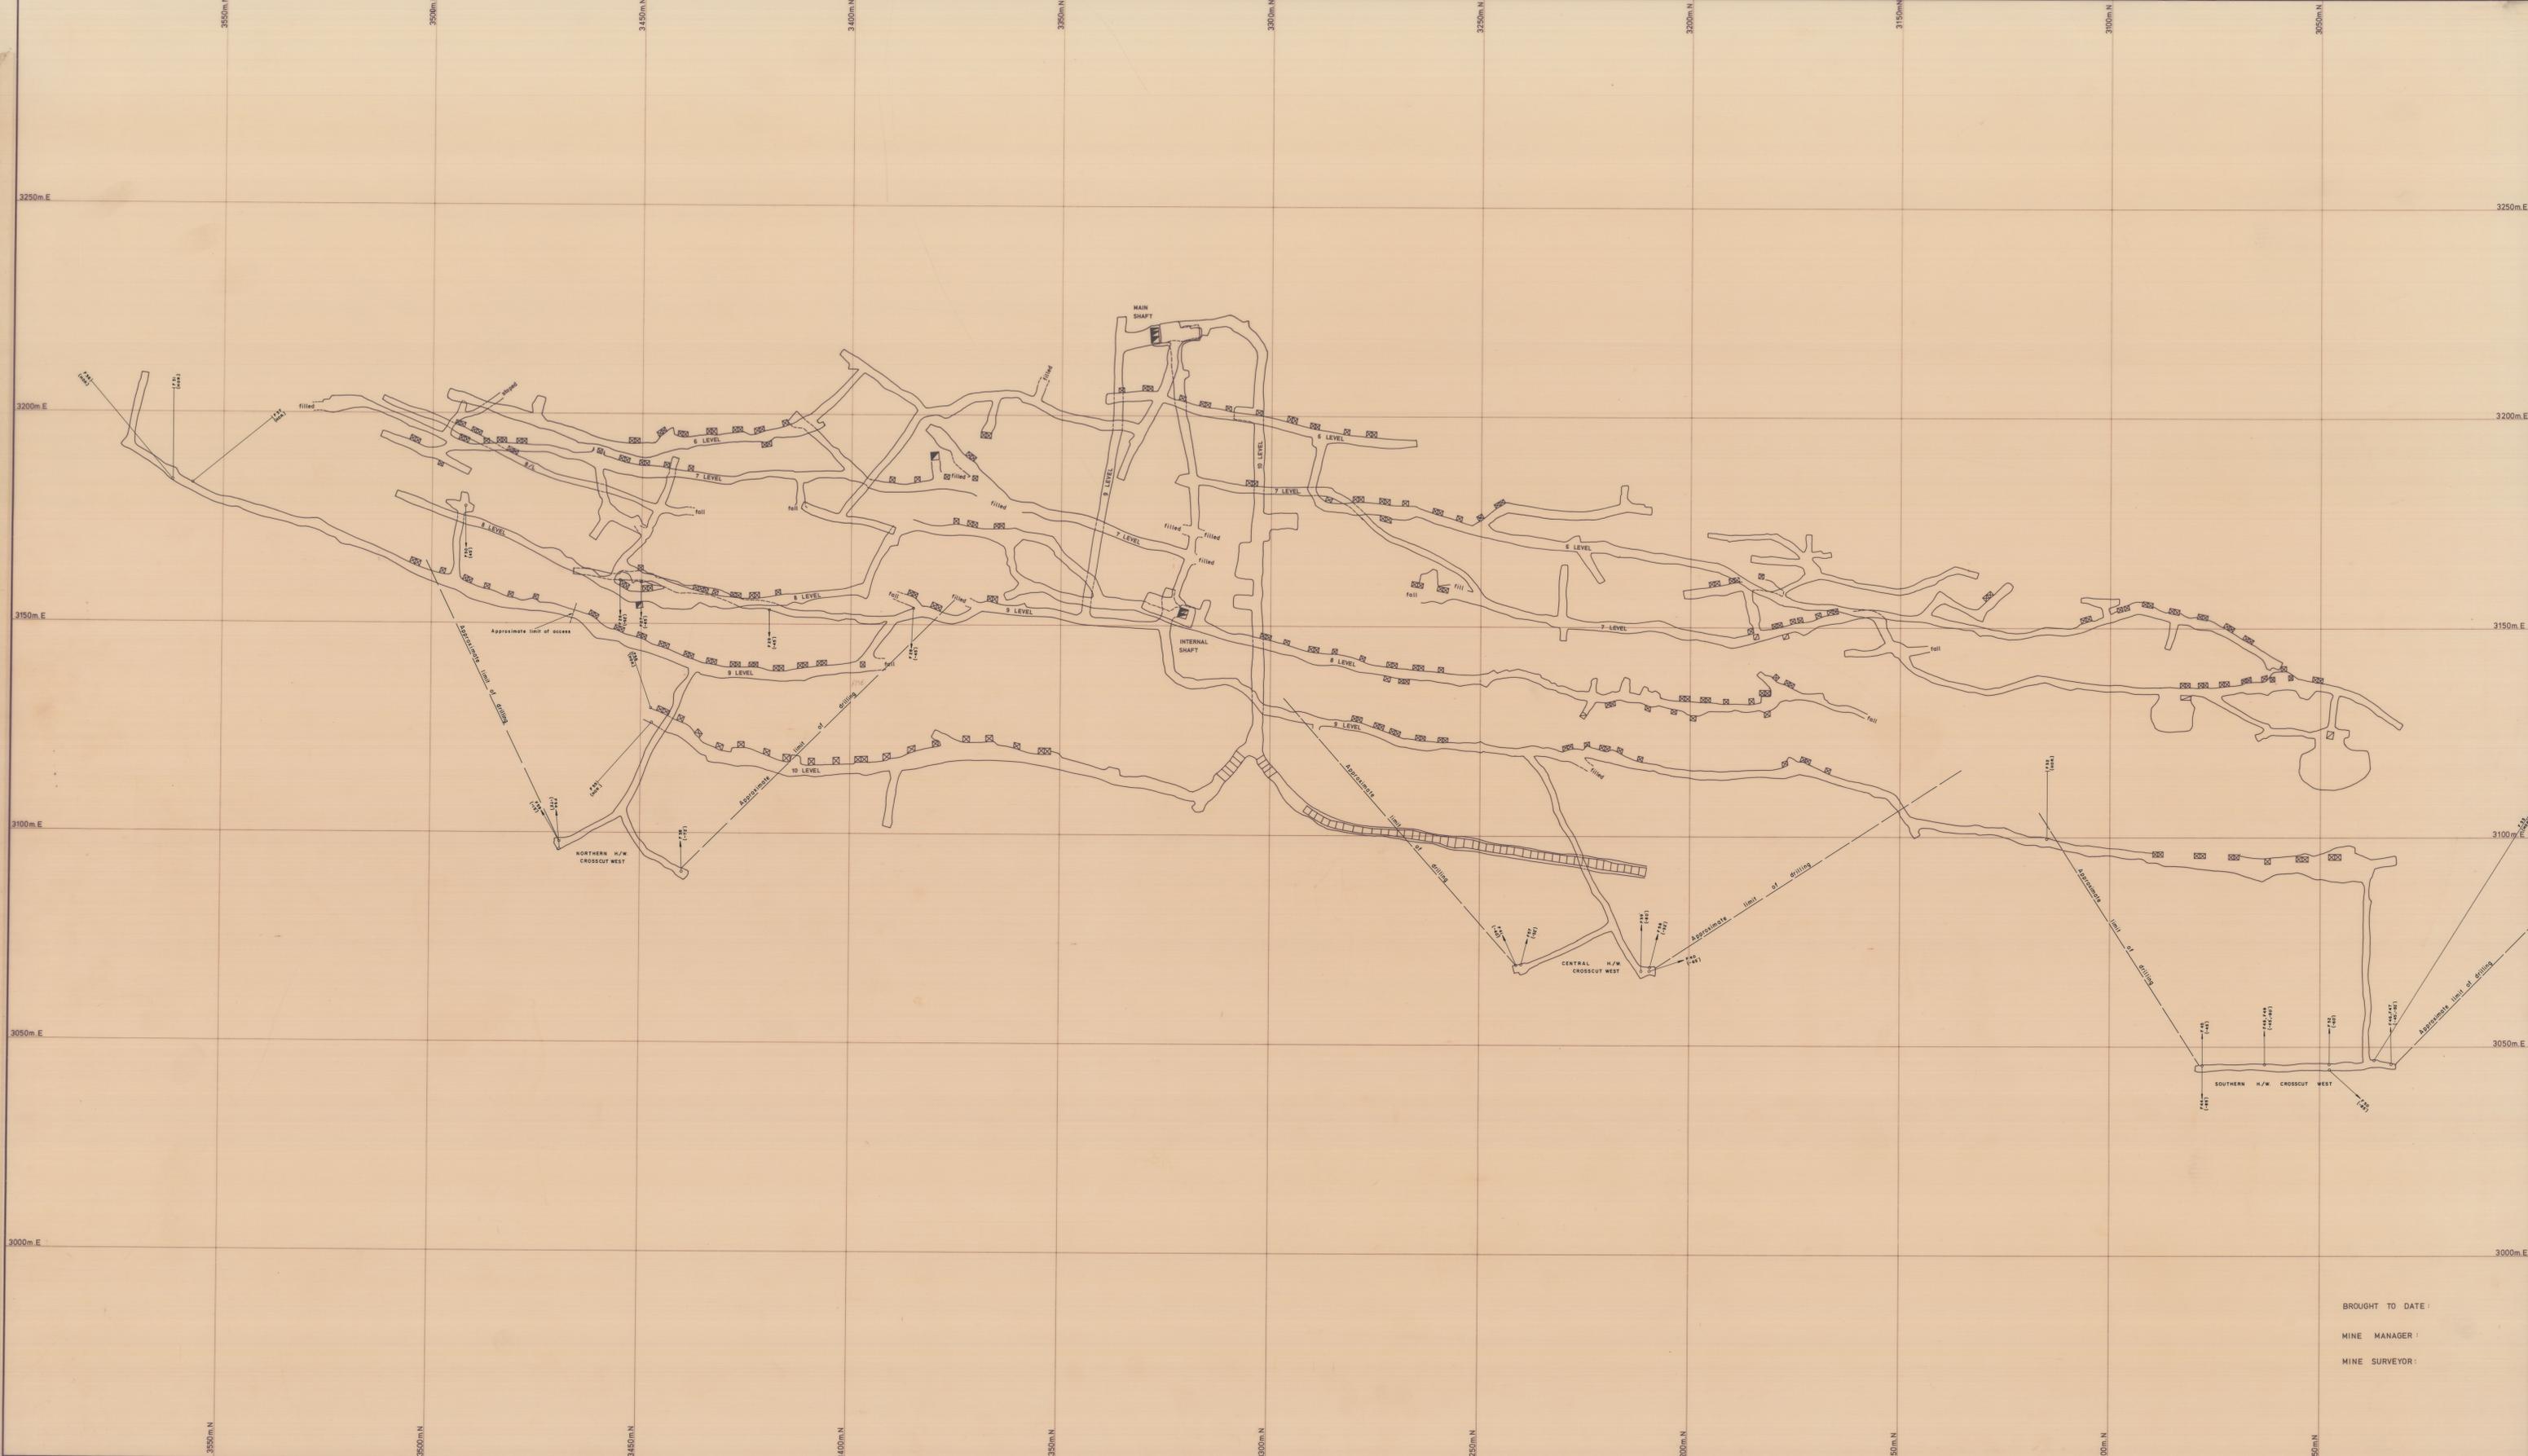

BROUGHT TO DATE :
 MINE MANAGER :
 MINE SURVEYOR :

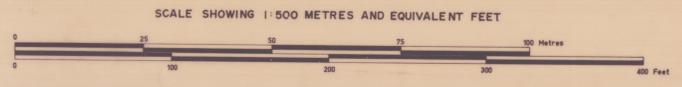

ELECTROLYTIC ZINC COMPANY OF AUSTRALASIA LIMITED
 WEST COAST MINES , T.A.S.

SURVEY BY		SCALE	1 : 500 METRES
DRAWN BY		DATE	1973
TRACED BY	P. J. Lowe	REFERENCE	

FARRELL MINE
 COMPOSITE PLAN
 BELOW 6 LEVEL ONLY

DRAWING N^o :
 DEPARTMENT OF MINES
 PLAN