



0061\_075

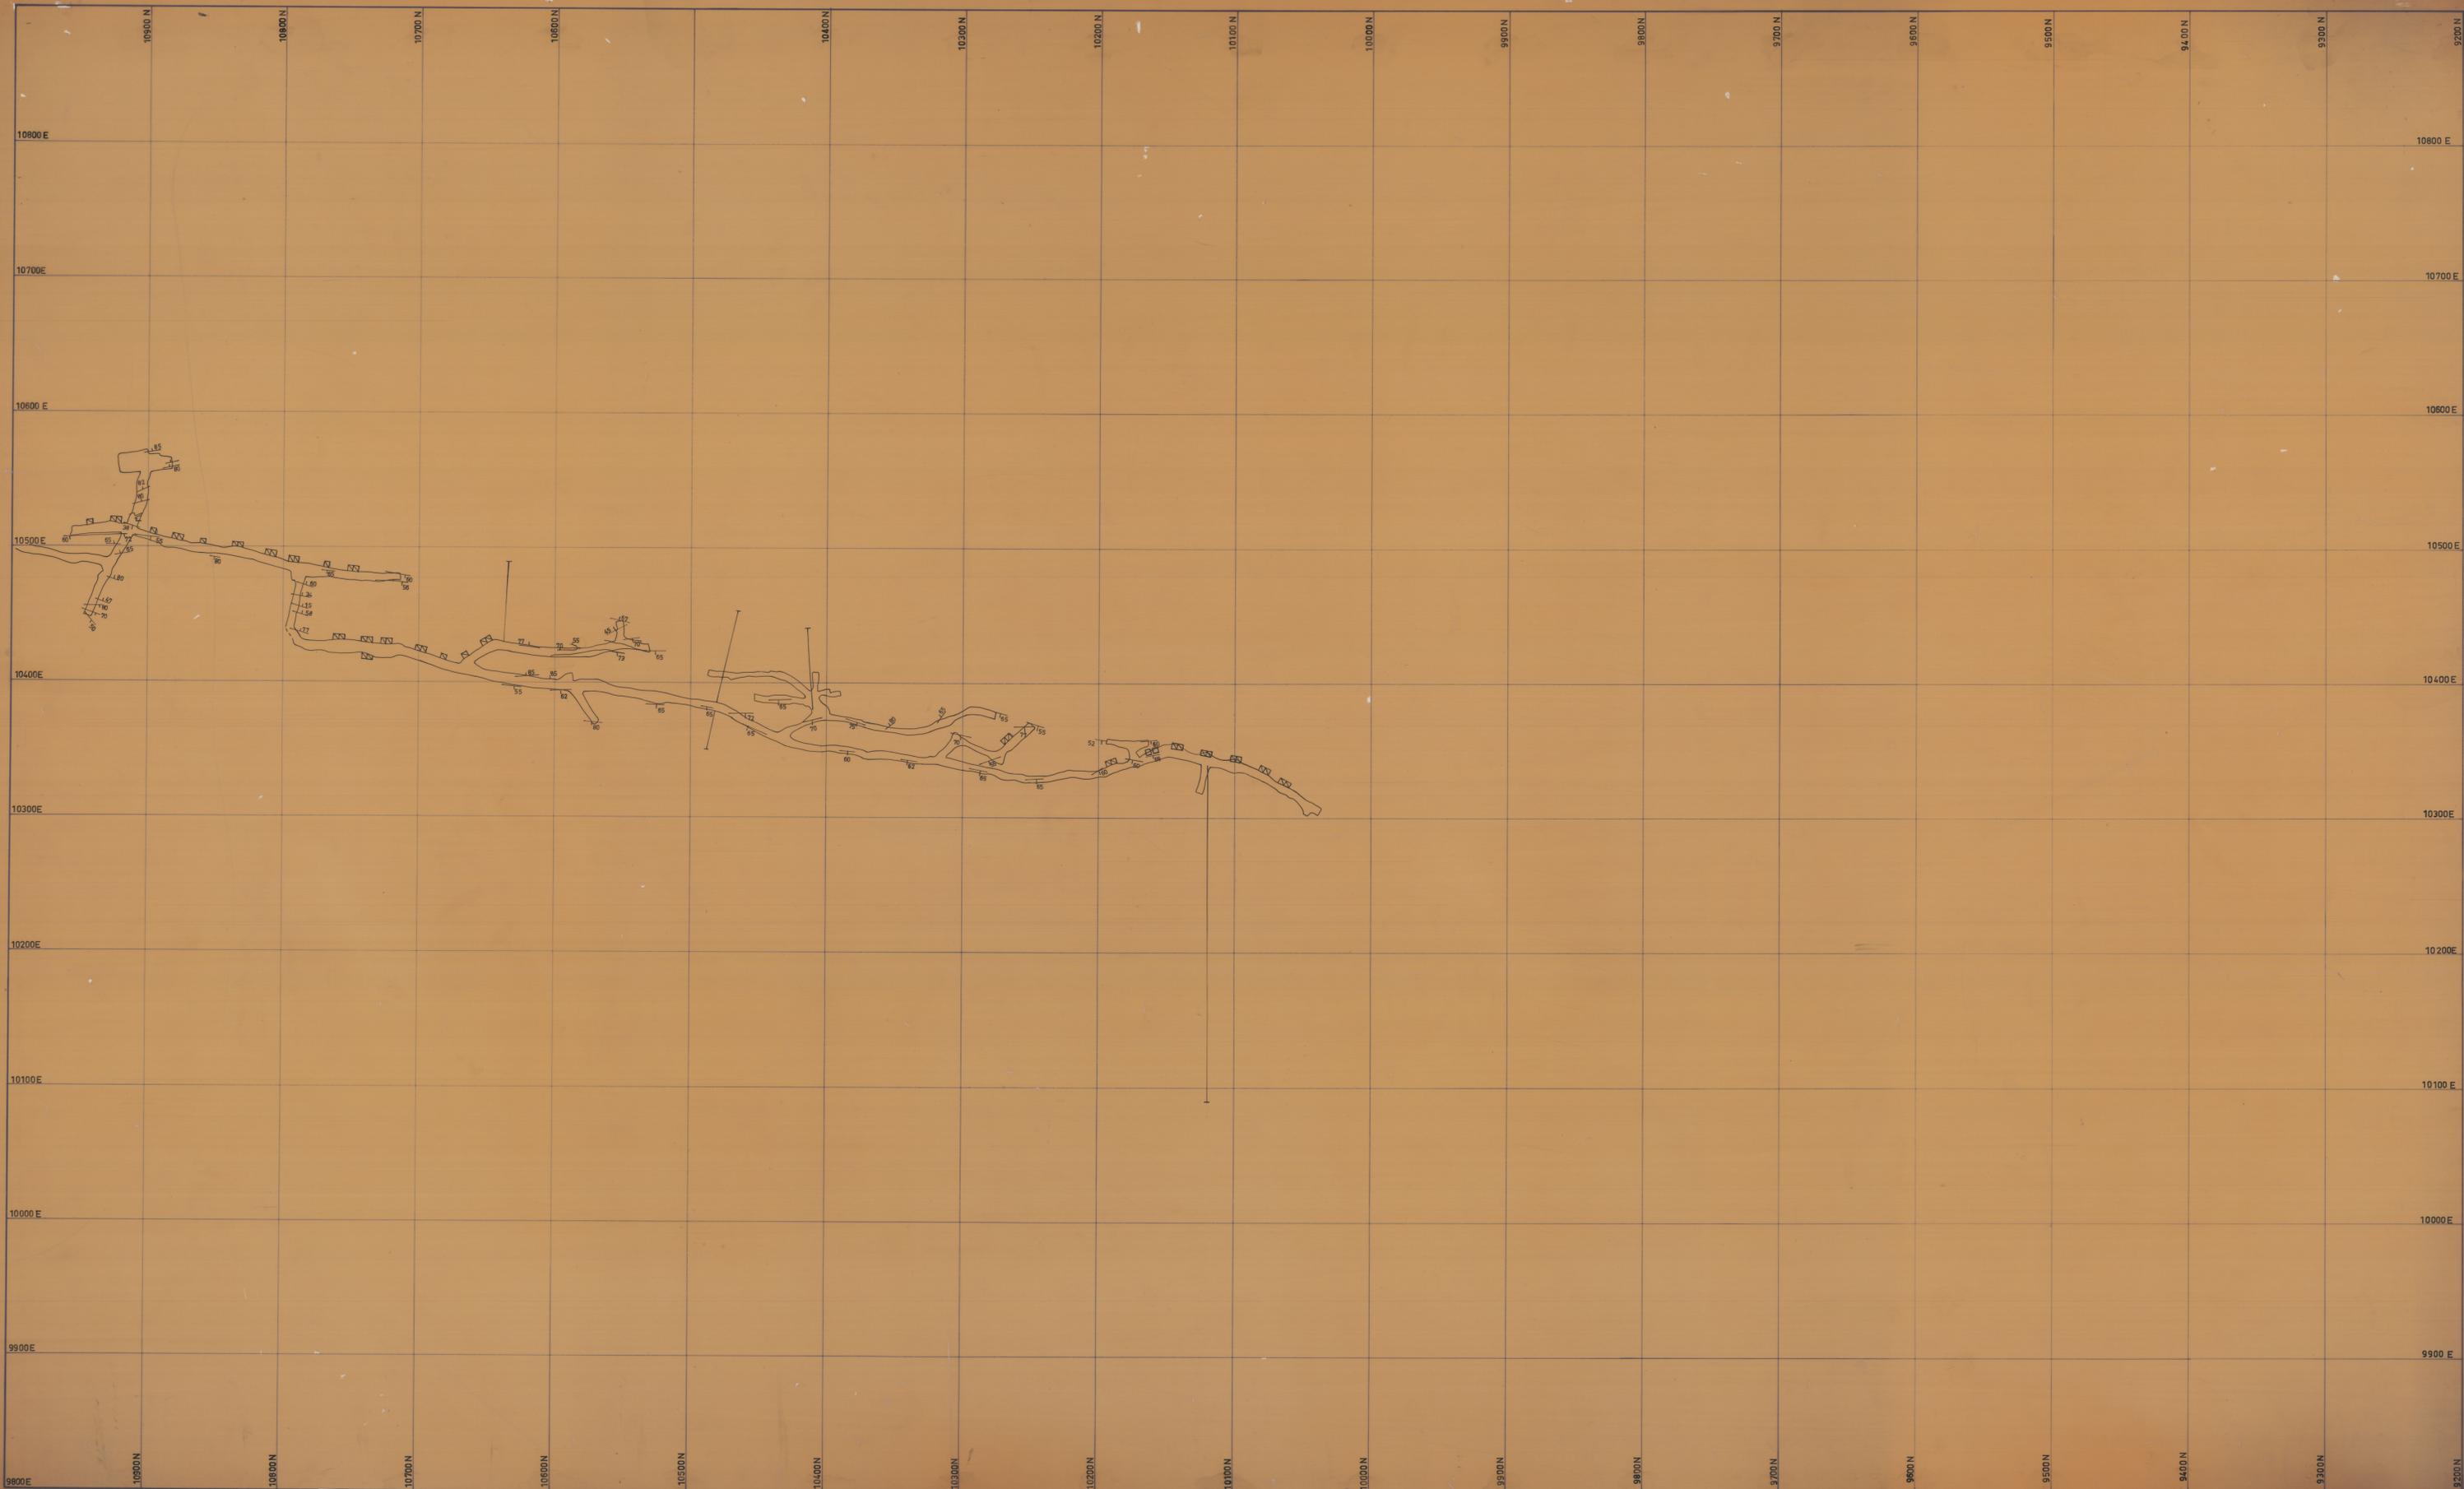

ELECTROLYTIC ZINC COMPANY OF ASIA,  
 Geological Department

Date: Copy for:

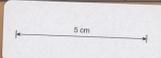

6 LEVEL  
 SOUTH END

SCALE 1" = 40'

NEW NORTH MT. FARRELL MINE  
 6 LEVEL

9200N — 11000N