


62-04

62-04

5 cm

BLOCK DIAGRAM

FAULTING NOT POSITIONED
POSSIBLE FAULTING-DALMAYNE COAL SEAM

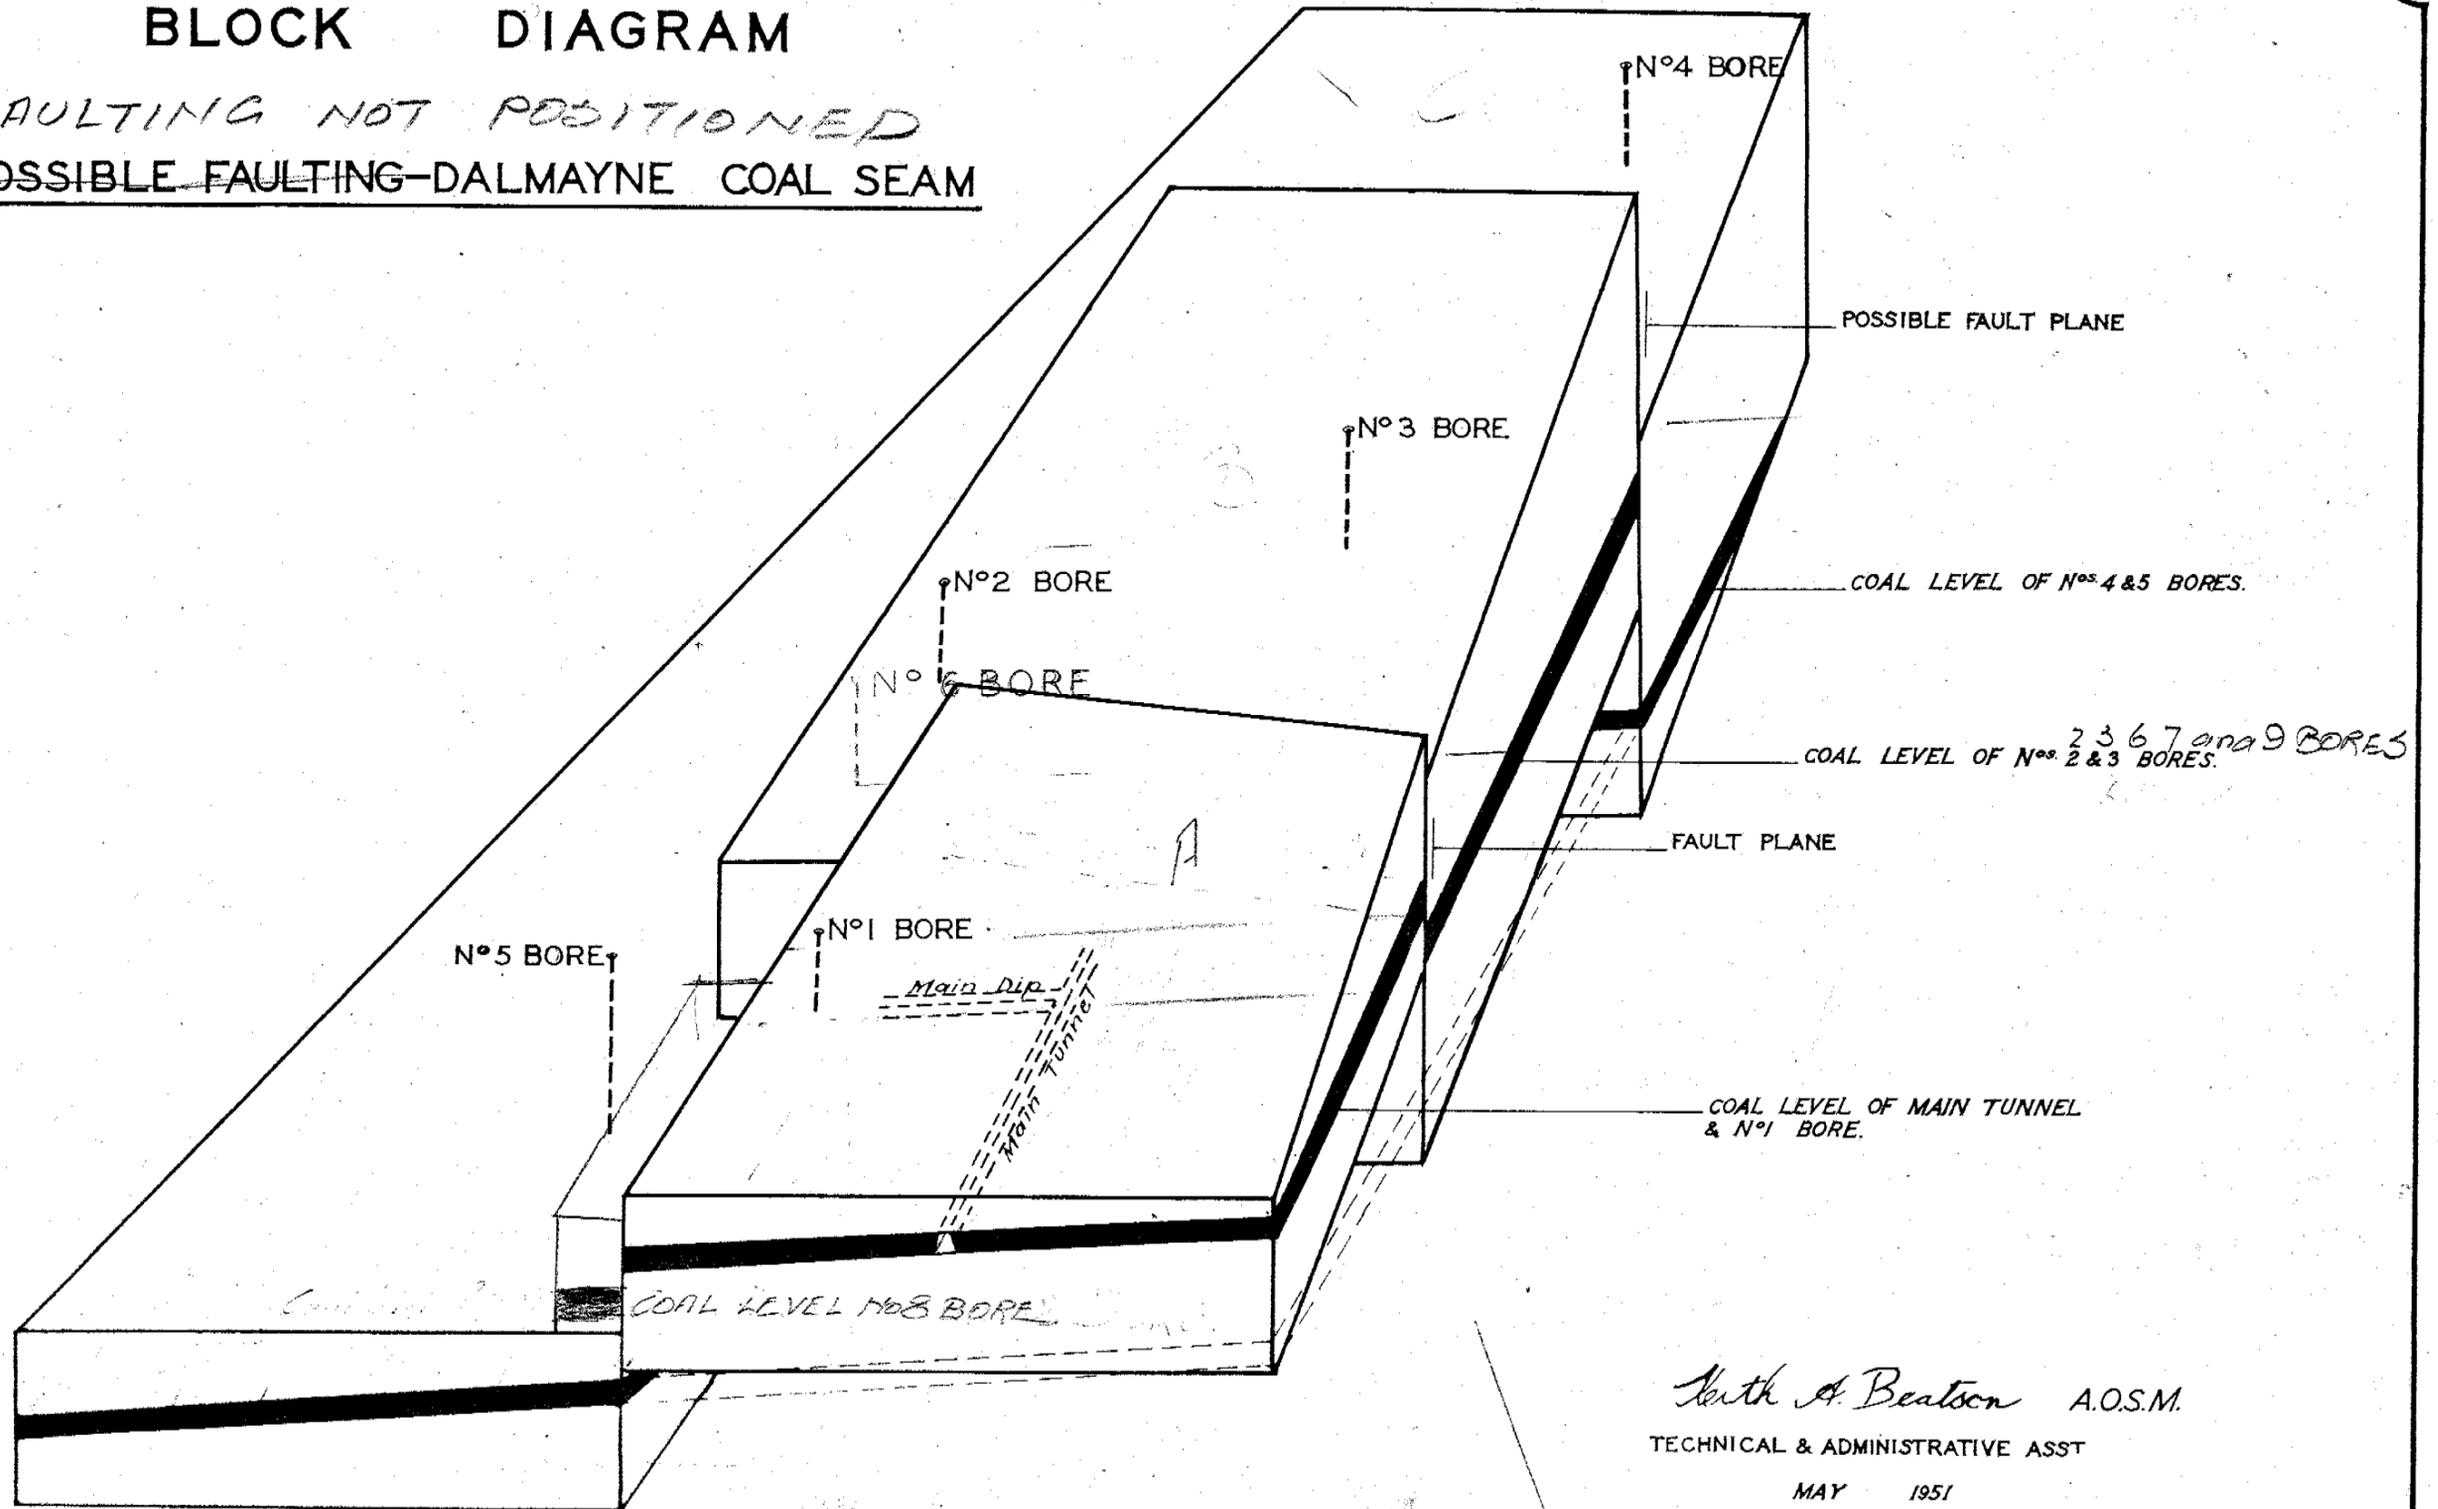

Keith A. Beatson A.O.S.M.
 TECHNICAL & ADMINISTRATIVE ASST
 MAY 1951