
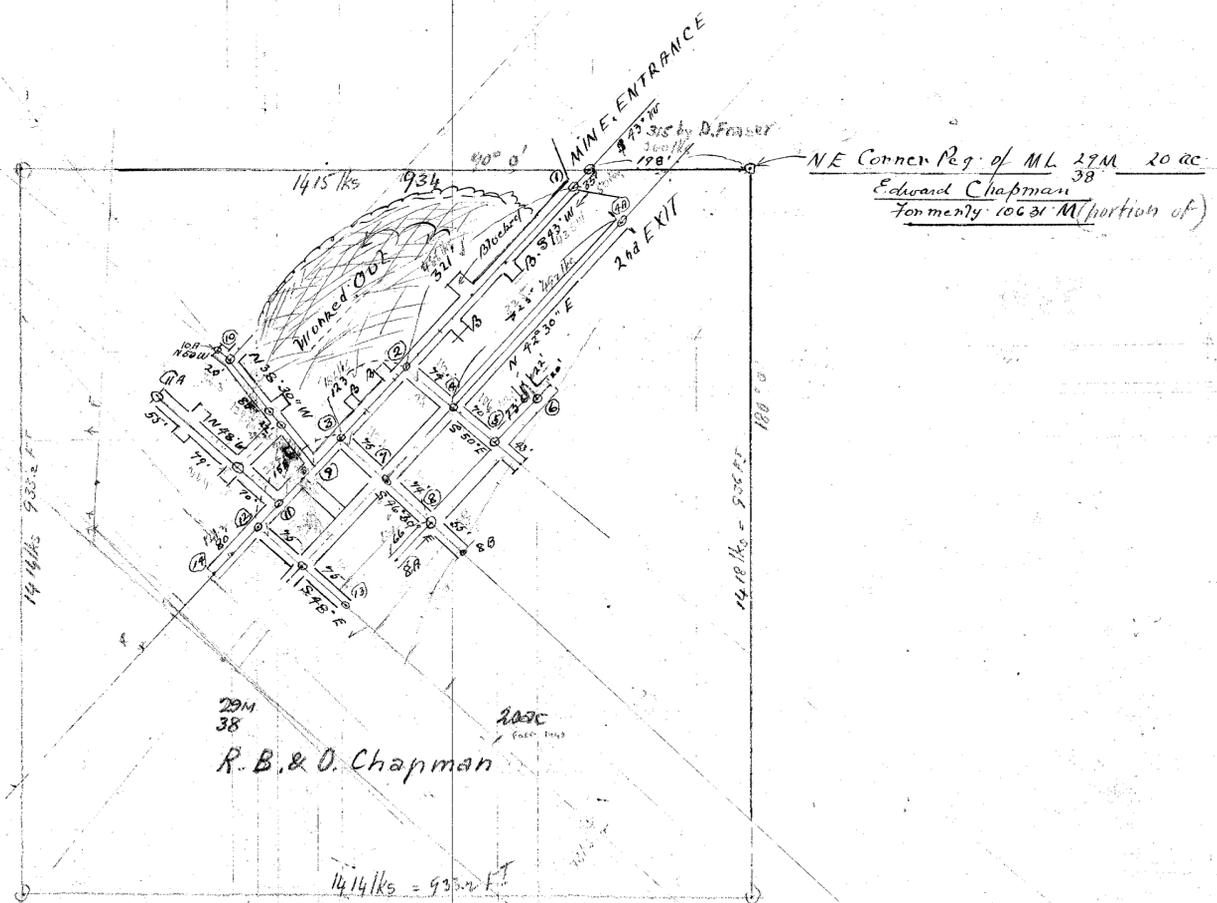


Station Bearing Distance

62-06

1	2	S 43° W	321'	406.166
2	3	" "	123'	186.0
3	12	" "	158'	239.4
12	13	S 78° E	150'	227.2
12	14	S 43° W	80'	121.1
2	7	S 50° E	77'	112.1
7	5	" "	70'	106.0
5	6	N 73° 30' E	73.6'	110.6
3	7	S 76° 30' E	75'	113.6
7	8	" "	74'	112.1
8	8A	" "	66'	120.0
8	8B	S 42° W	55'	83.3
9	10	N 38° 30' W	193'	282.1
11	11A	N 48° W	204'	309.0
7	4A	N 42° 30' E	325'	492.0
10	10A	N 50° W	20	30.3

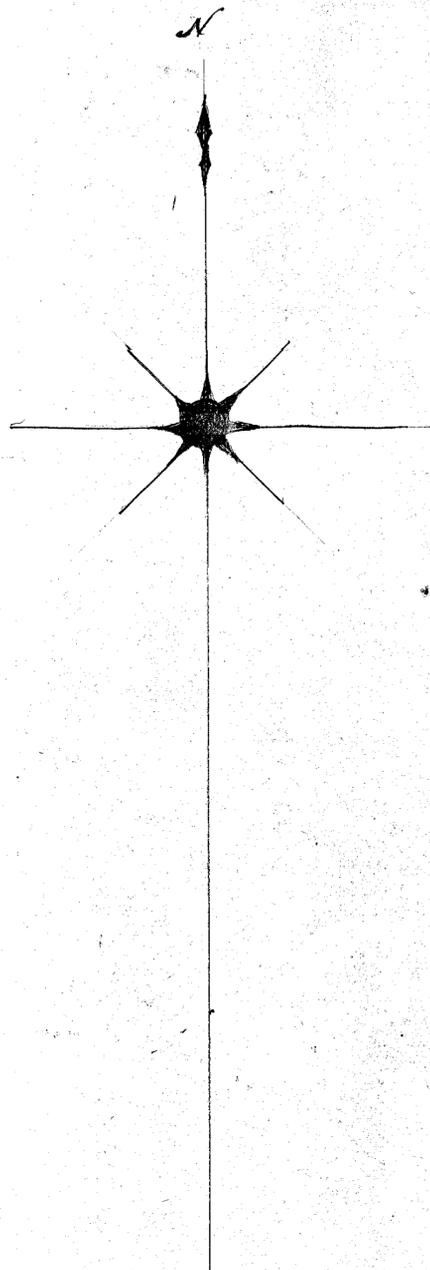

62-06



PLAN

DALMAYNE COLLIERY = R. B. Chapman & O Chapman

Compass Survey

Scale 2 Chains to 1 inch Instrument used 4" Miners Dial J.H. Grand. 15. 6. 92

Scale 132 feet to 1 inch