


62-07




*Dalmayne Collieries Limited*  
*Thompson's Marshes*  
*Parish of Cornwall.*

*Dalmayne Collieries Ltd*

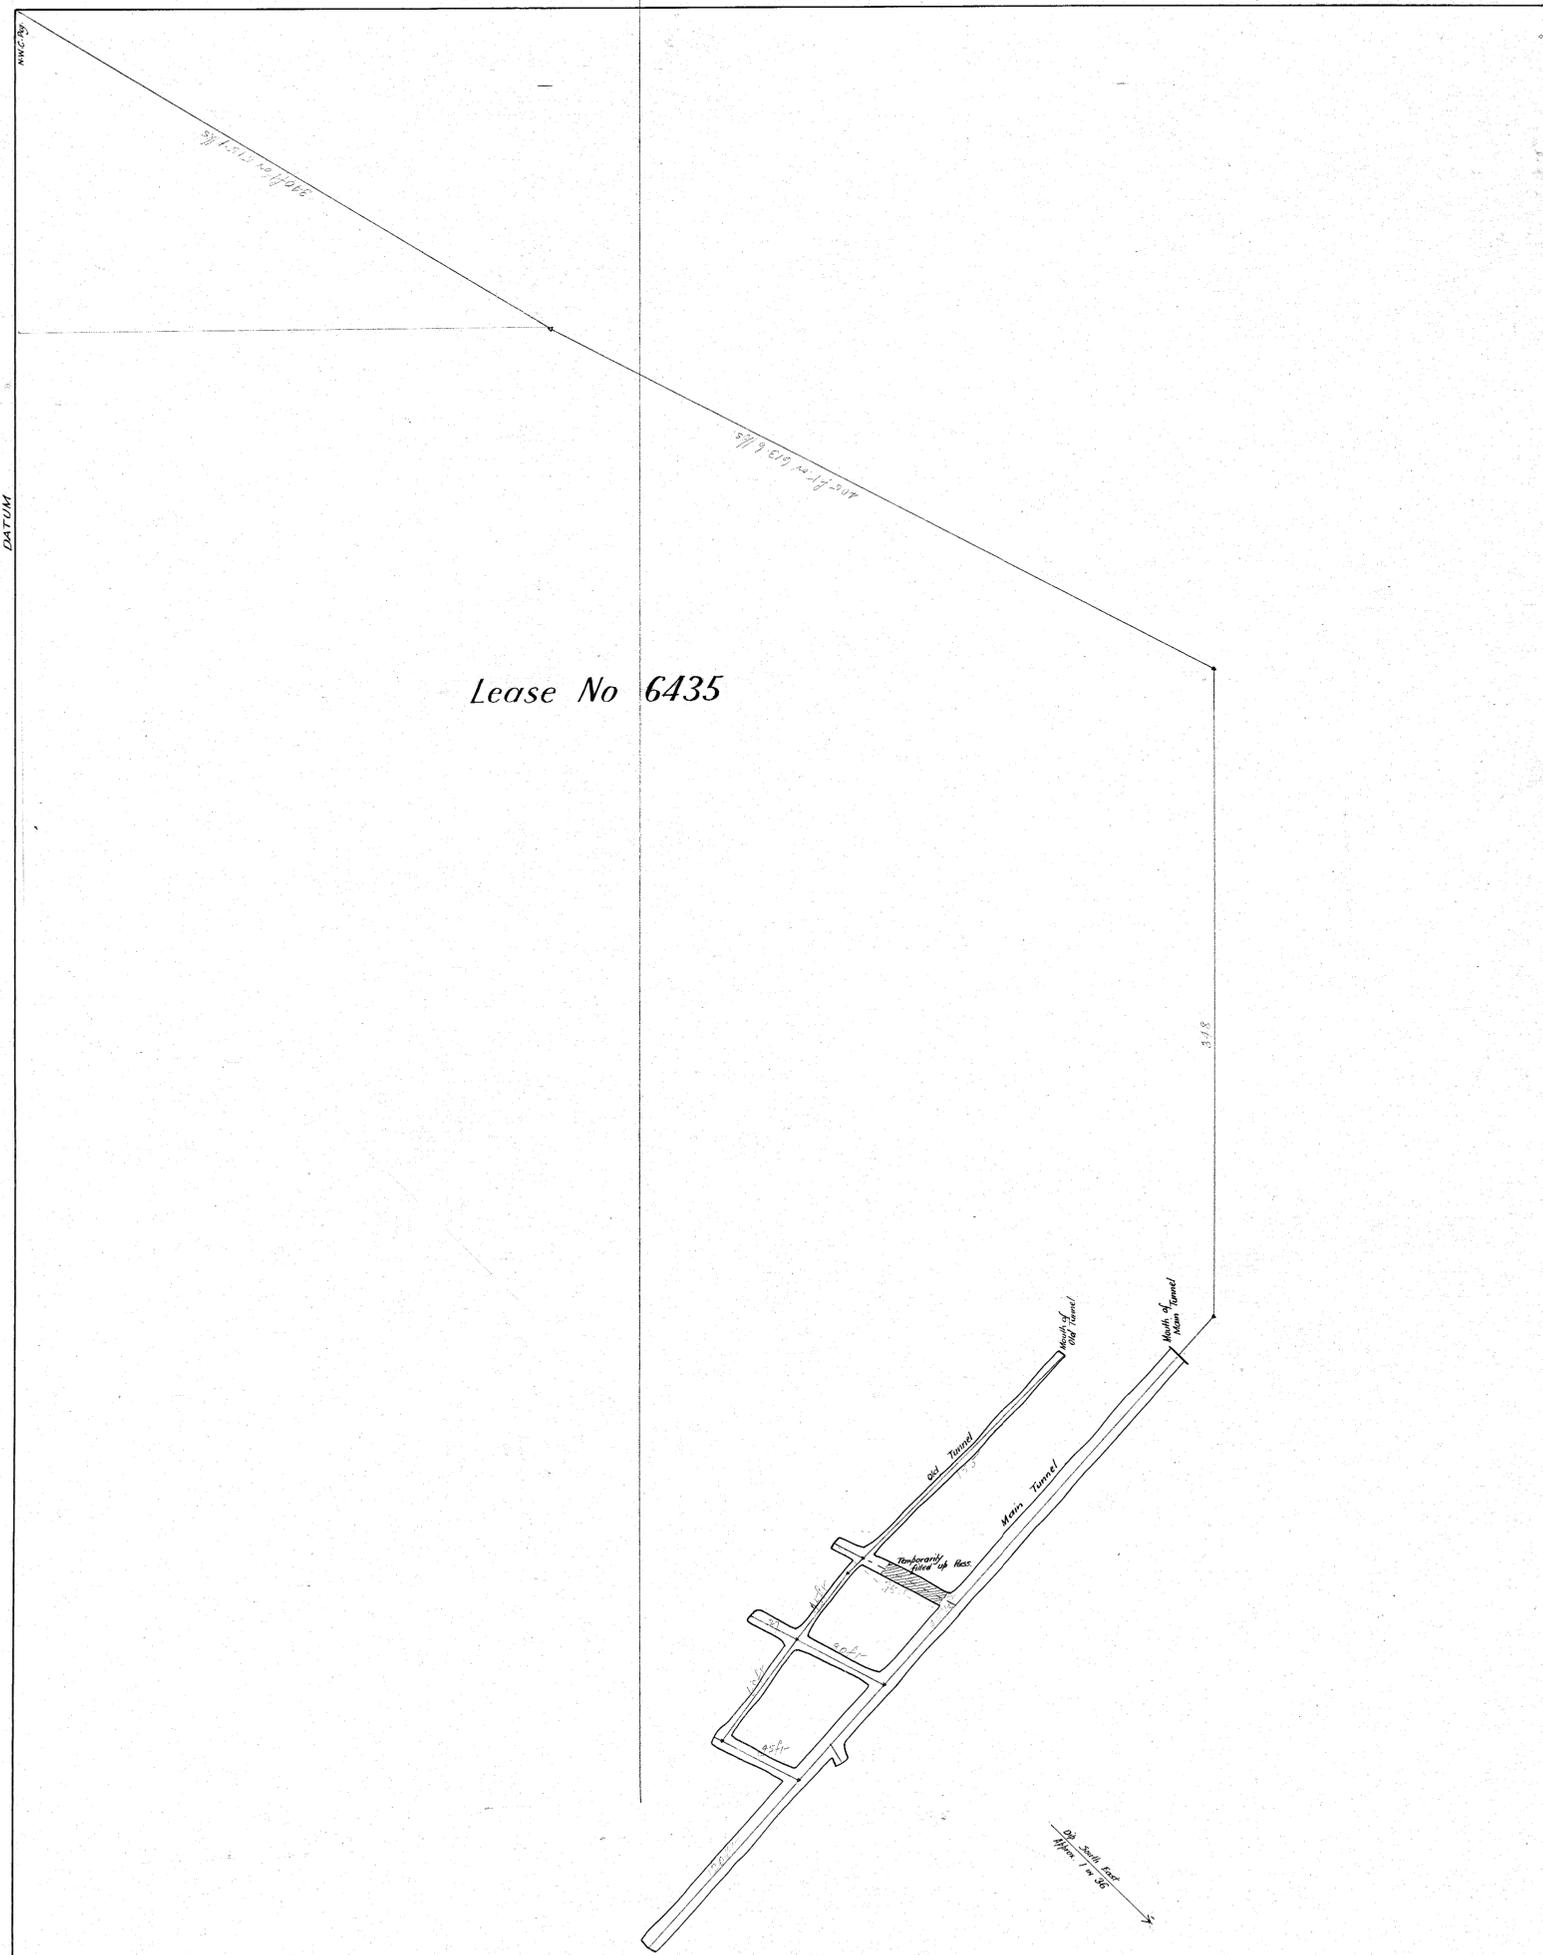

Lease No 6435

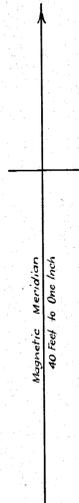

*This survey was made with theodolite and chain both in perfect adjustment. 19.10.16*

*P. M. Donald MINE MANAGER.*  
*27/11/16*