




360  
+ 72  
318

62-11


# DALMAYNE COLLIERY

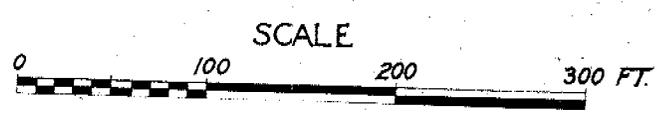

360  
129  
231

45  
39  
51  
135

90  
39  
129

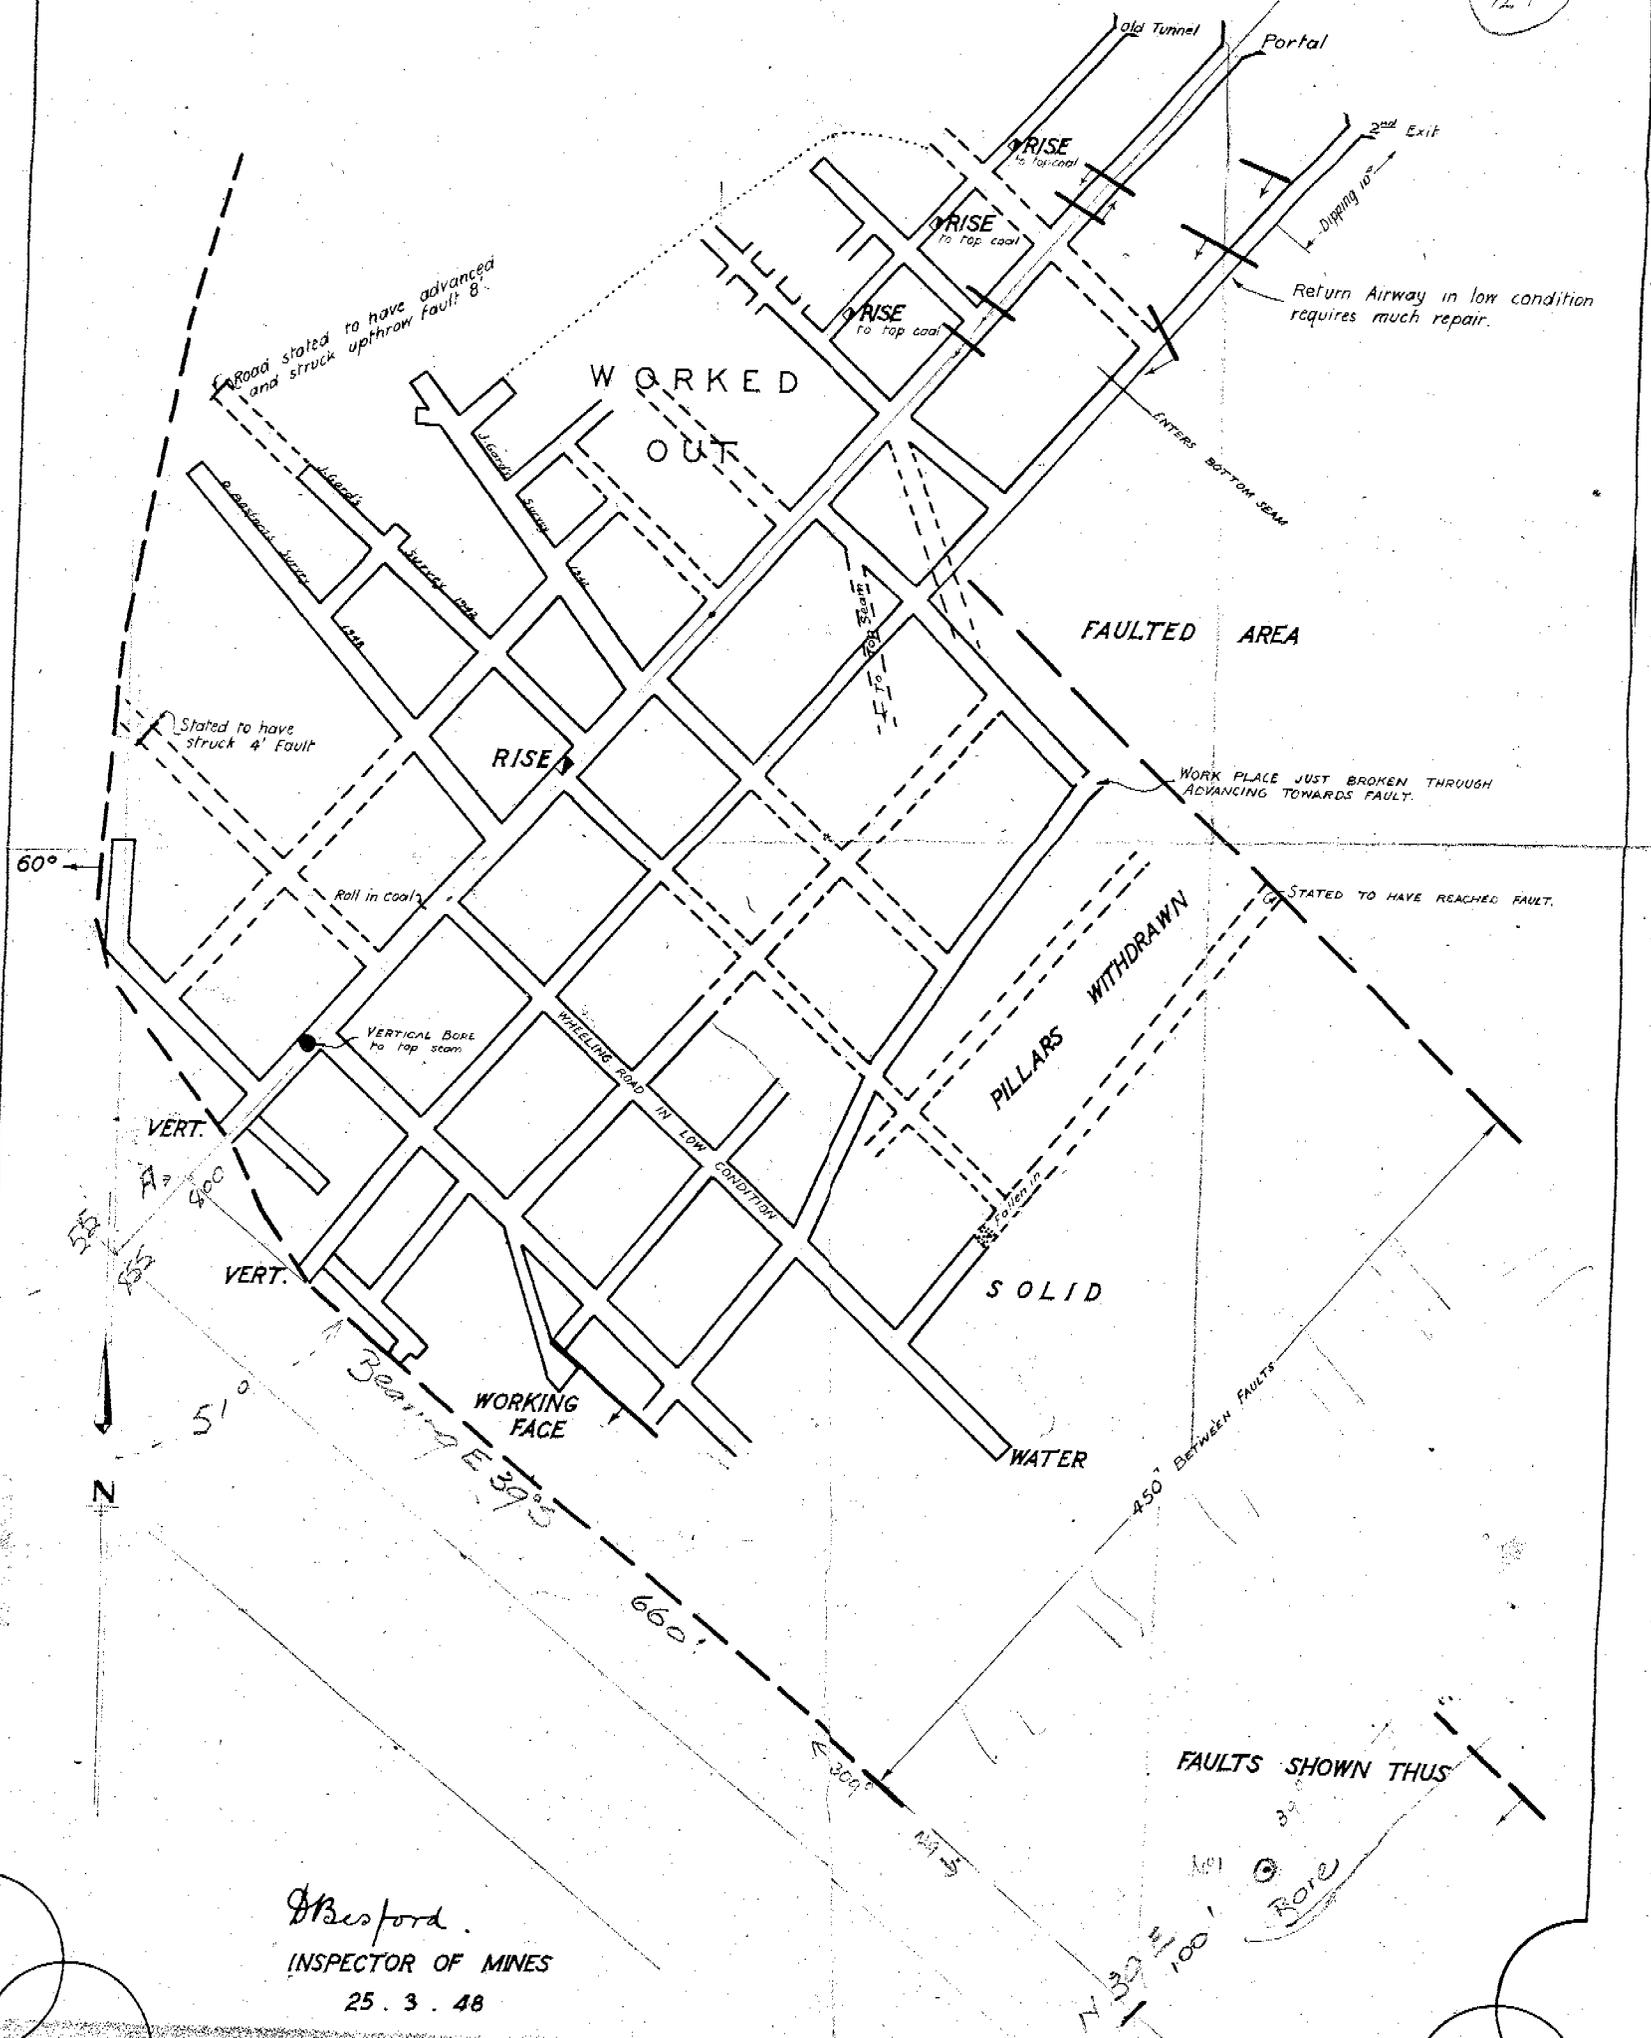

J. Besford.  
INSPECTOR OF MINES  
25. 3. 48

1043-49

RTR