
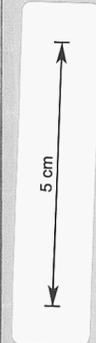


DALMAYNE COALFIELD

PART OF PLATE V - COAL RESOURCES OF TAS.

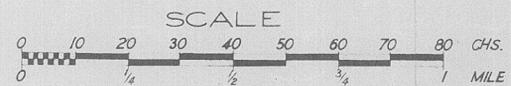


LEGEND

SEDIMENTARY		
RECENT	ALLUVIUM	[Pattern]
TRIAS-JURA	SANDSTONES & SHALES	[Pattern]
PERMO-CARBONIFEROUS	LIMESTONES & MUDSTONES	[Pattern]
CAMBRO-ORDOVICIAN	SLATES	[Pattern]
IGNEOUS		
UPPER MESOZOIC	DOLERITE	[Pattern]
DEVONIAN	GRANITE	[Pattern]

BORE HOLES (From 1860)

H. G. Keid M. Sc.
CHIEF GEOLOGIST
10 3 1948

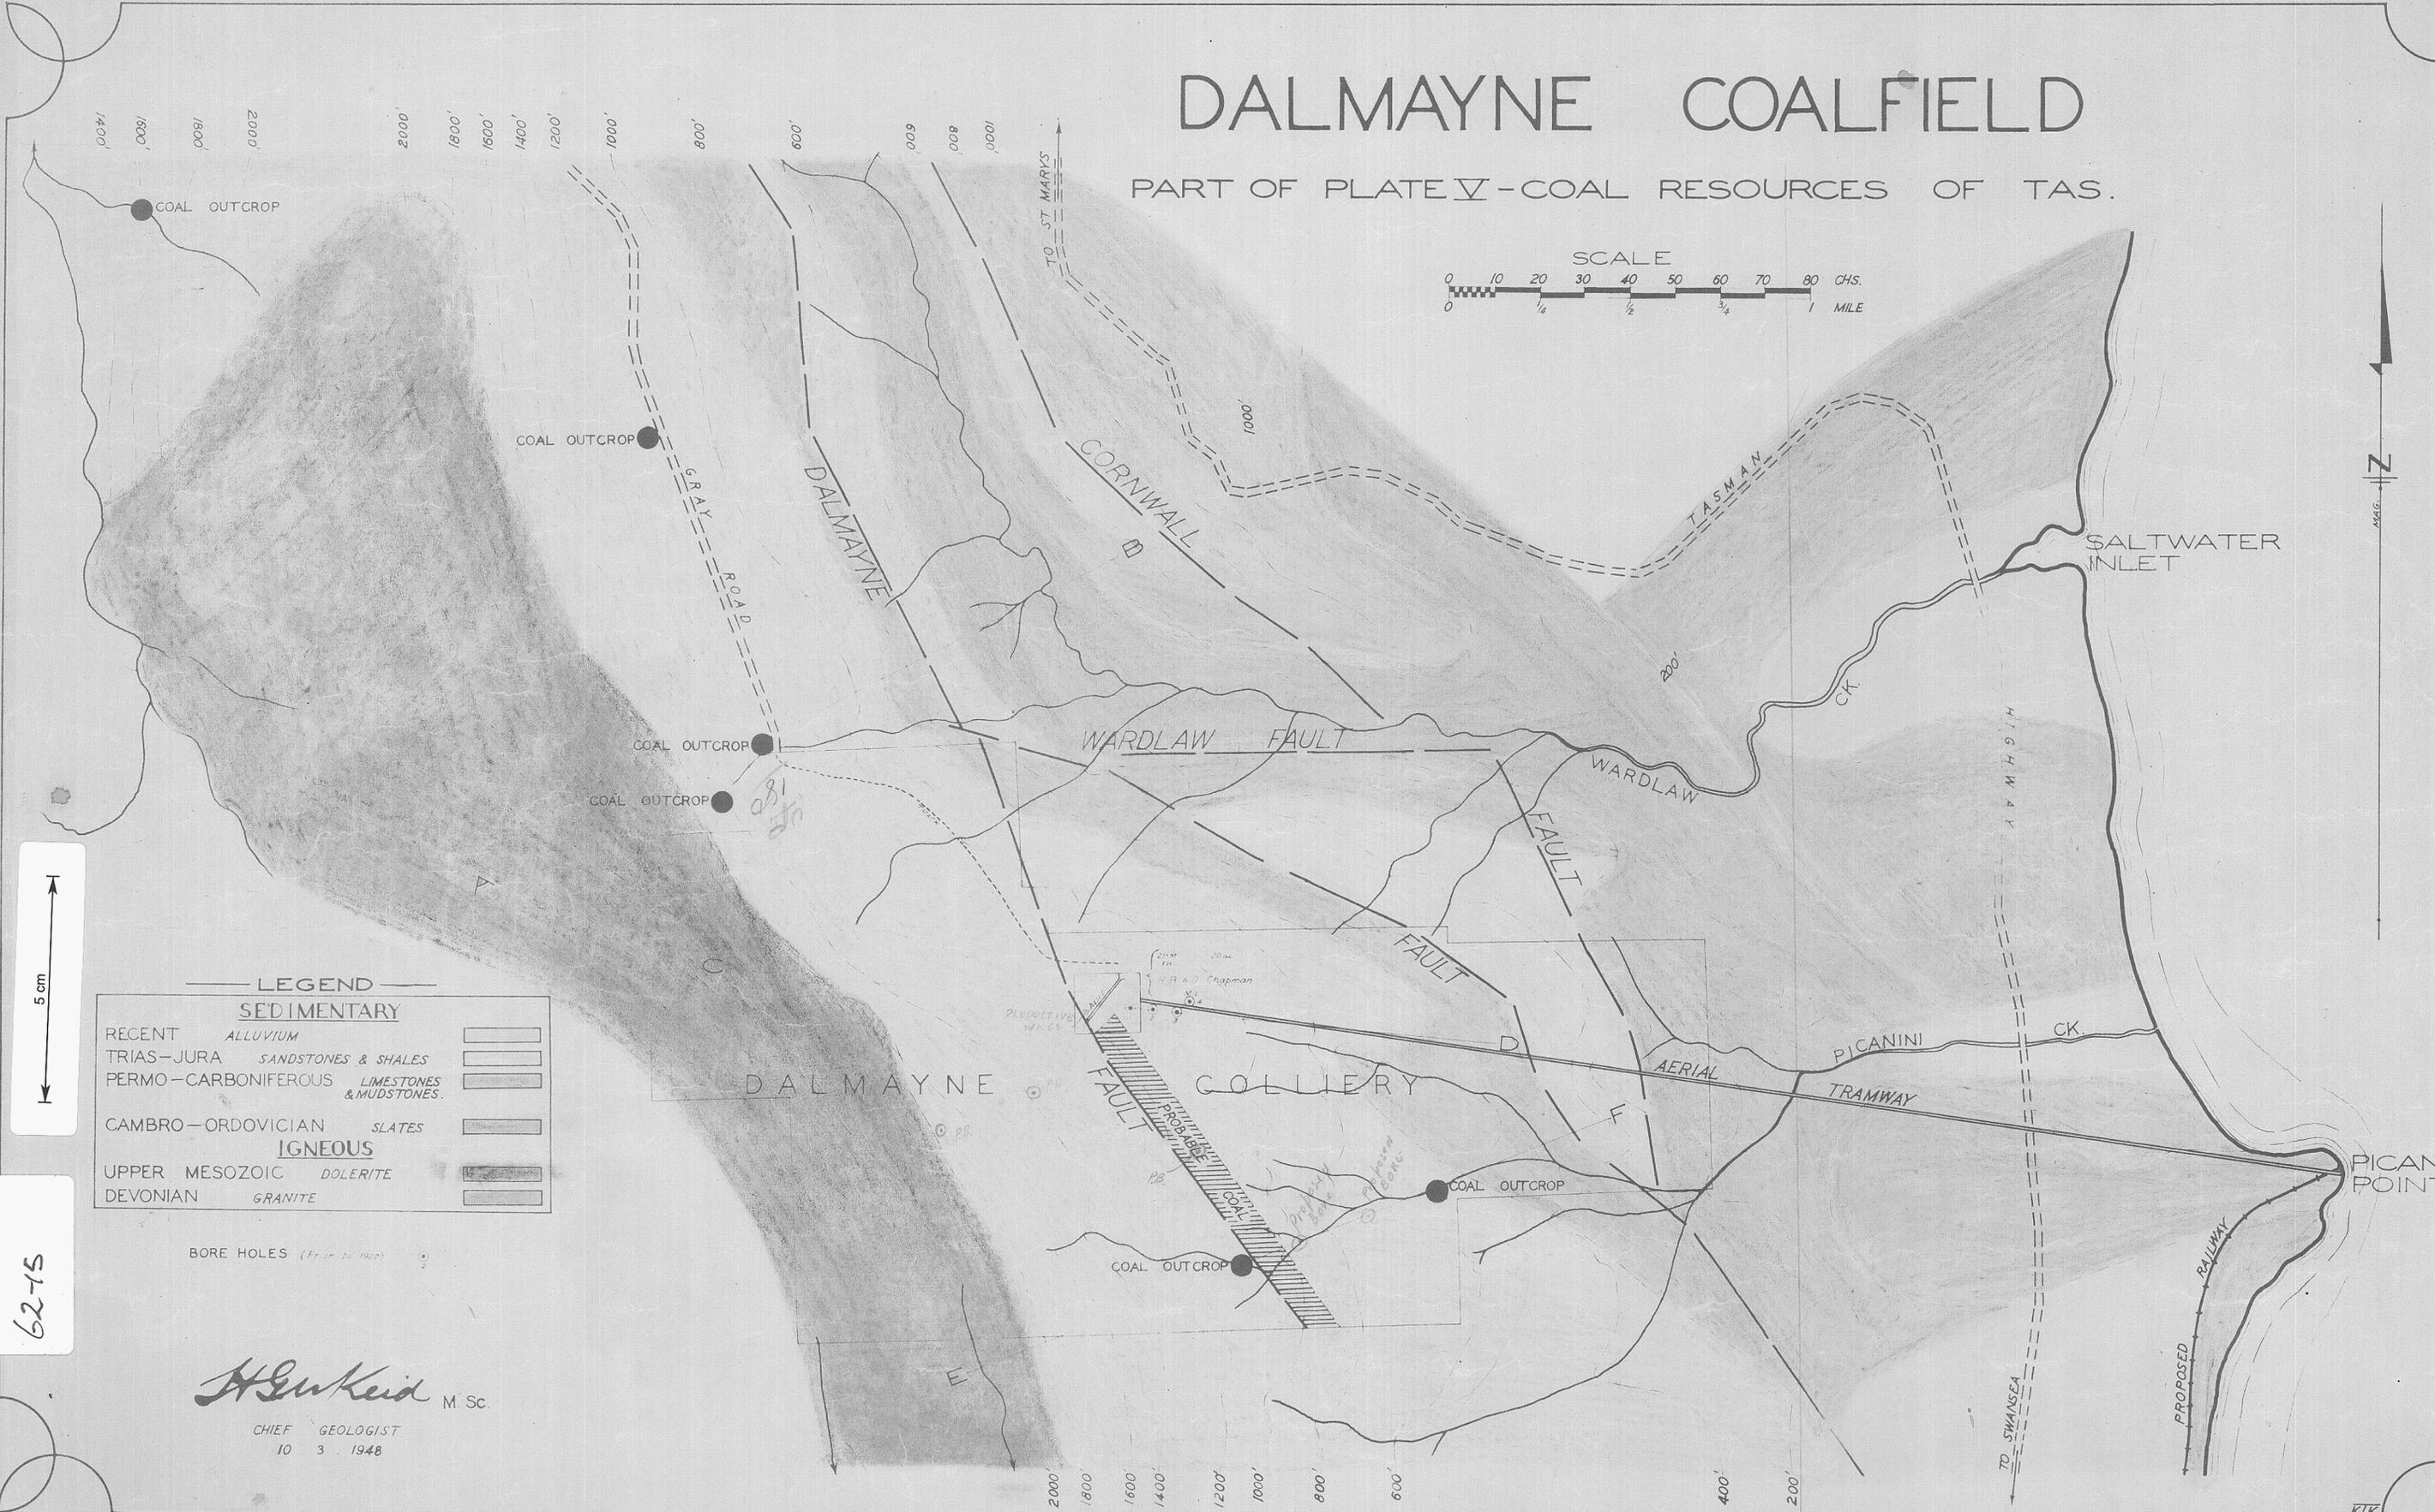

KTK

1039A-49

62-15

62-15