
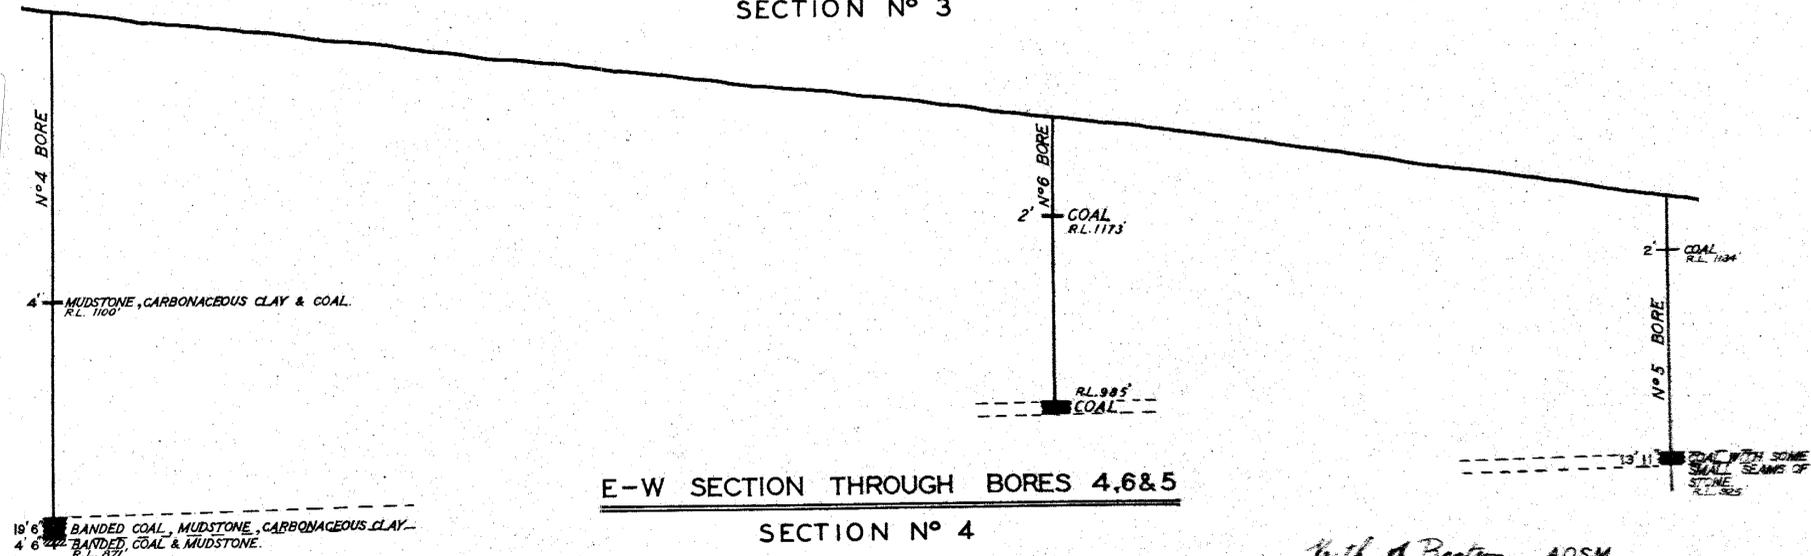
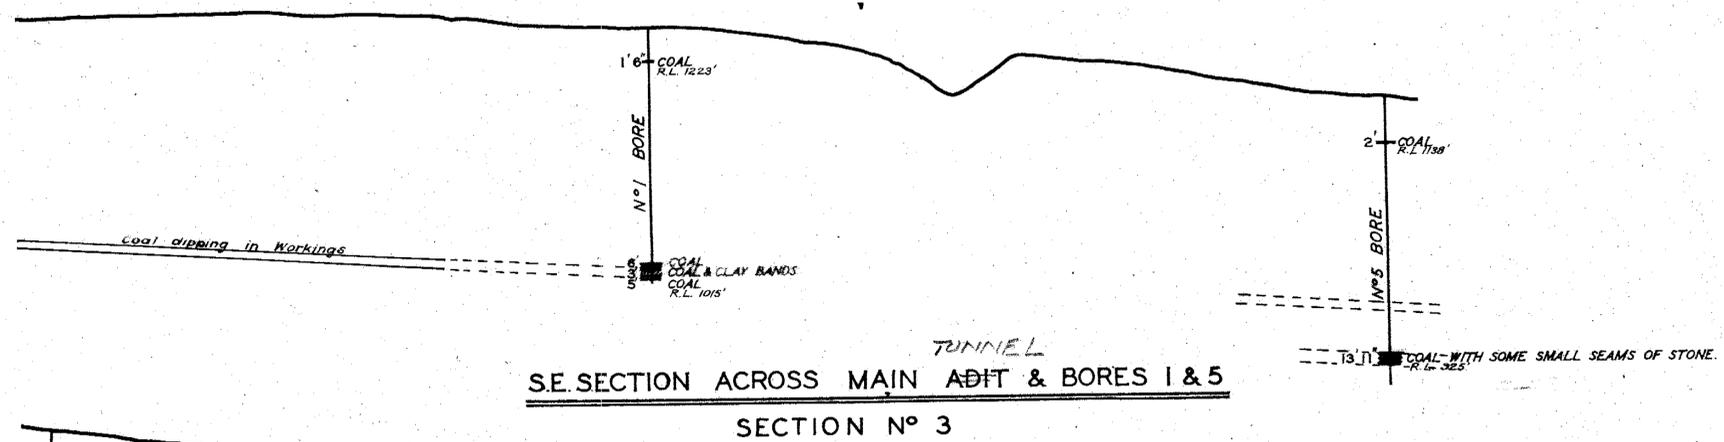
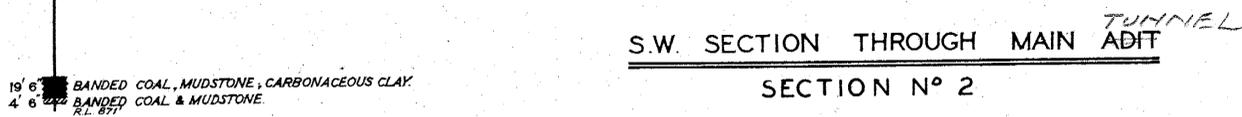
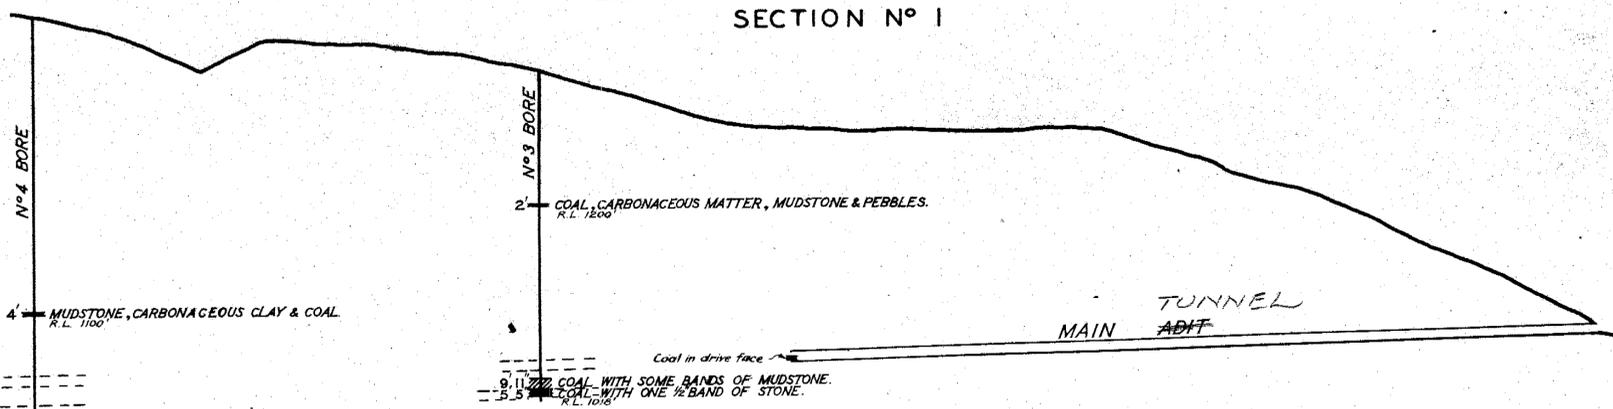


BORE SECTIONS — DALMAYNE COALFIELD

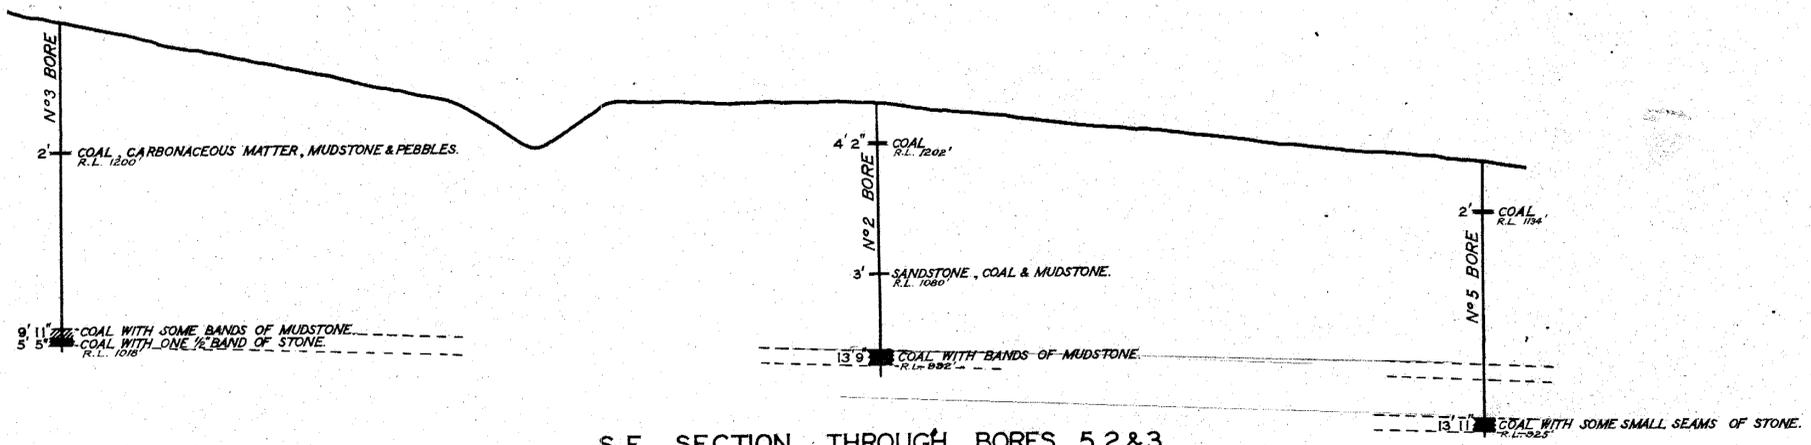

Keith A. Beaton A.O.S.M.
TECHNICAL & ADMINISTRATIVE ASST.

APRIL 1957

62-20

62-20

5 cm