


63-02
63-03
63-04

63-03

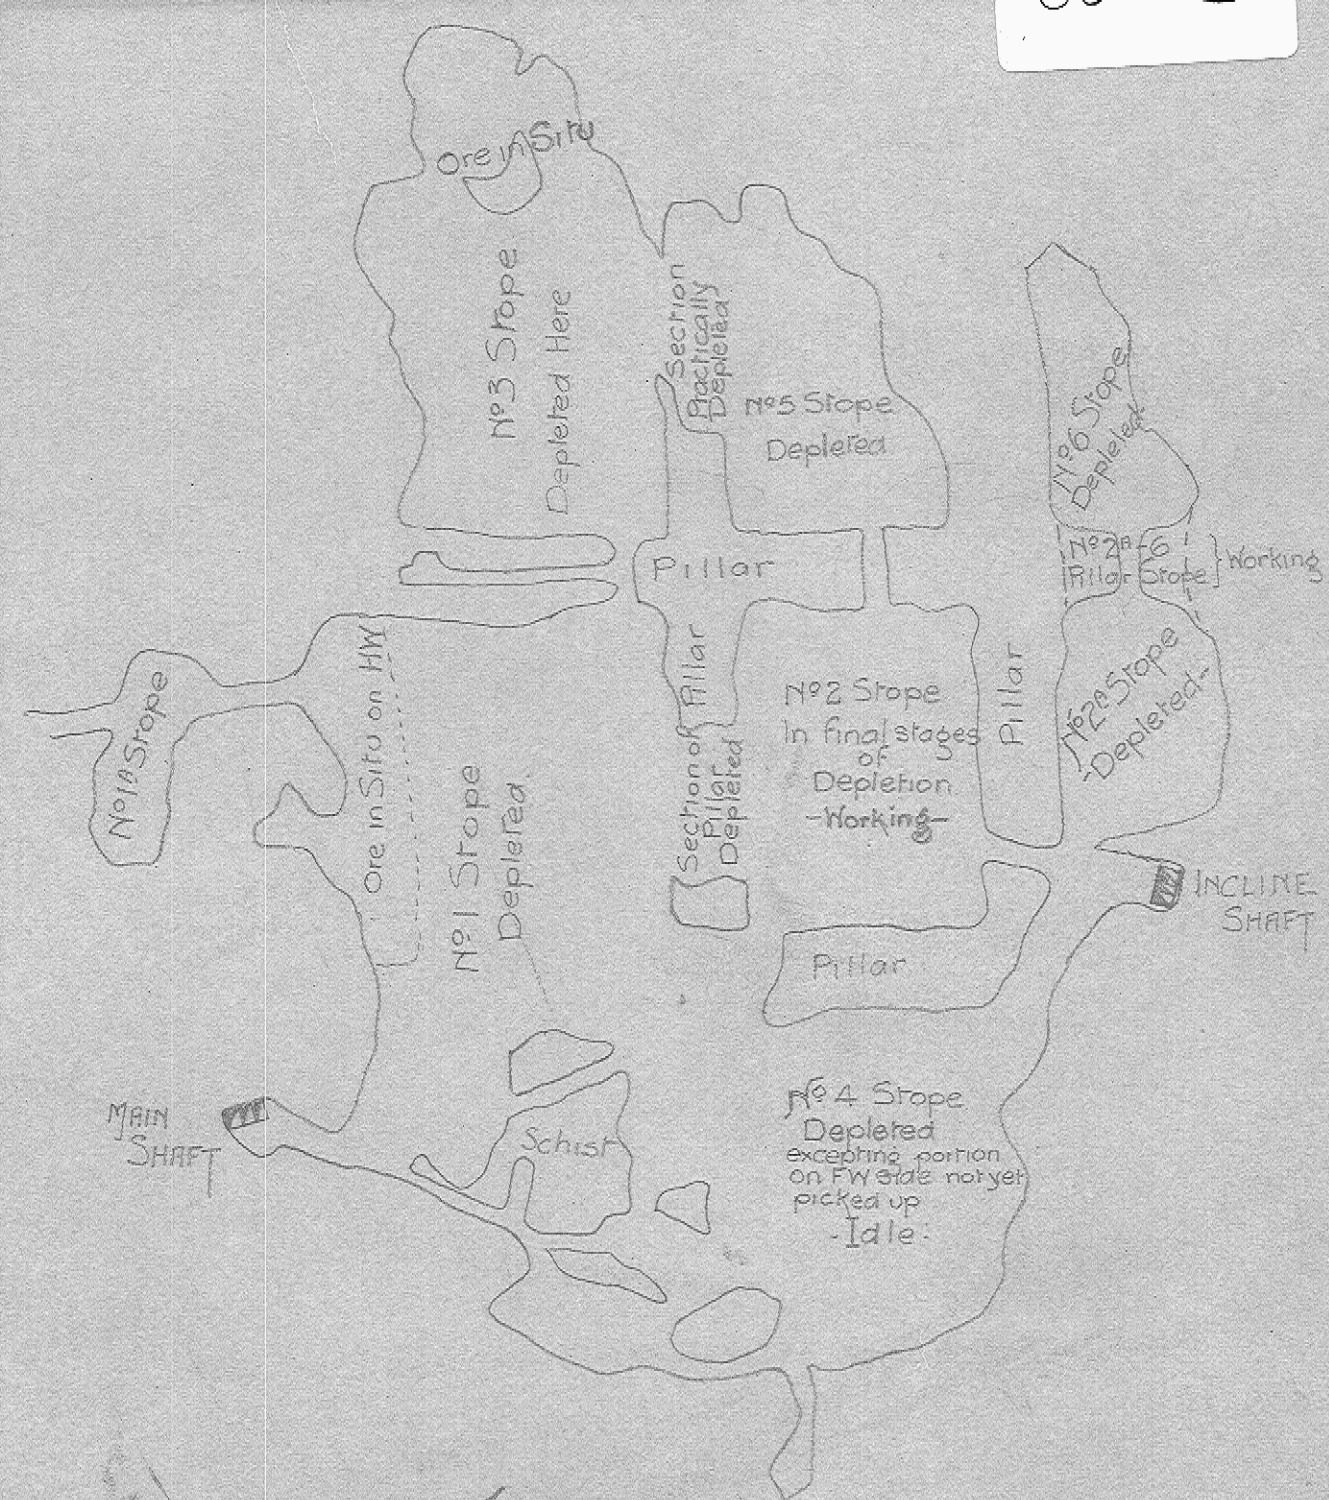

No 7 Level
Scale 60' = 1"