


63-04

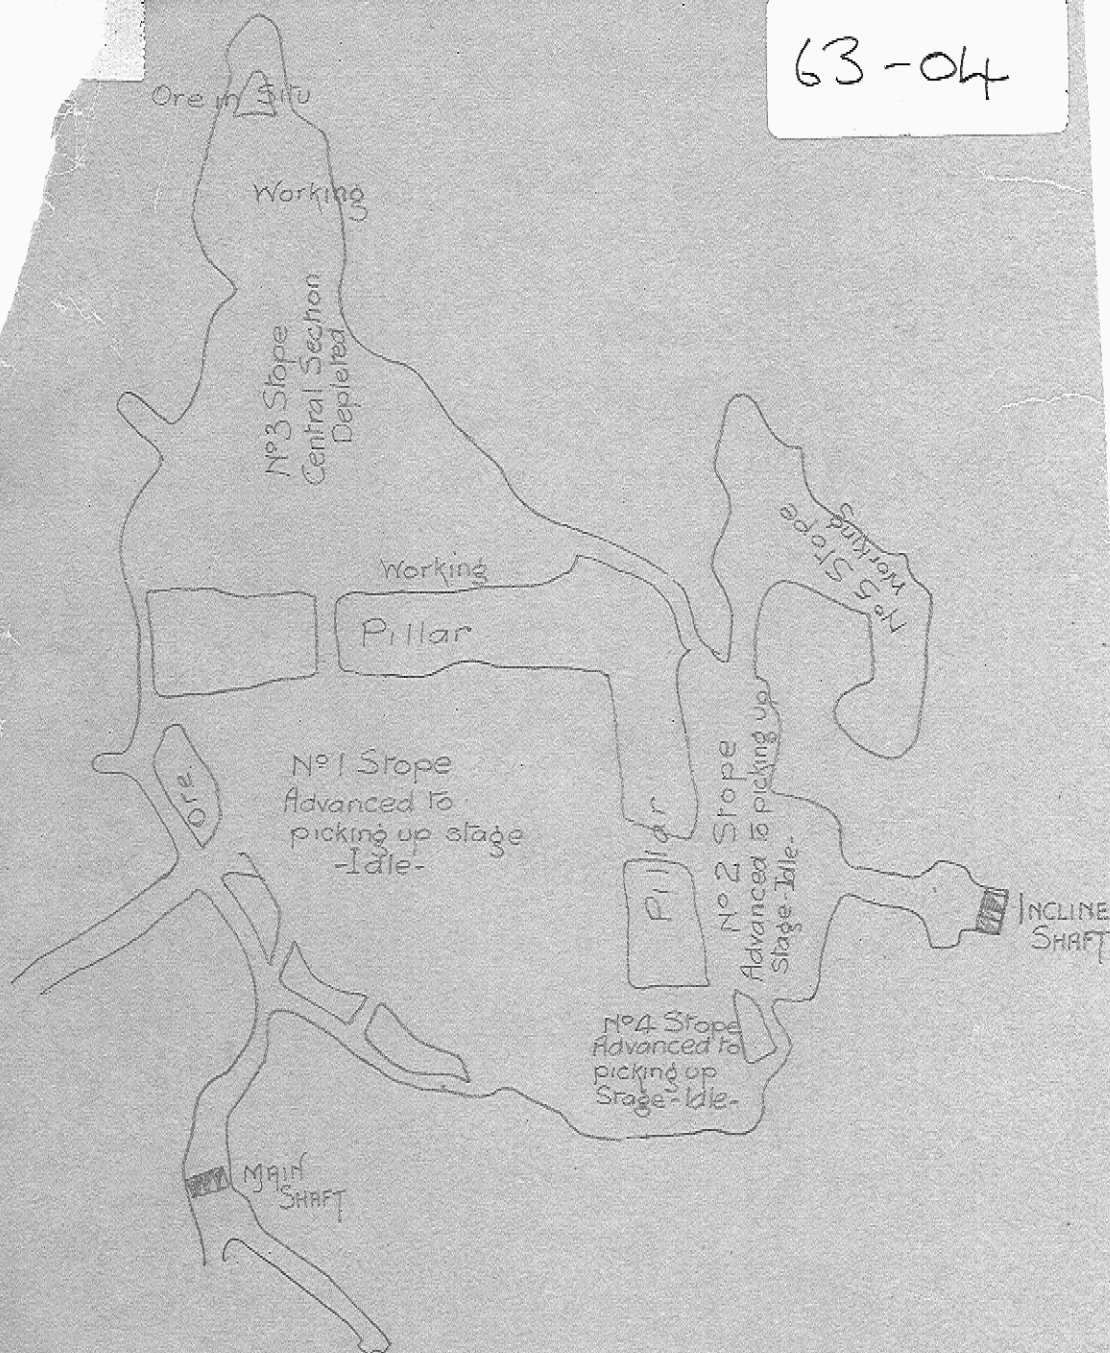

No. 8 Level
Scale 60' = 1"