 


0066-001

0066-001

PLAN
— OF —
— MINE WORKINGS —
— CAPE COPPER COY —
— MT DONALDSON SECTION —

SCALE



Joseph Wilks B.C.E.
 Authorized Surveyor
 Decr 4th 1900



1027
 93 M
 80
 M L


1028
 93 M
 80
 M L

Enlargement of triangulations

(not to scale)

At adit level


At 80ft below

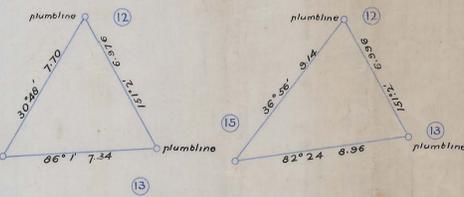

Note! Measts of section boundaries are in links



Section along adit

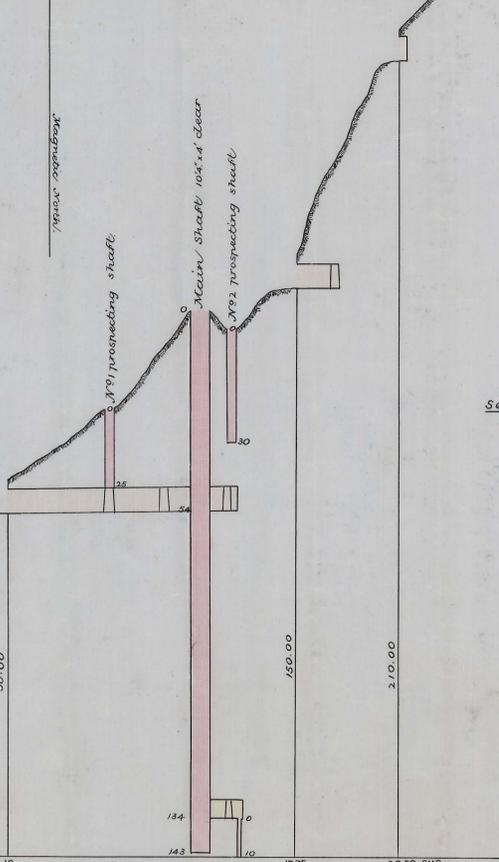

Section from plat of adit along Nos 1, 2 & 3 levels.

Section scales { $\frac{2 \text{ chains horizontal}}{20 \text{ feet vertical}}$ } *to 1 inch*

Approx. position of old level
ADIT