


Copper Mines of M<sup>r</sup> Lyell West L<sup>td</sup>

168/91

250' 00" Datum of Bearings

Prince Lyell M C<sup>o</sup>

1806/91

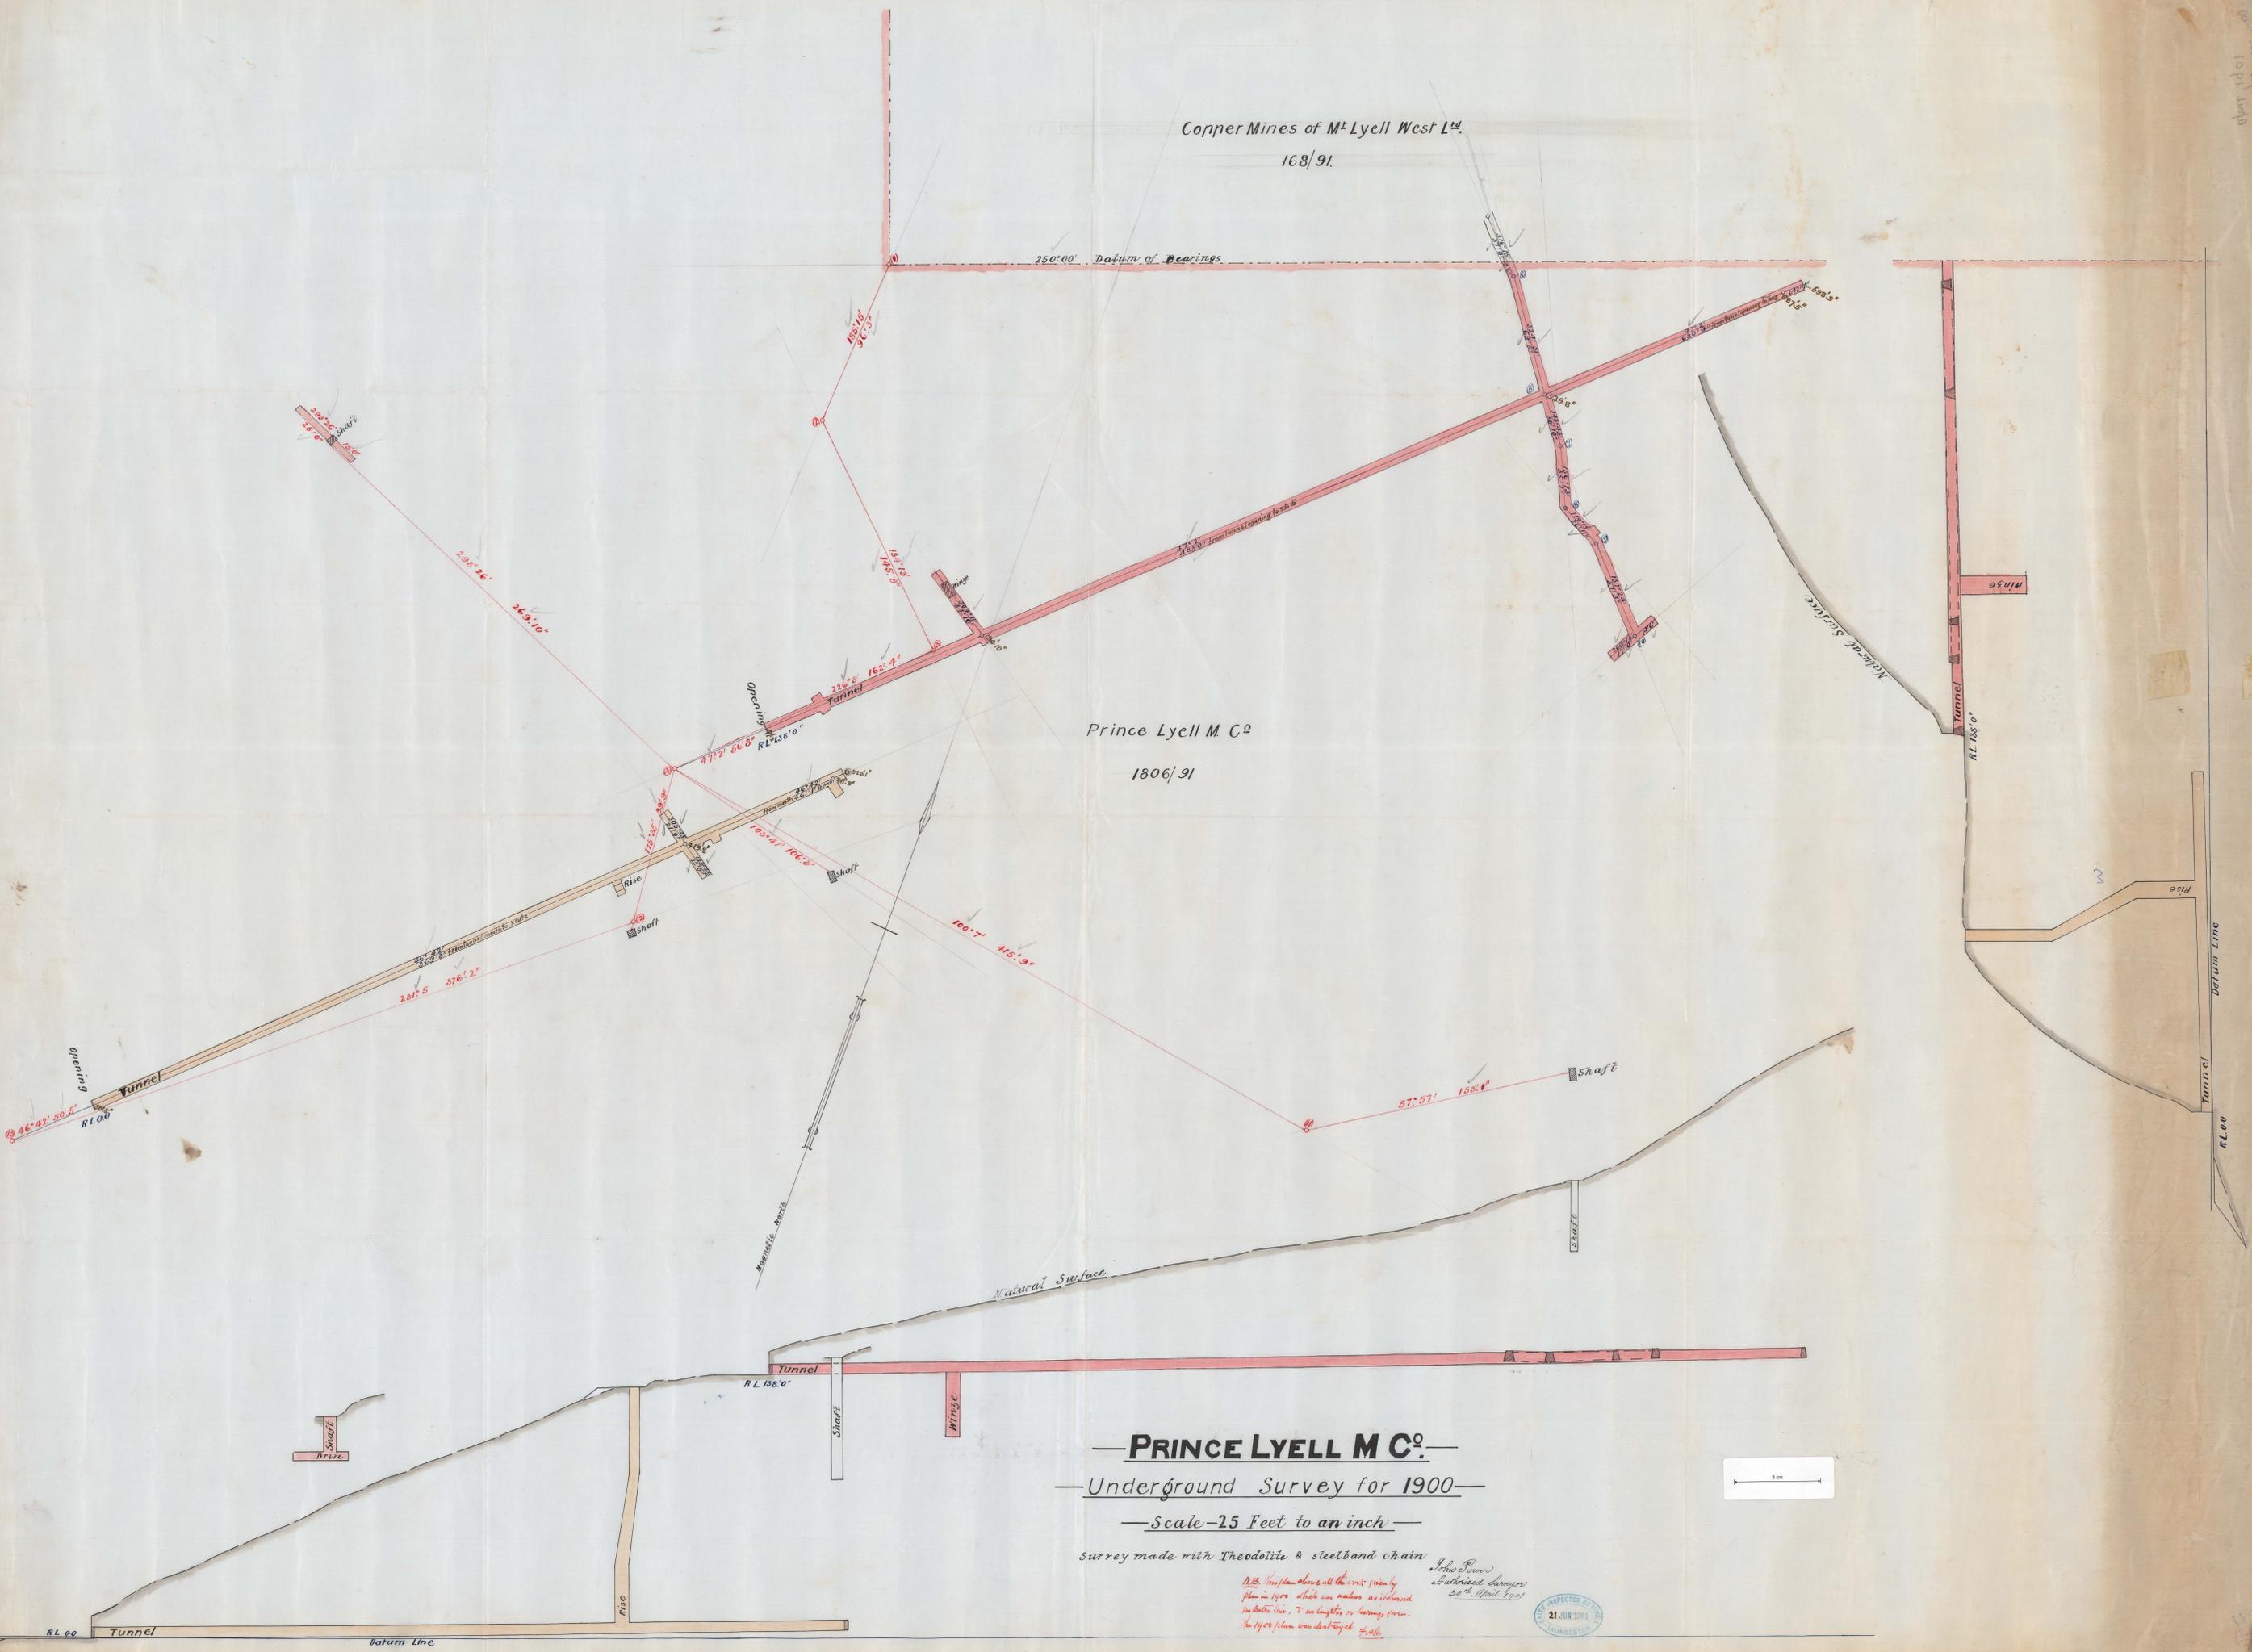

**— PRINCE LYELL M C<sup>o</sup> —**  
 — Underground Survey for 1900 —  
 — Scale — 25 Feet to an inch —

Survey made with Theodolite & steelband chain

*1/25. The plan shows all the work since the plan in 1890 which was made as referred to in the title, & no lengths or bearings were taken since the 1890 plan was destroyed.*

*W. P. (The Surveyor) Subscribed Surveyors 21<sup>st</sup> April 1901*



100-01

3000 ft. 100 ft. 100 ft.