


NORTH M^r Lyell Mining C^os



Underground Survey for 1897

Scale 25 Ft to an inch

Corrected Course
J. J. Muir
Unskilled Surveyor
March 1897.

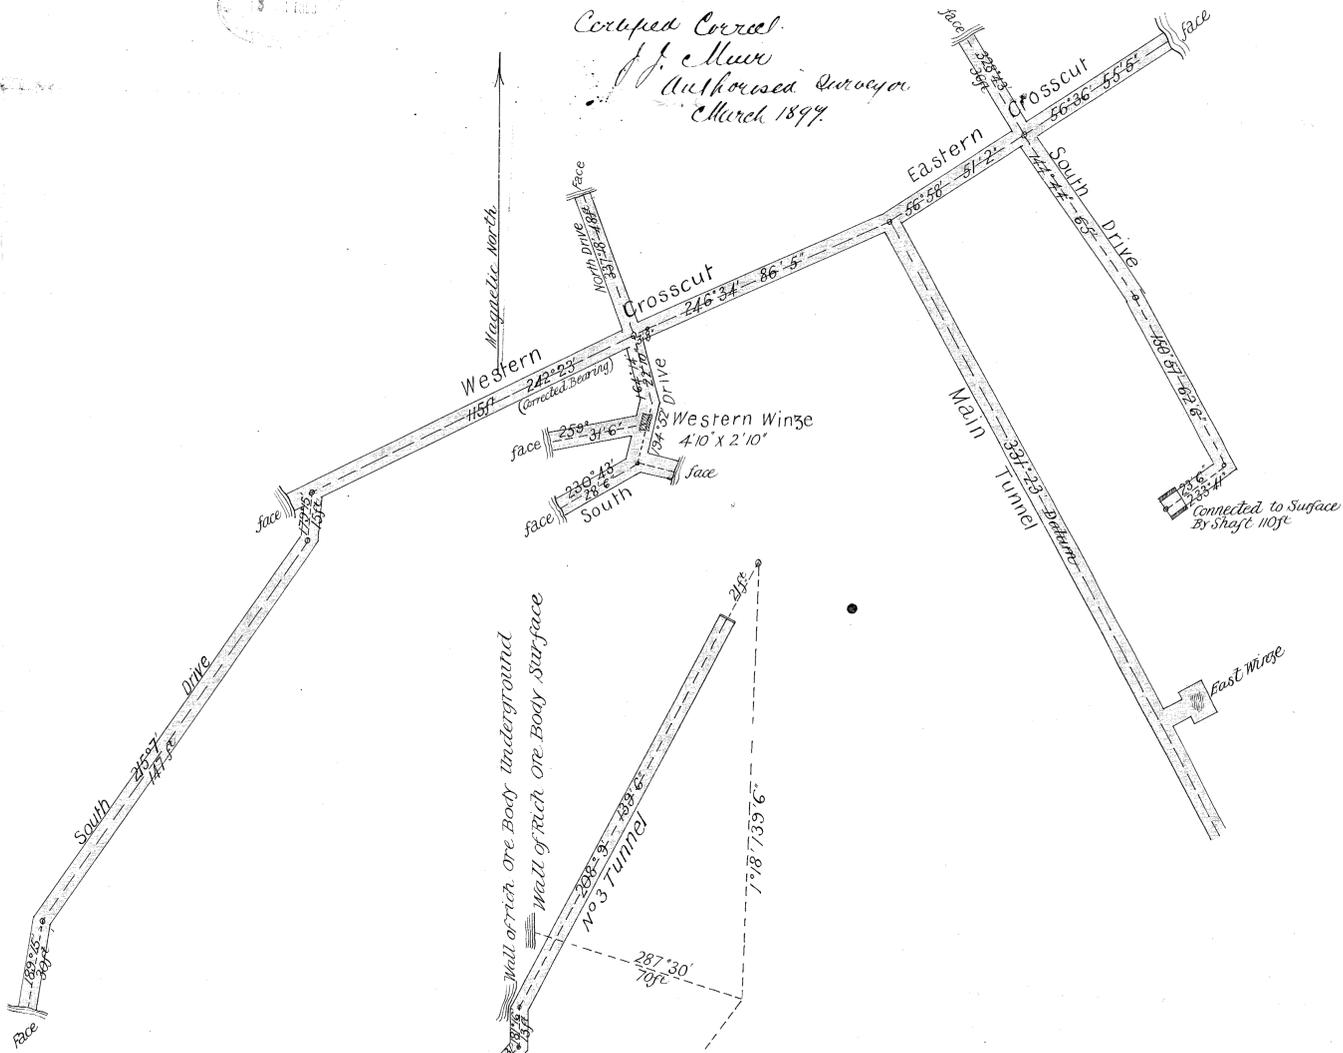

Note The winzes in the main Tunnel have been abandoned for the time being & are full of water. The extensions will therefore have to start over till next year.
J. J. Muir
March 98

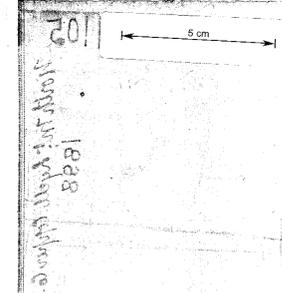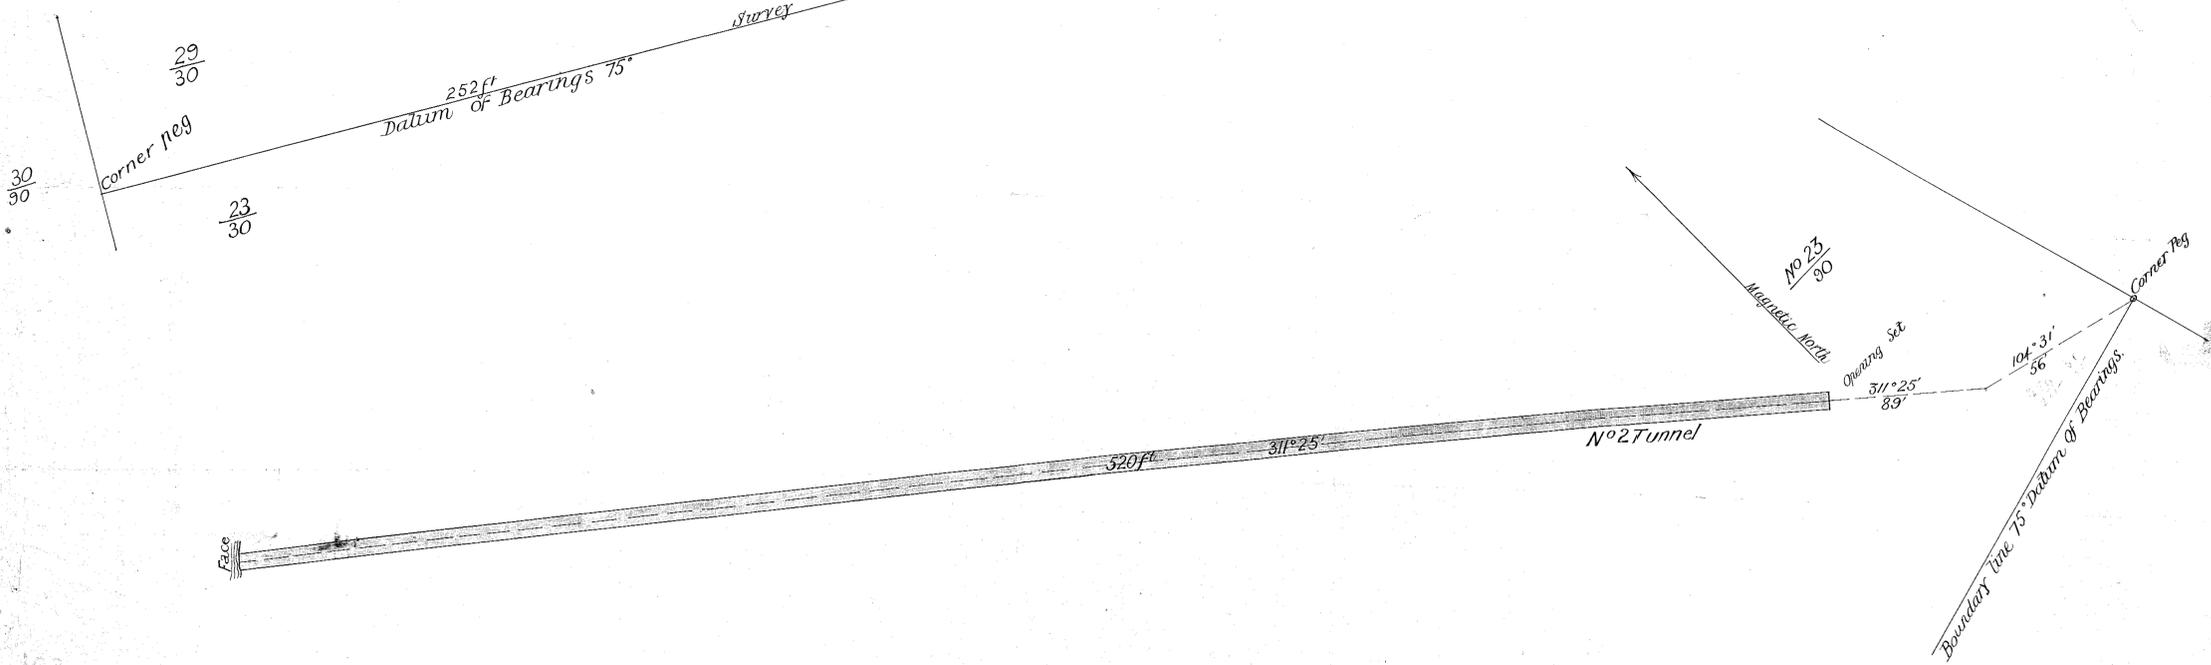

20
1888
North M^r Lyell Mining C^os