


5 cm

NORTH M^r Lyell Mining Coy

Underground Extension for 1896

Scale 25 Ft to an inch

6/1/97

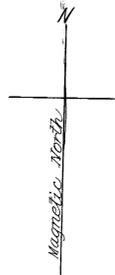

Official Survey

J. J. Muir


I Certify This Plan Correct

Authorised Surveyor


M^r Lyell Jan. 1897

Vertical Sections




Western Winze

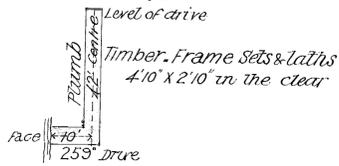

Shaft on Surface

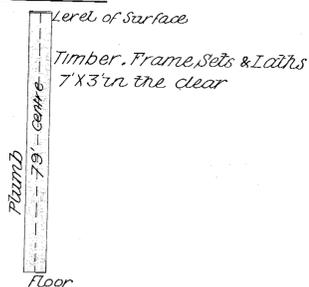


Eastern Winze

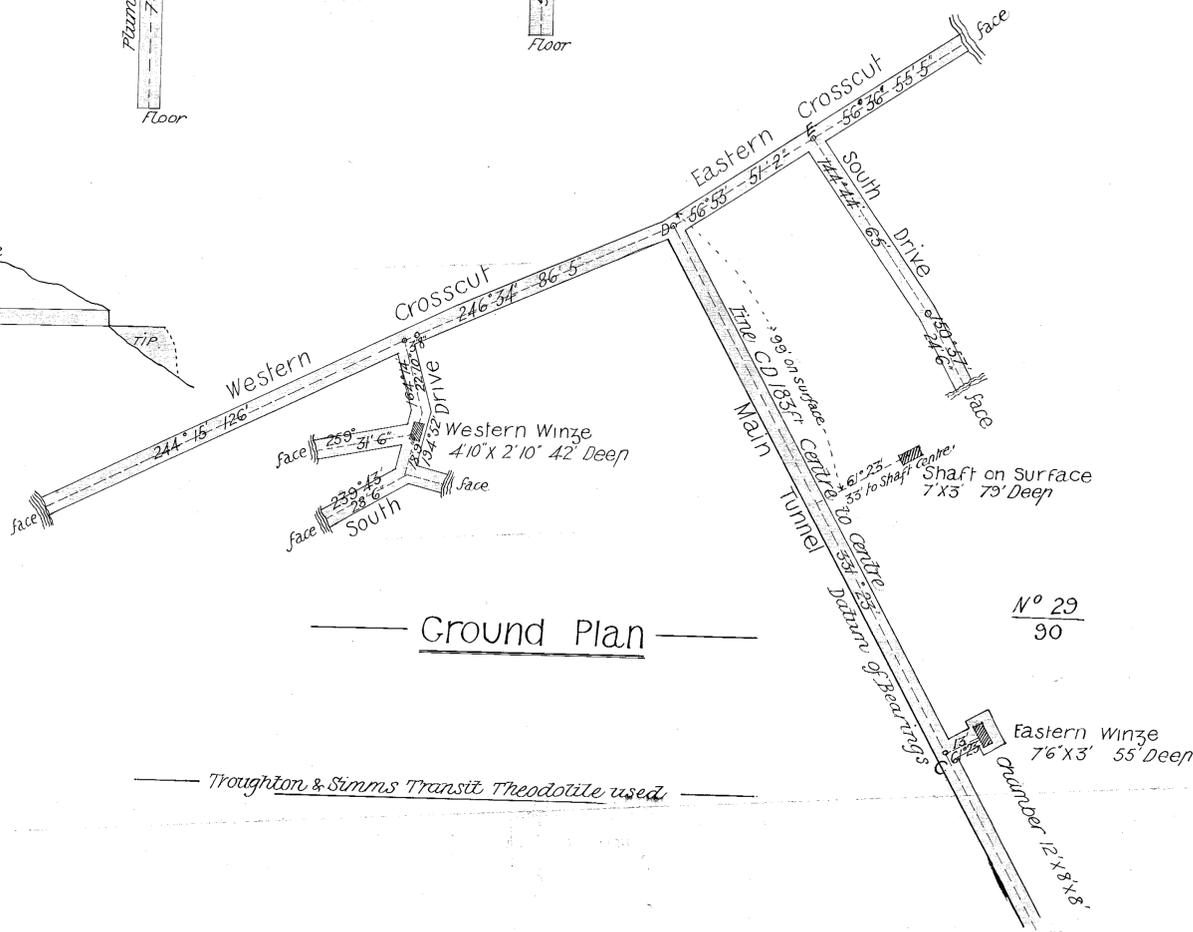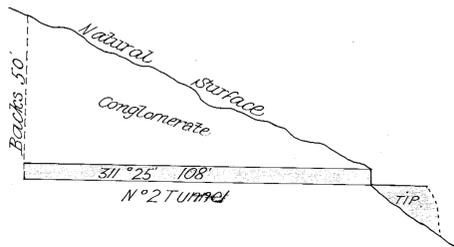
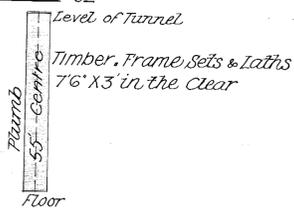


Ground Plan

Troughton & Simms Transit Theodolite used

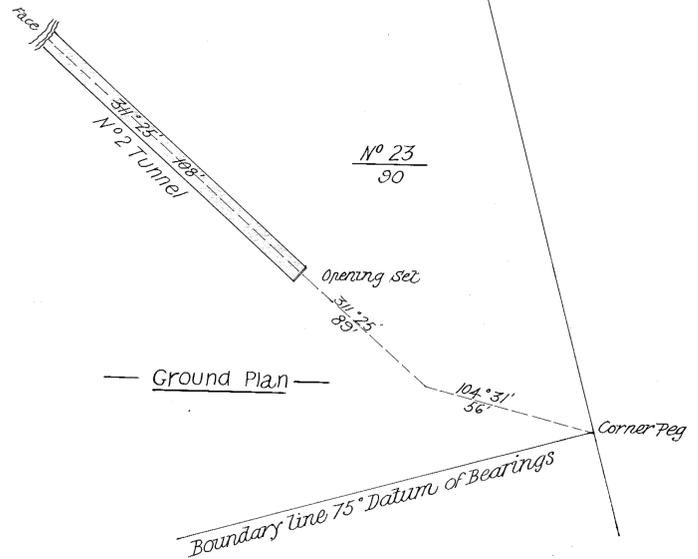

Ground Plan

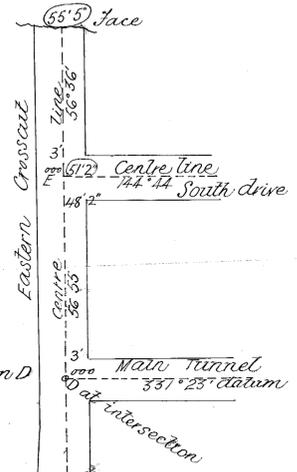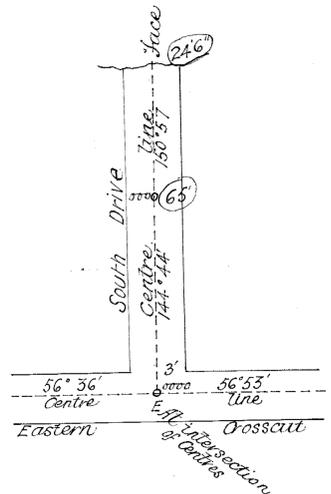

Field Notes