

5 cm


101-03

# NORTH M<sup>T</sup> LYELL

## Mining Company

Extension of last years Underground Survey

Scale 20 Feet to one Inch


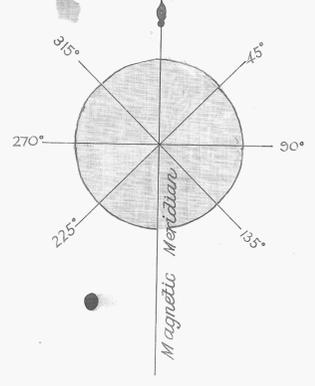


I effected this Survey & certify this Plan Correct

*J. J. Hill*  
Civil Engineer & Authorised Surveyor  
M<sup>t</sup> Lyell Jan<sup>y</sup> 1896

Last Year's Survey, Brown  
 This Year's Extension Survey, Blue

F. Mansel 1896

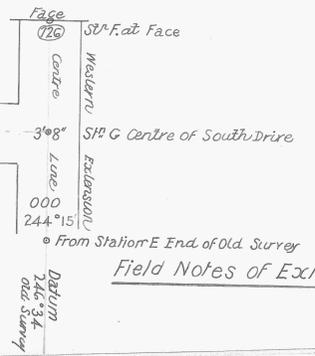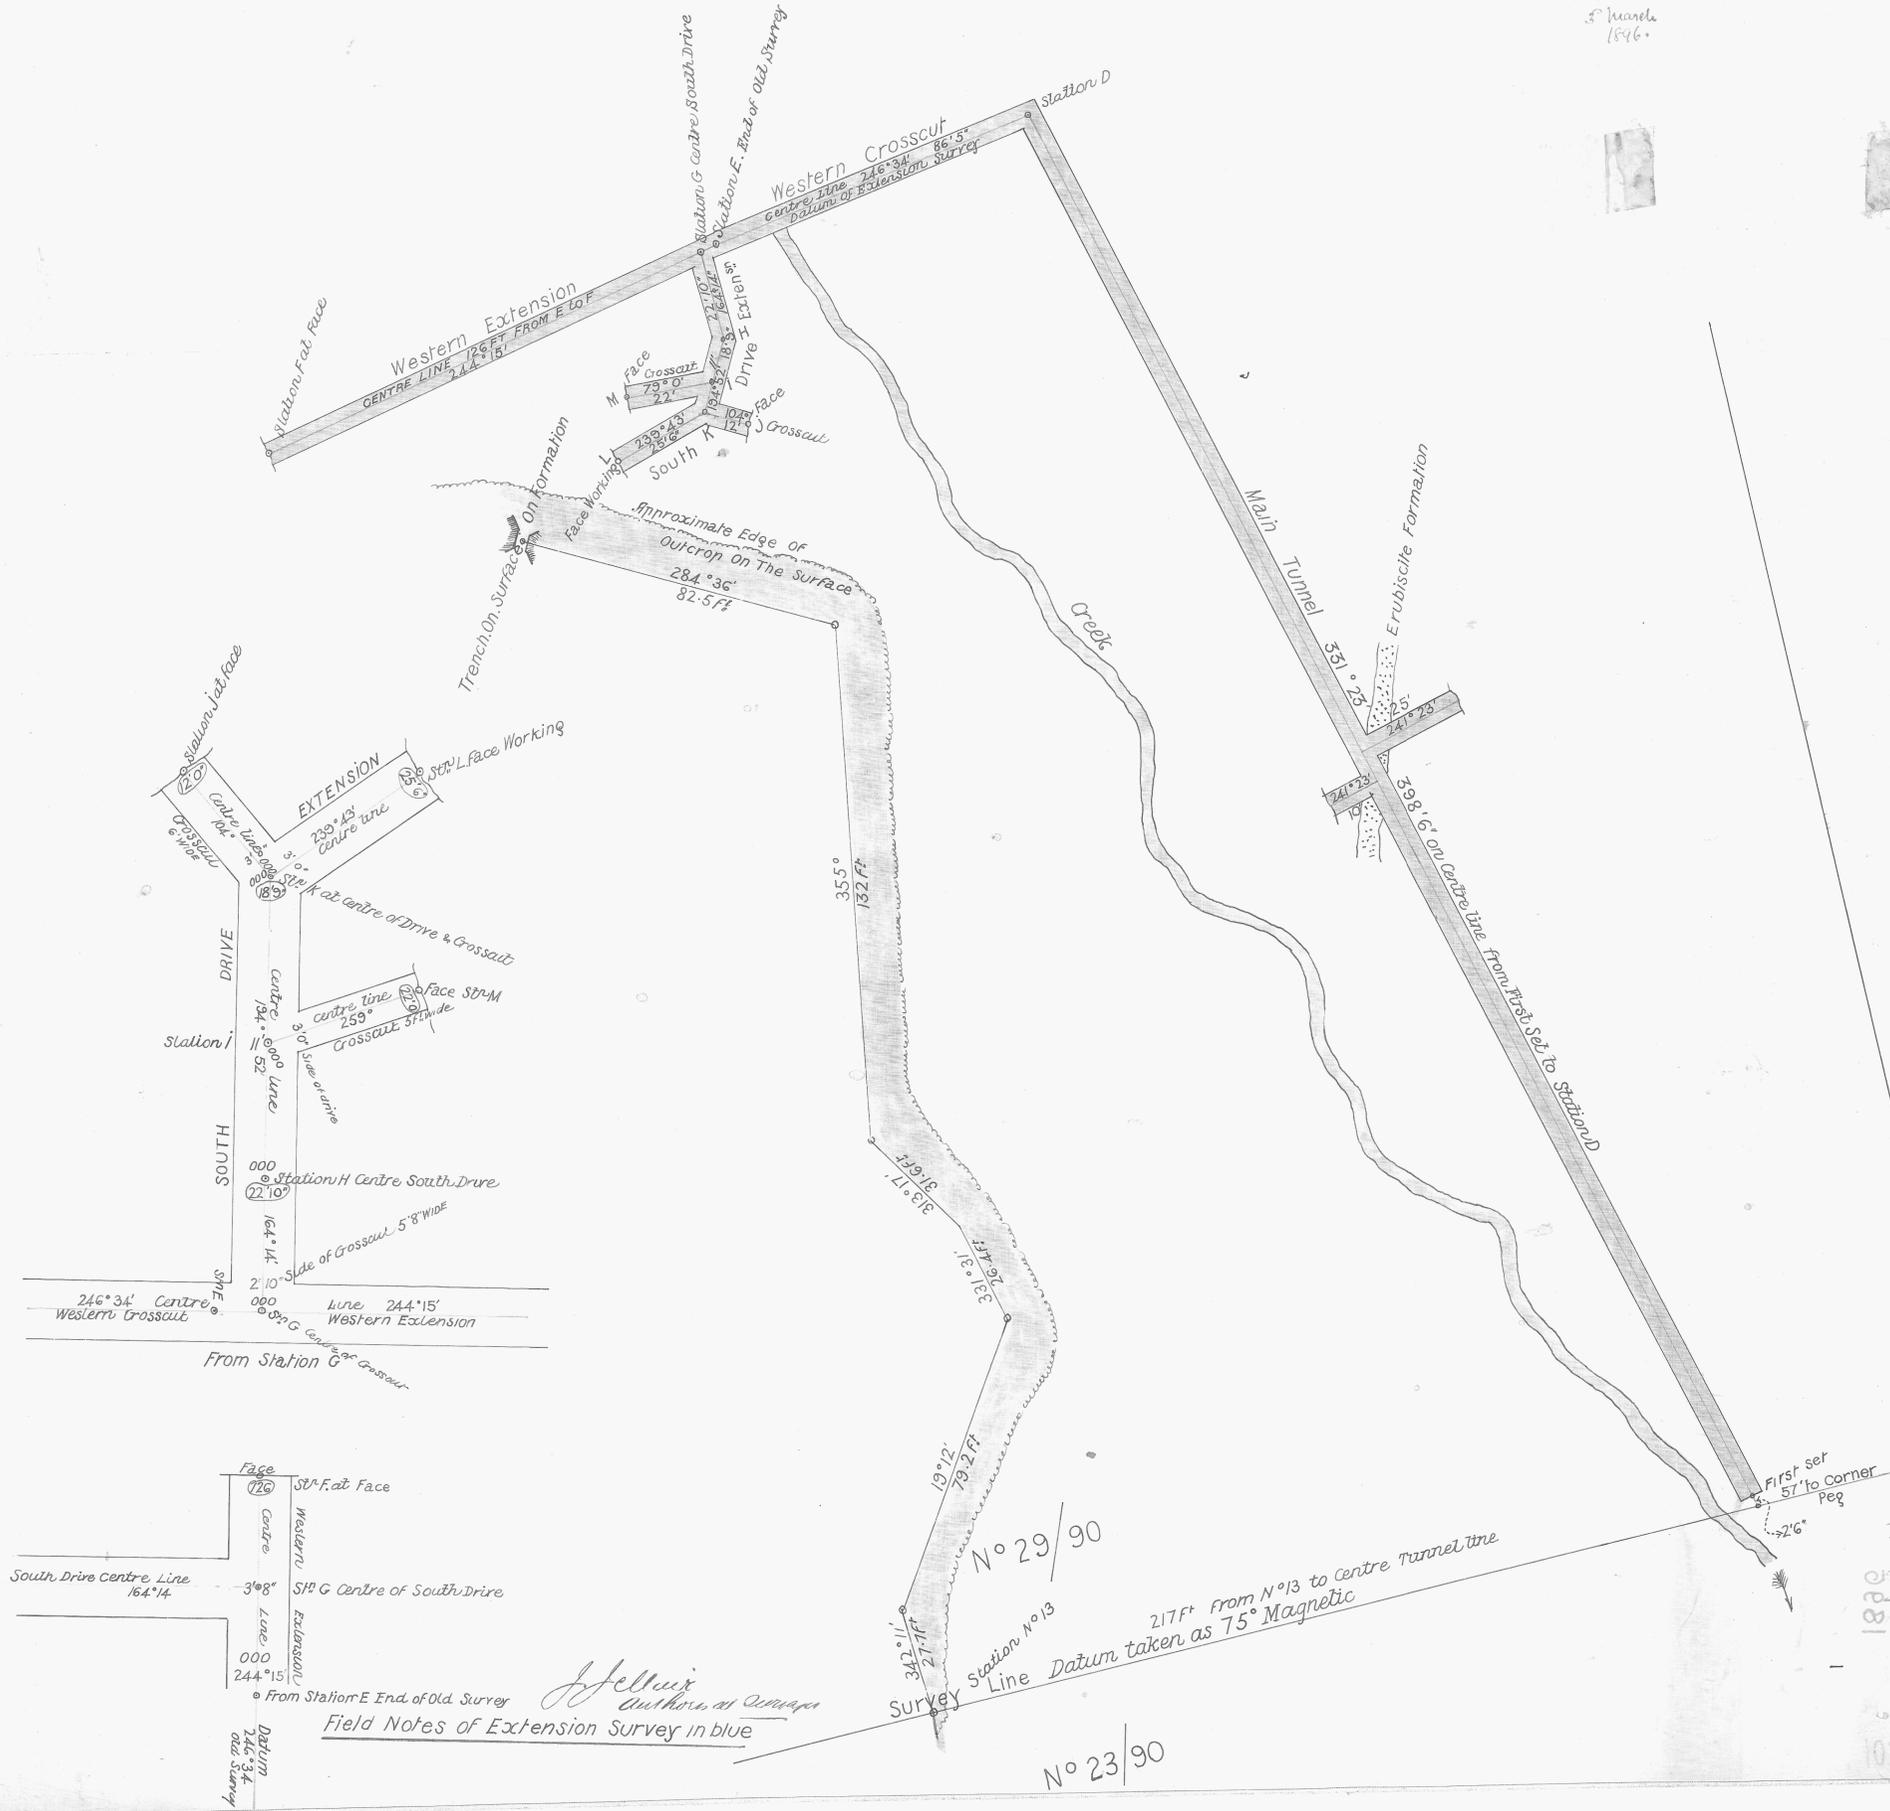

*J. J. Hill*  
 Authorised Surveyor  
 Field Notes of Extension Survey in blue

N<sup>o</sup> 29/90

217F<sup>t</sup> From N<sup>o</sup> 13 to Centre Tunnel line  
Line Datum taken as 75° Magnetic

N<sup>o</sup> 23/90

1881  
Survey M<sup>t</sup> Lyell Colours