

101-04

1001
133

1001
101-04
5 cm

NORTH M^T LYELL COPPER CO. L^{TD}

Underground Survey For 1899


Scale - 25 feet to 1 Inch

*John P. ...
22 Feb. 1900
all Bearings taken
with 5" theodolite
J.P.*

TASMAN LYELL M. CO.

CROWN LYELL M. CO.

MT LYELL BLOCKS M. CO.

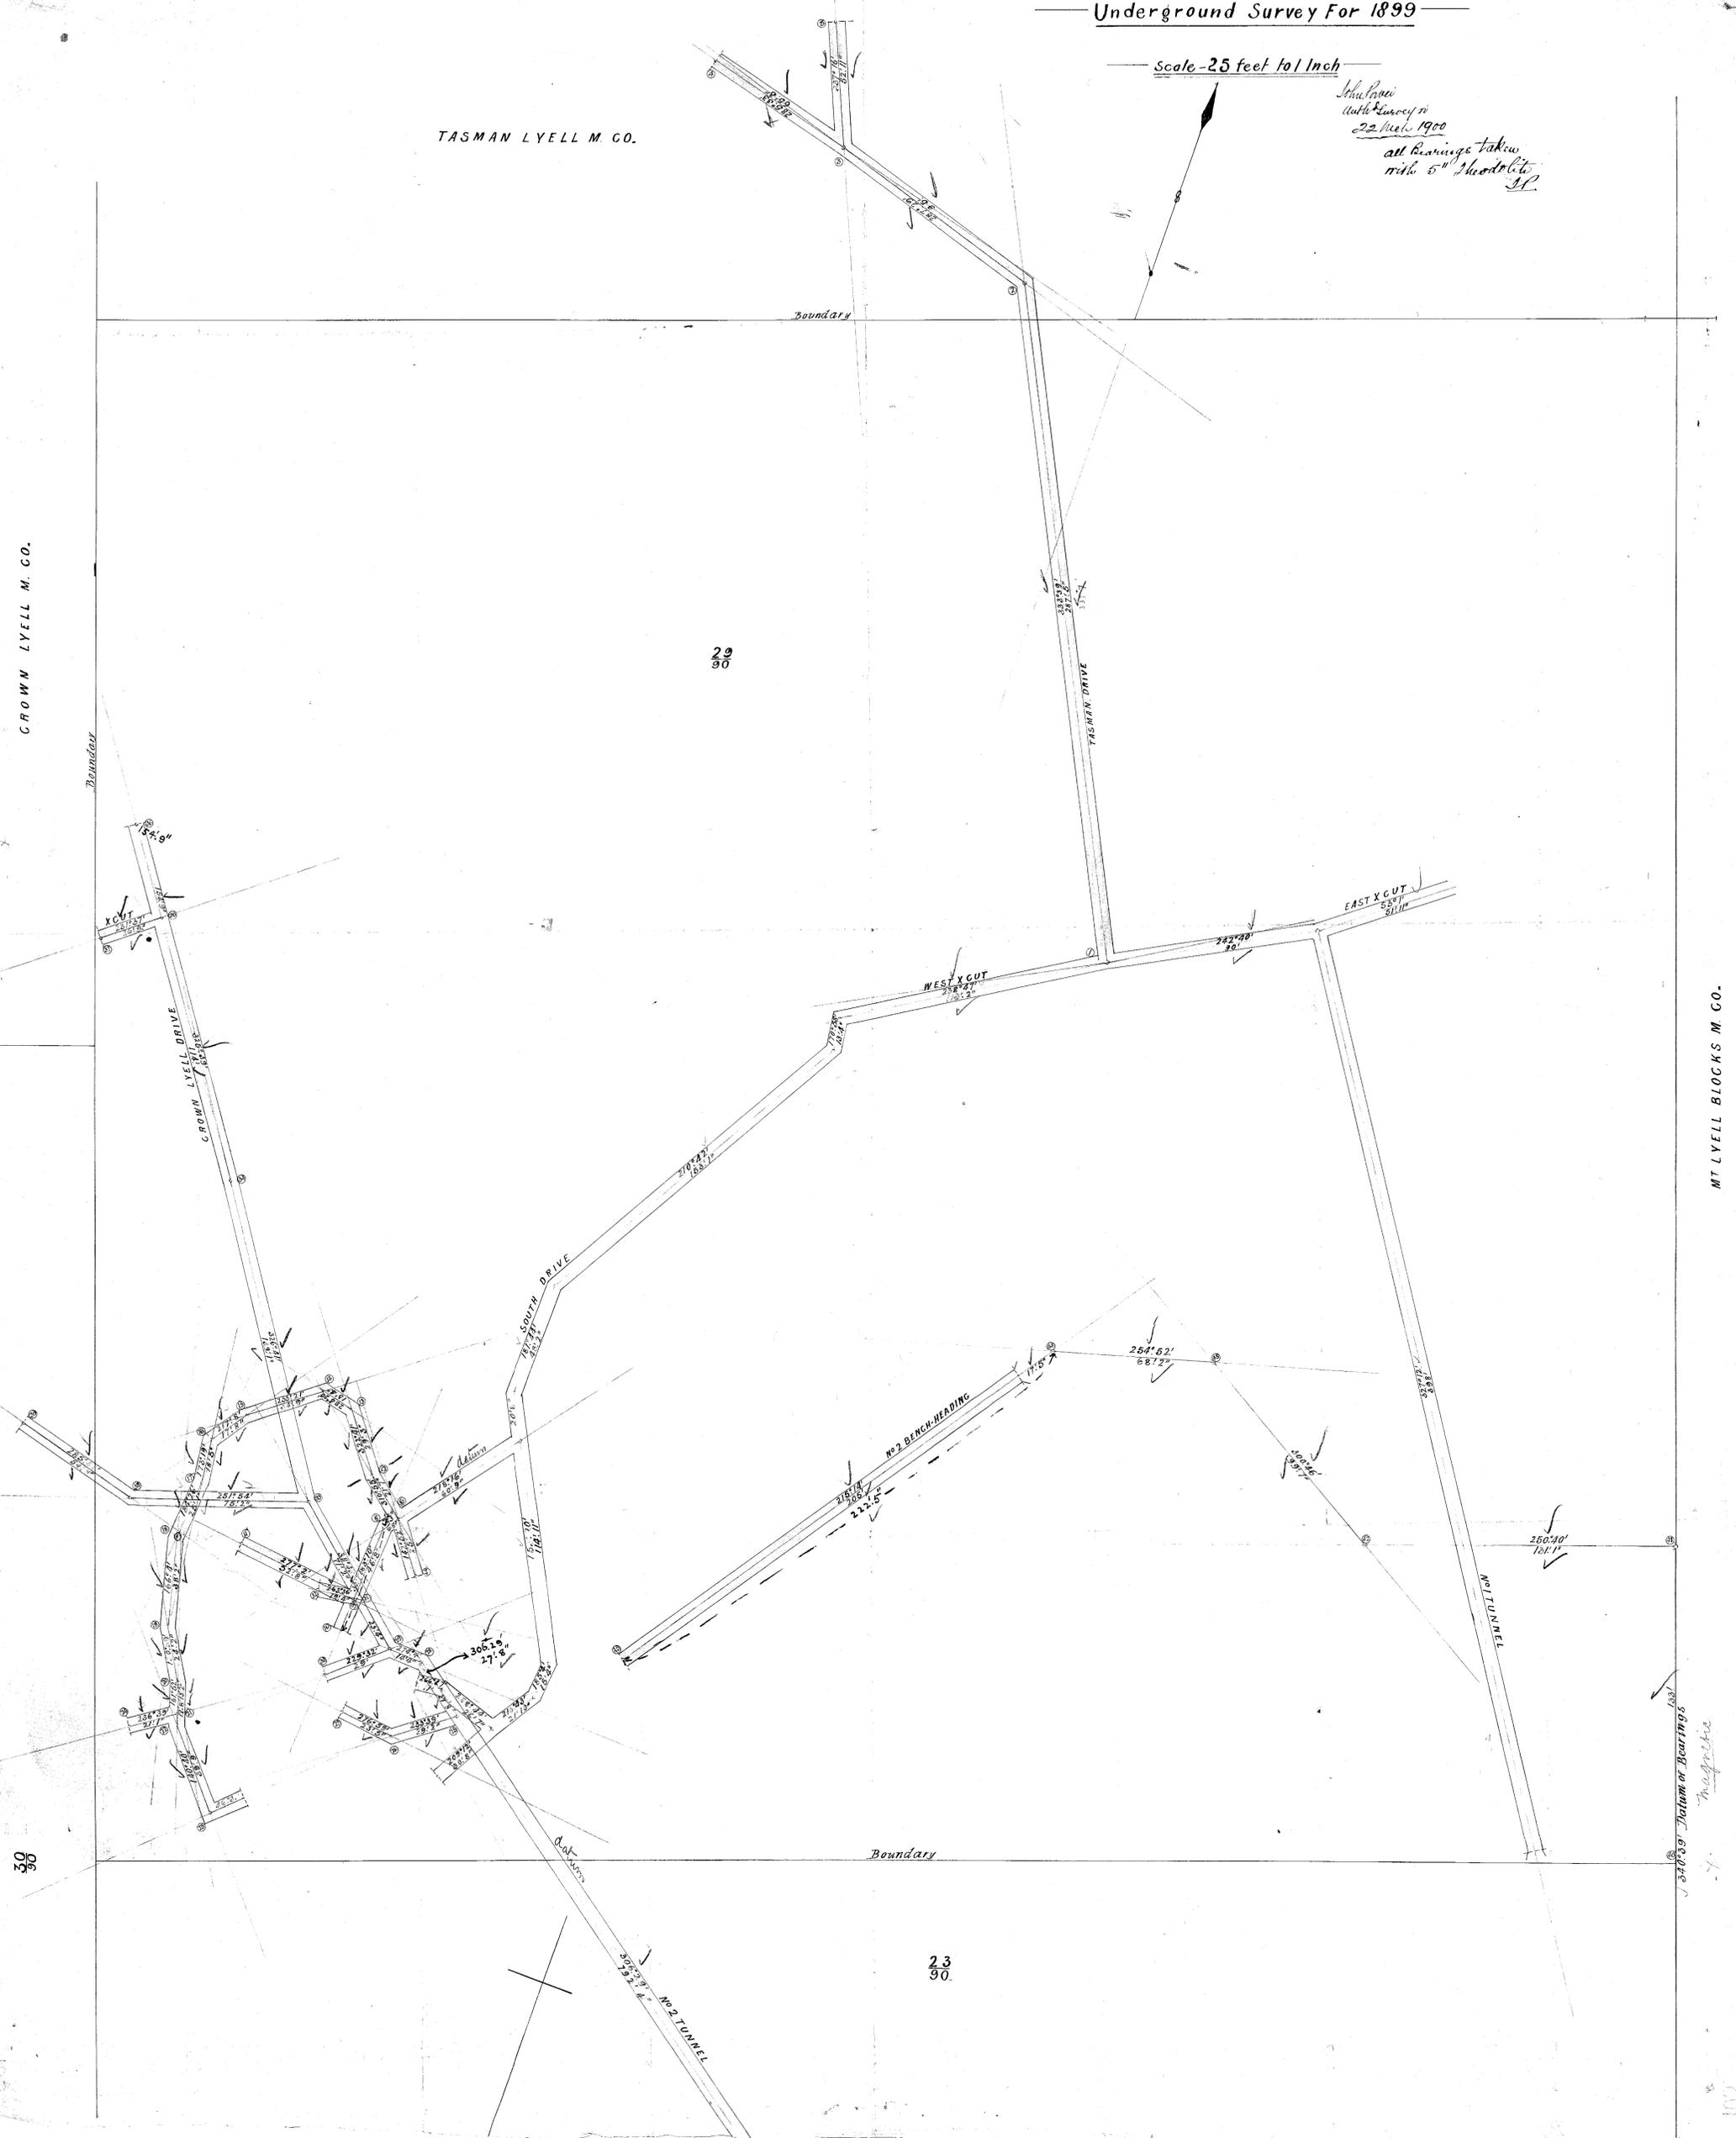

*John P. ...
theodolite*

1001

102