

NORTH MOUNT LYELL M^c C^o

Underground Survey 1898

25 Feet to an Inch

February 1898


J. J. Collins
Surveyor
Feb. 99

101-05

CROWN LYELL




NORTH MOUNT LYELL

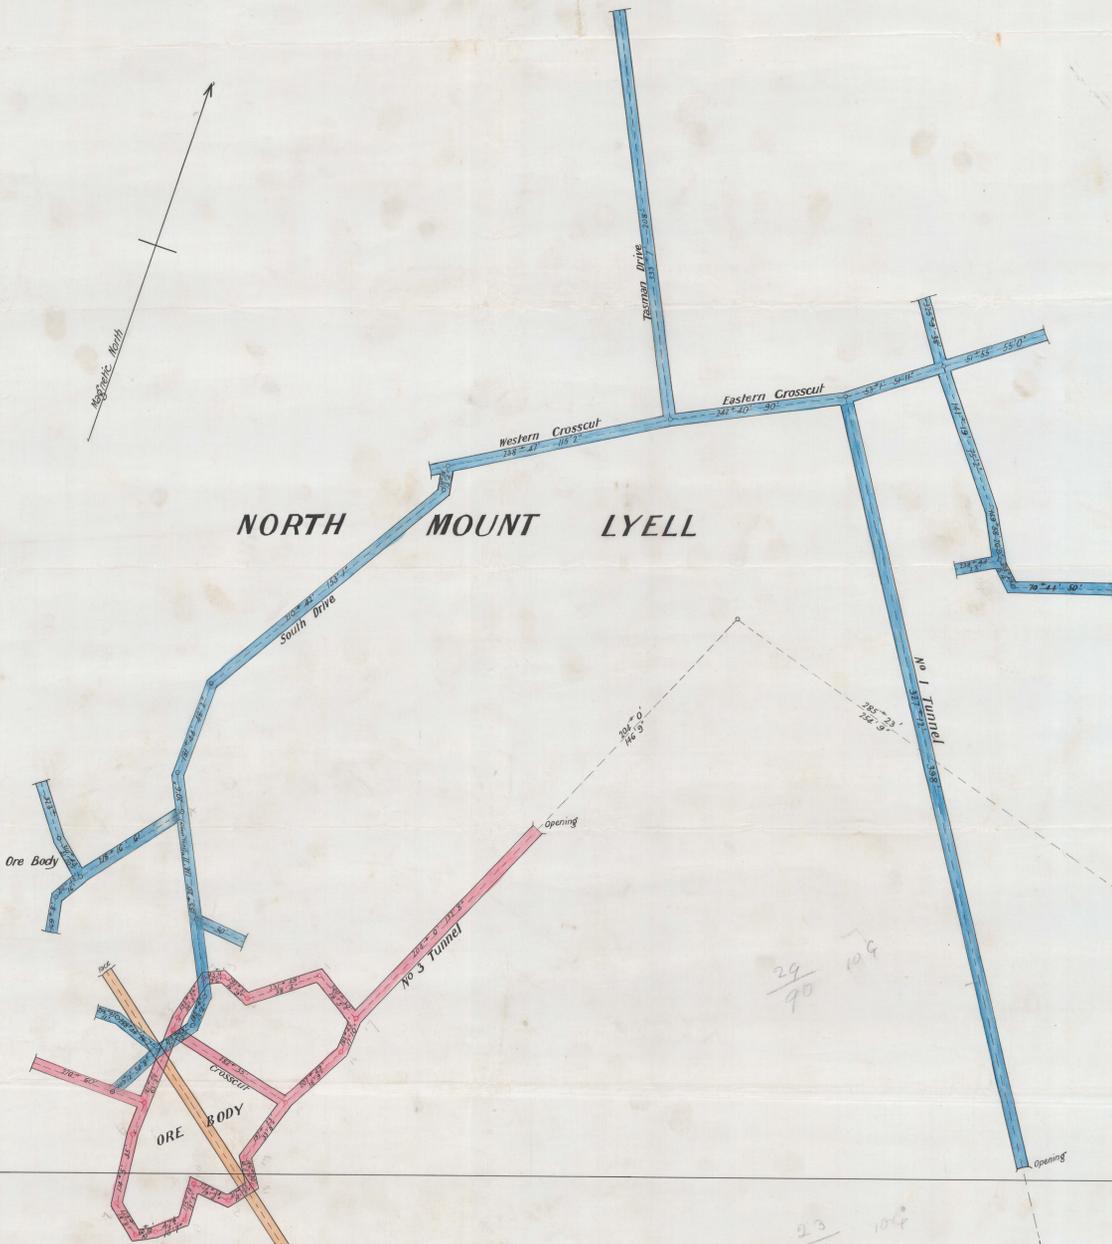

Nth MOUNT LYELL

30
90

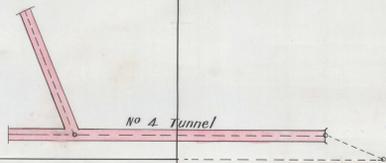

NORTH MOUNT LYELL

LYELL THARSIS

MOUNT LYELL BLOCKS