



5 cm

101-06
Nth Lyell
pp 81-82

NTH M^T LYELL CONSOLIDATED M^C C^O
Underground Survey For 1898
— 25 Feet to an Inch —

February 1898
J. J. Mearns
Underground Survey
Feb. 99

M^T LYELL RESERVE M^C C^O

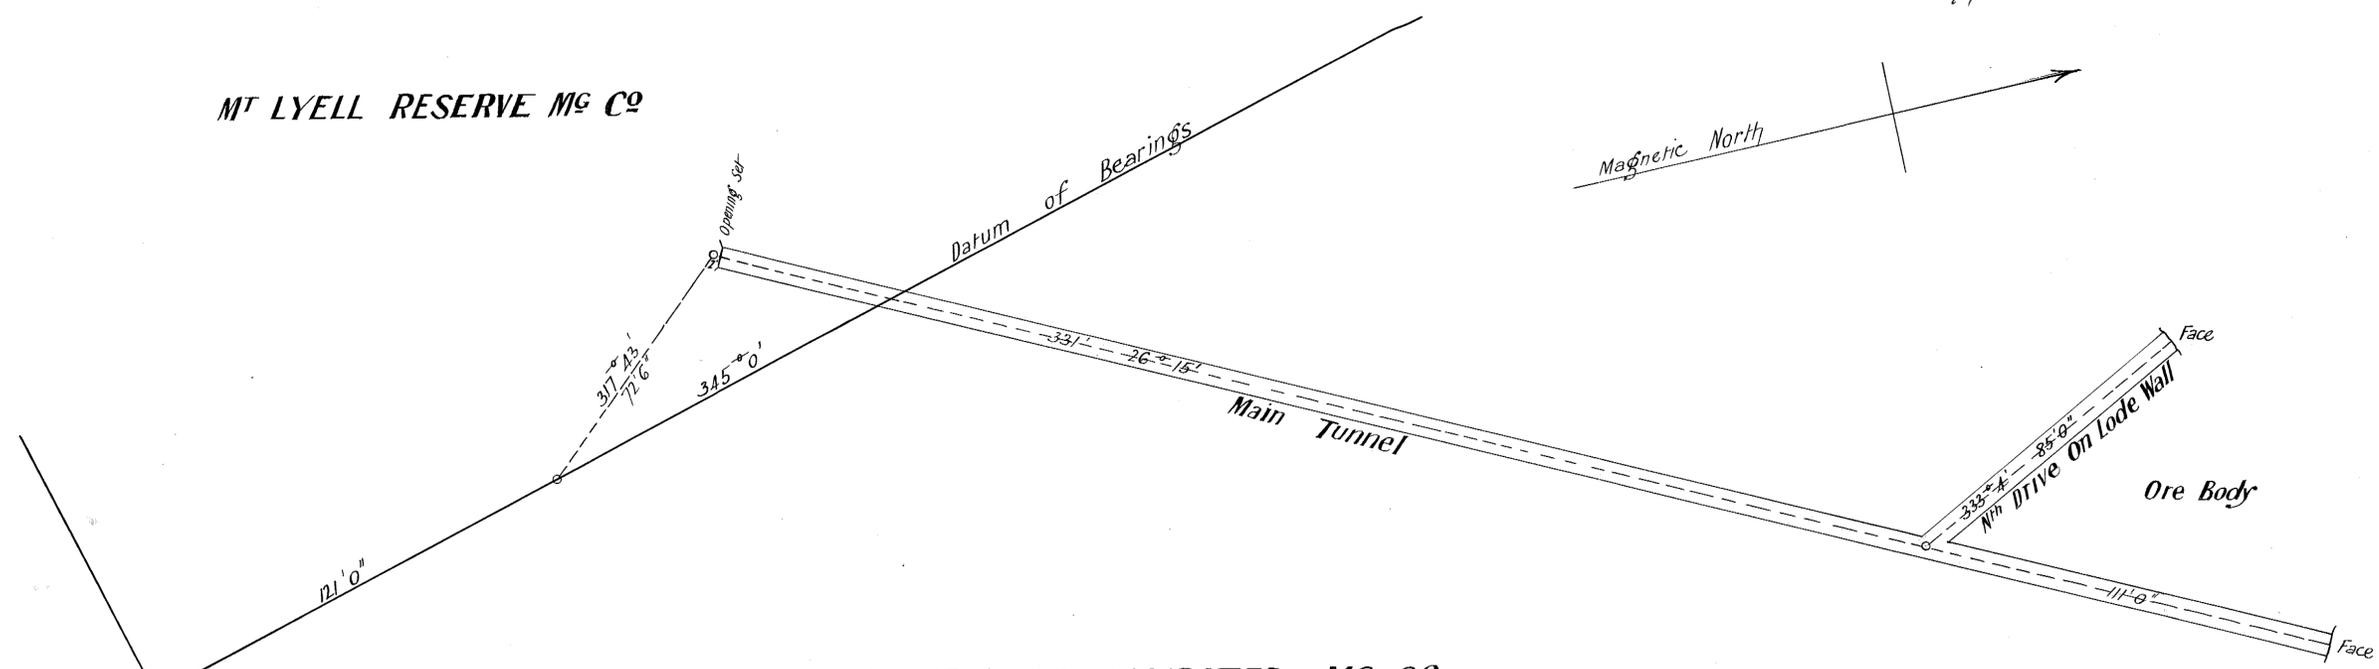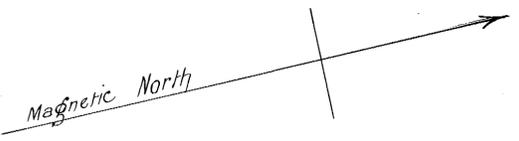

Nth LYELL CONSOLIDATED M^C. C^O

$\frac{2140}{91}$

ROYAL THARSIS

$\frac{935}{93}$

