


NORTH M^T LYELL

Underground Survey & Surface Levels

Horizontal & Vertical Scale 40F^t to an Inch

(See footnote re Scale)

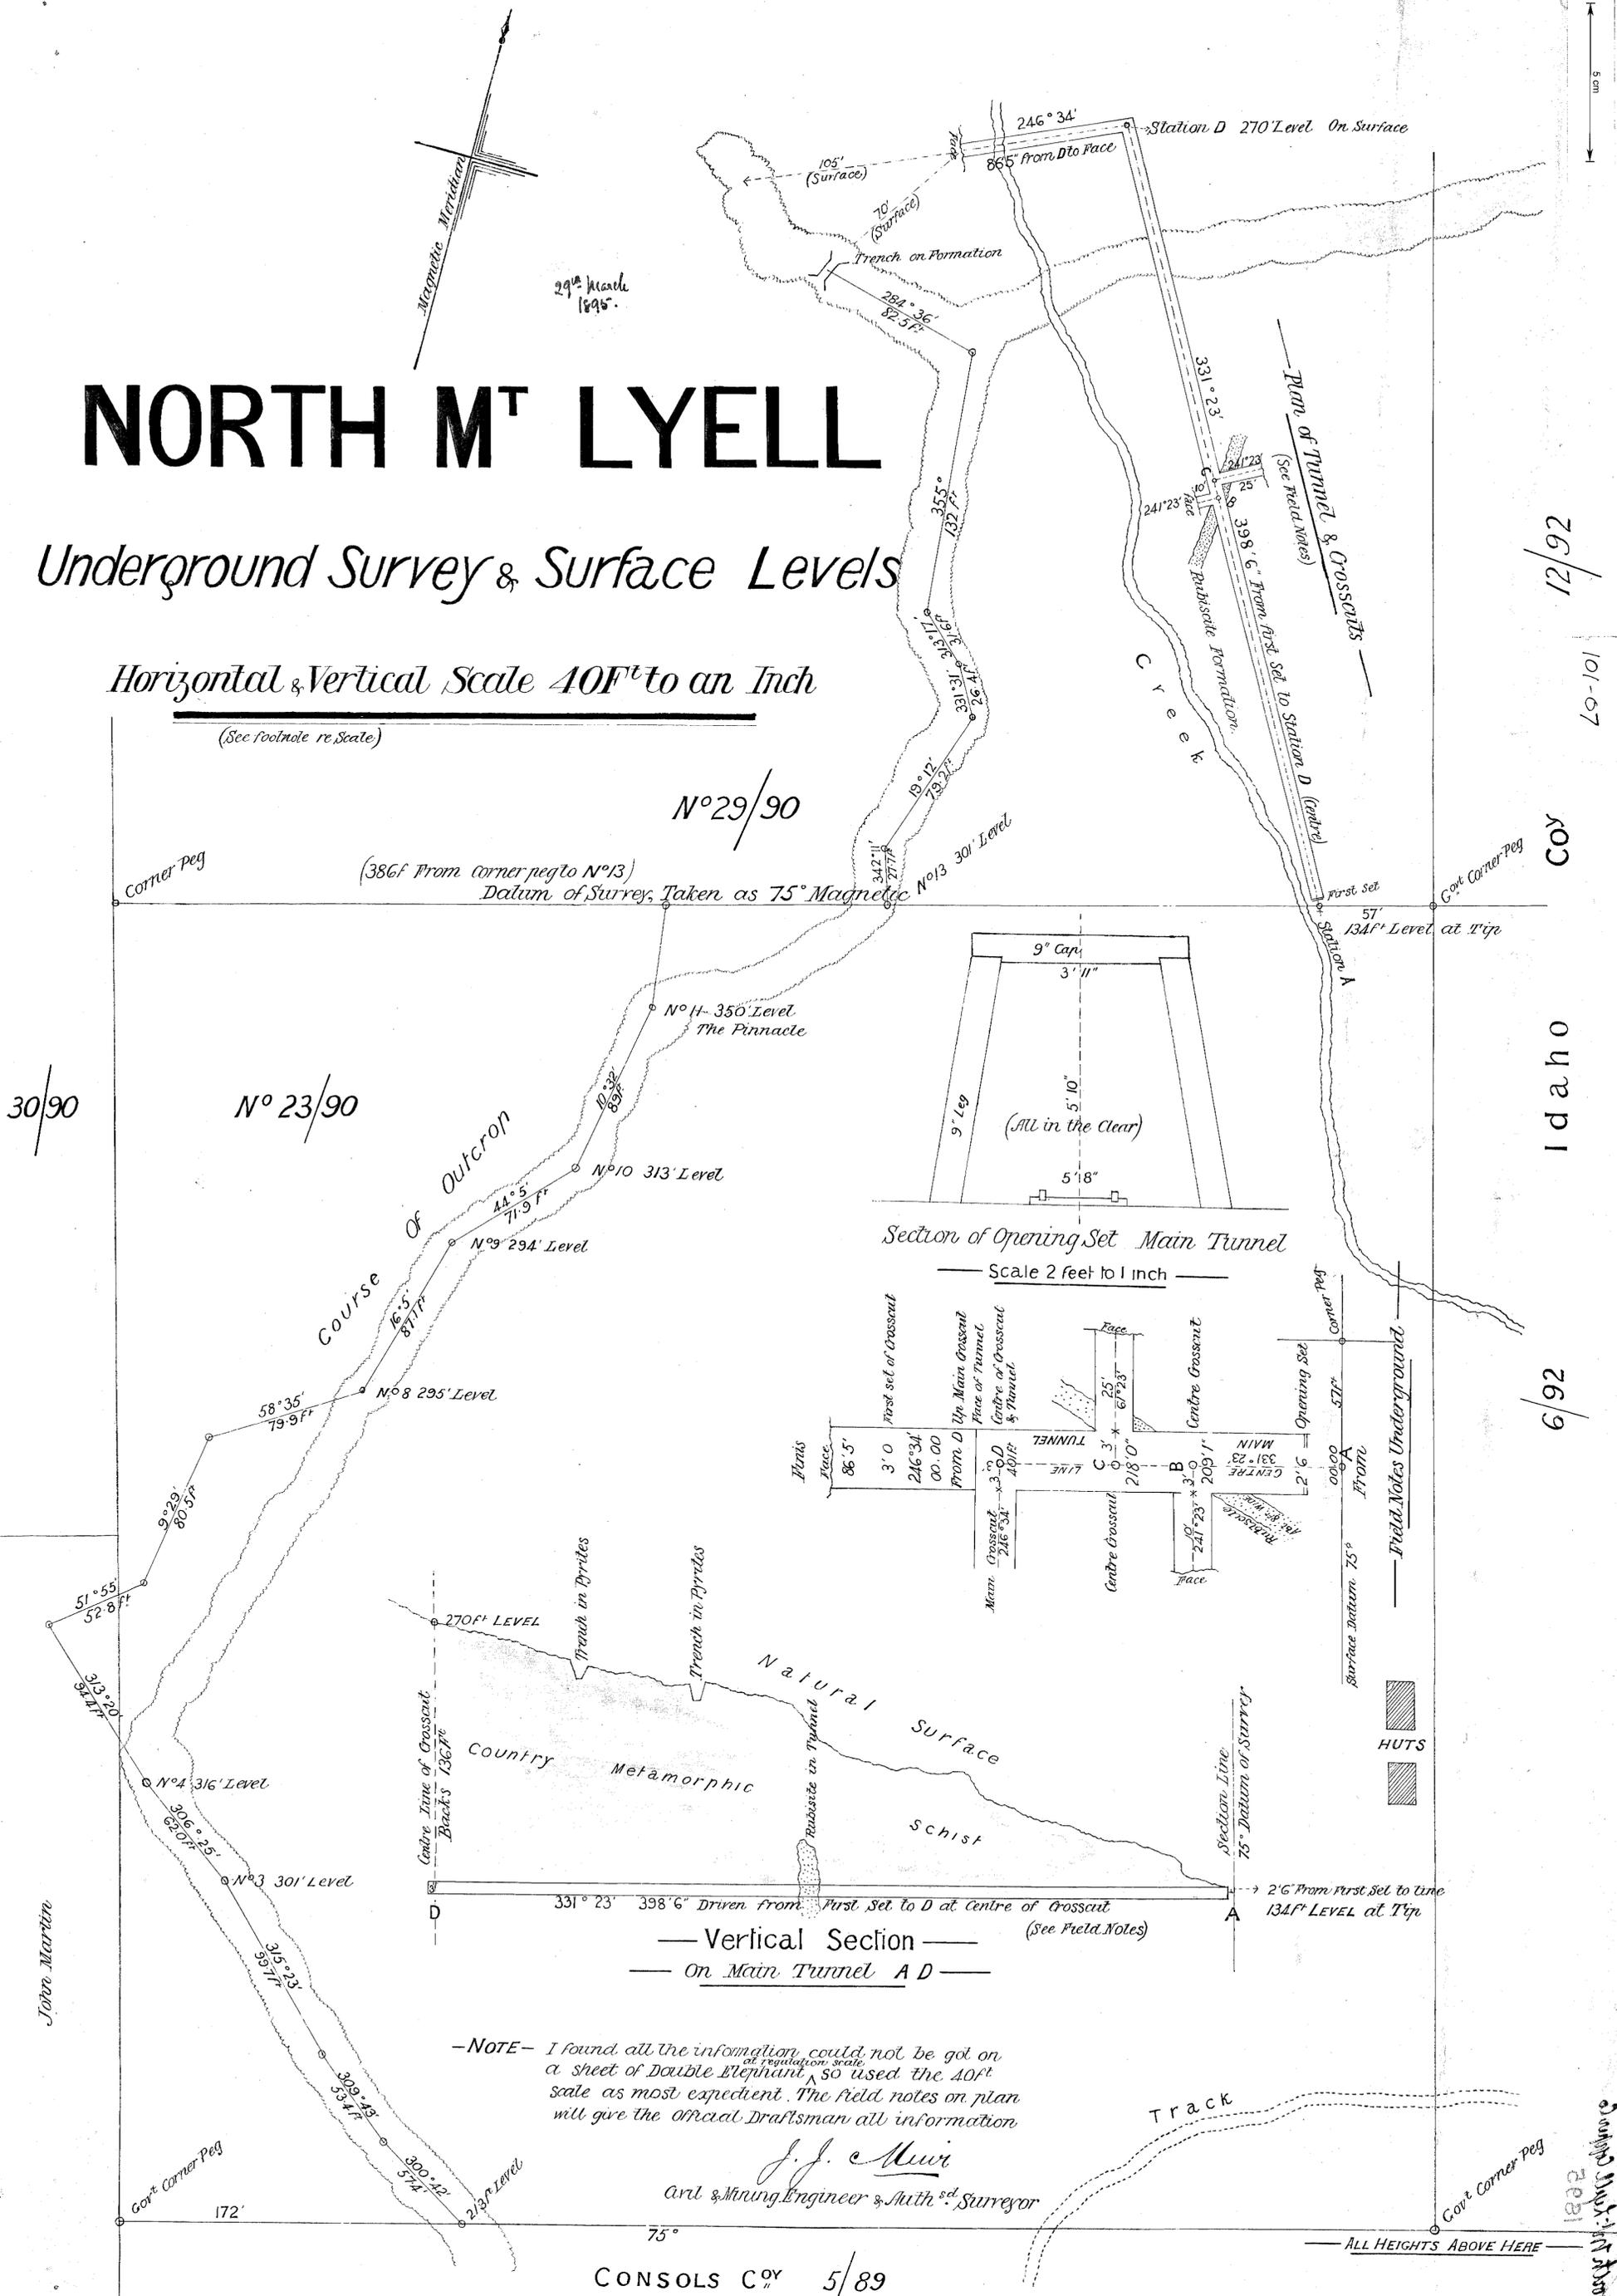

-NOTE- I found all the information could not be got on a sheet of Double Elephant, so used the 40F^t scale as most expedient. The field notes on plan will give the official Draftsman all information

J. J. Mui
Civil & Mining Engineer & Auth^d Surveyor

CONSOLS C^Y 5/89

12/92

101-67

COY

Idaho

6/92

101-07

1882
J. J. Mui

102

ALL HEIGHTS ABOVE HERE