

NORTH M^r LYELL COPPER CO. L^{TD}.

Underground Survey For 1900


Scale—25 Feet to 1 Inch

Survey made with Theodolite & Steelband chain

John Power
Aust. Surveyor
28 Feb 1901



101-08

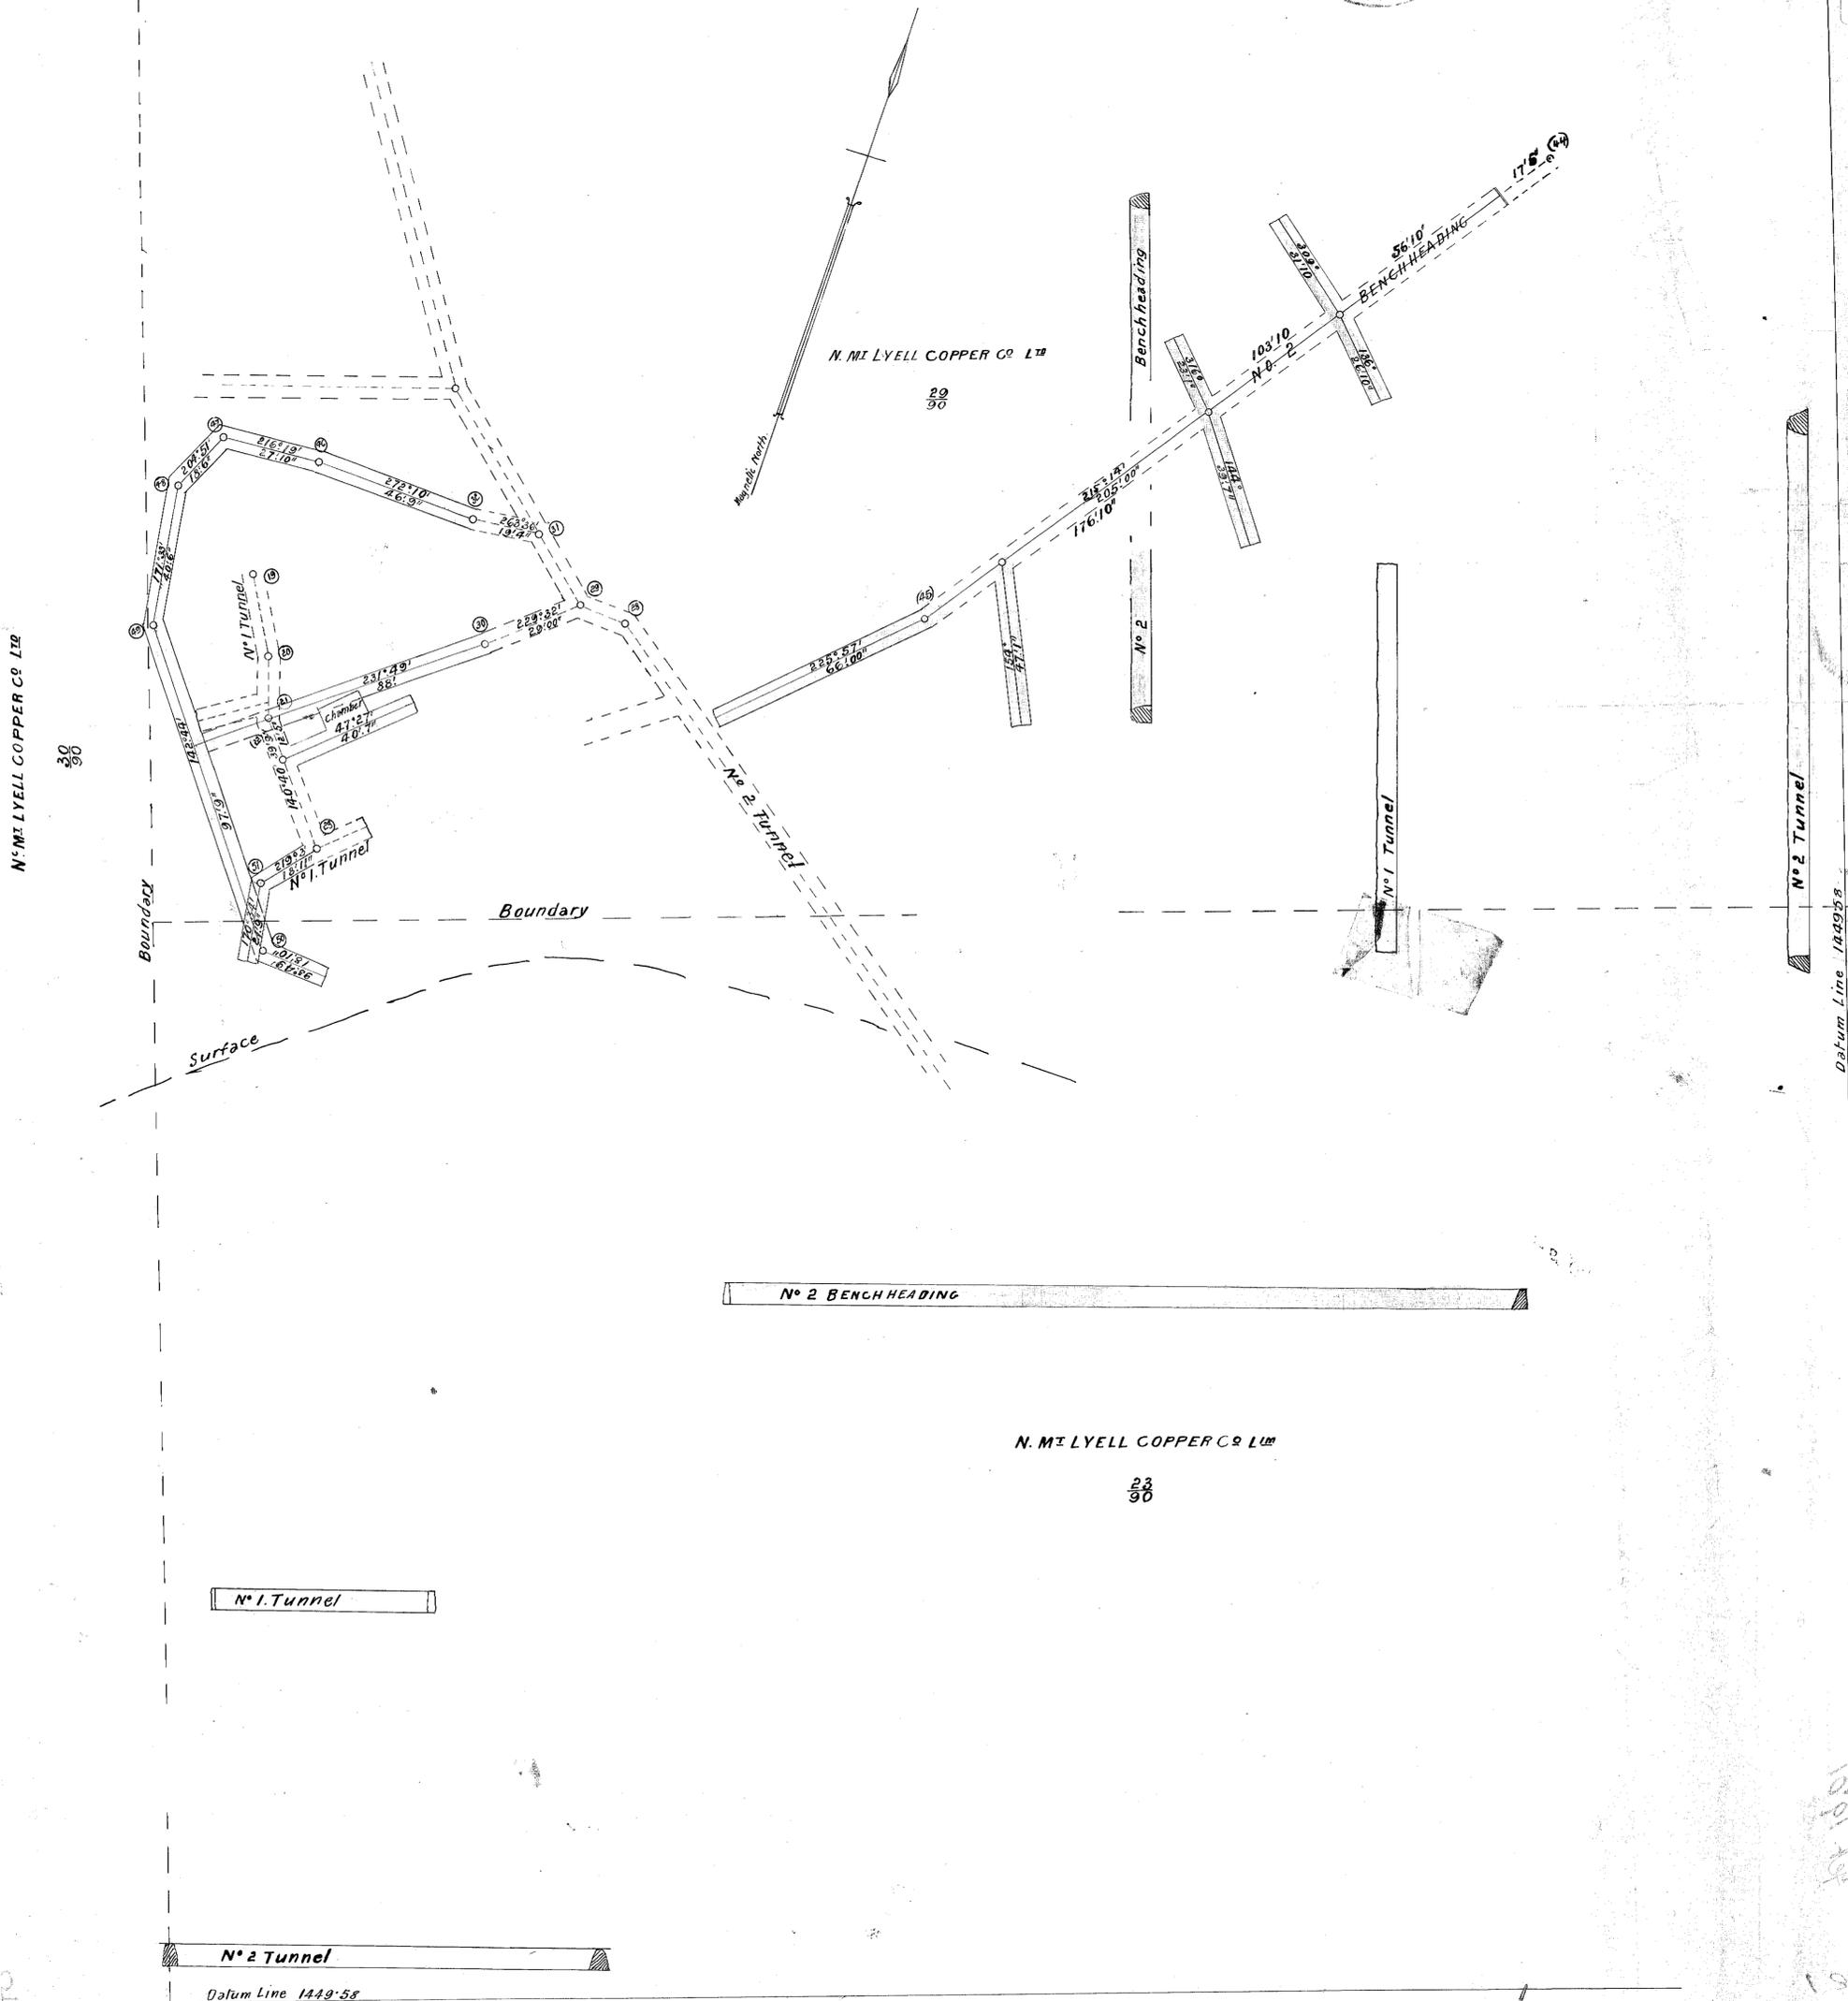

80-101

Handwritten notes in the bottom right corner, including 'No 1 Tunnel' and 'No 2 Tunnel'.

102