 


TASMAN & CROWN LYELL EXTD. M. CO., N. L.


VERTICAL SECTION

Showing Workings projected on a plane
parallel to Western Boundary

SCALE




Jno M. Perke
Mining Surveyor
24/7/17

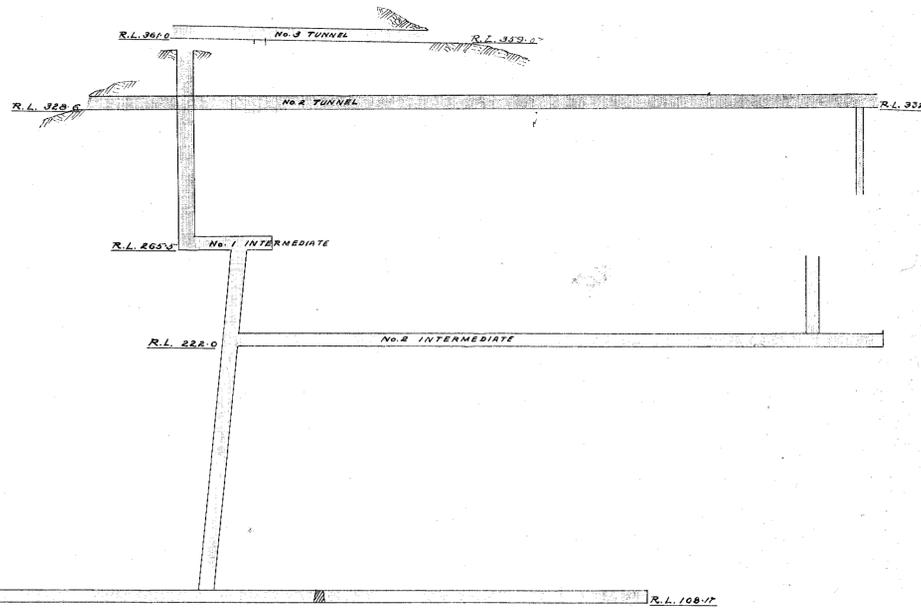

5 cm

$R.L. 100.41'$
above datum

$R.L. 108.47'$

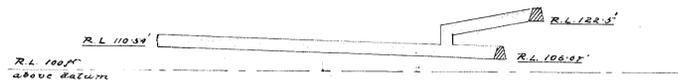

VERTICAL SECTION

On line A-B on plan

101-09

101-09