
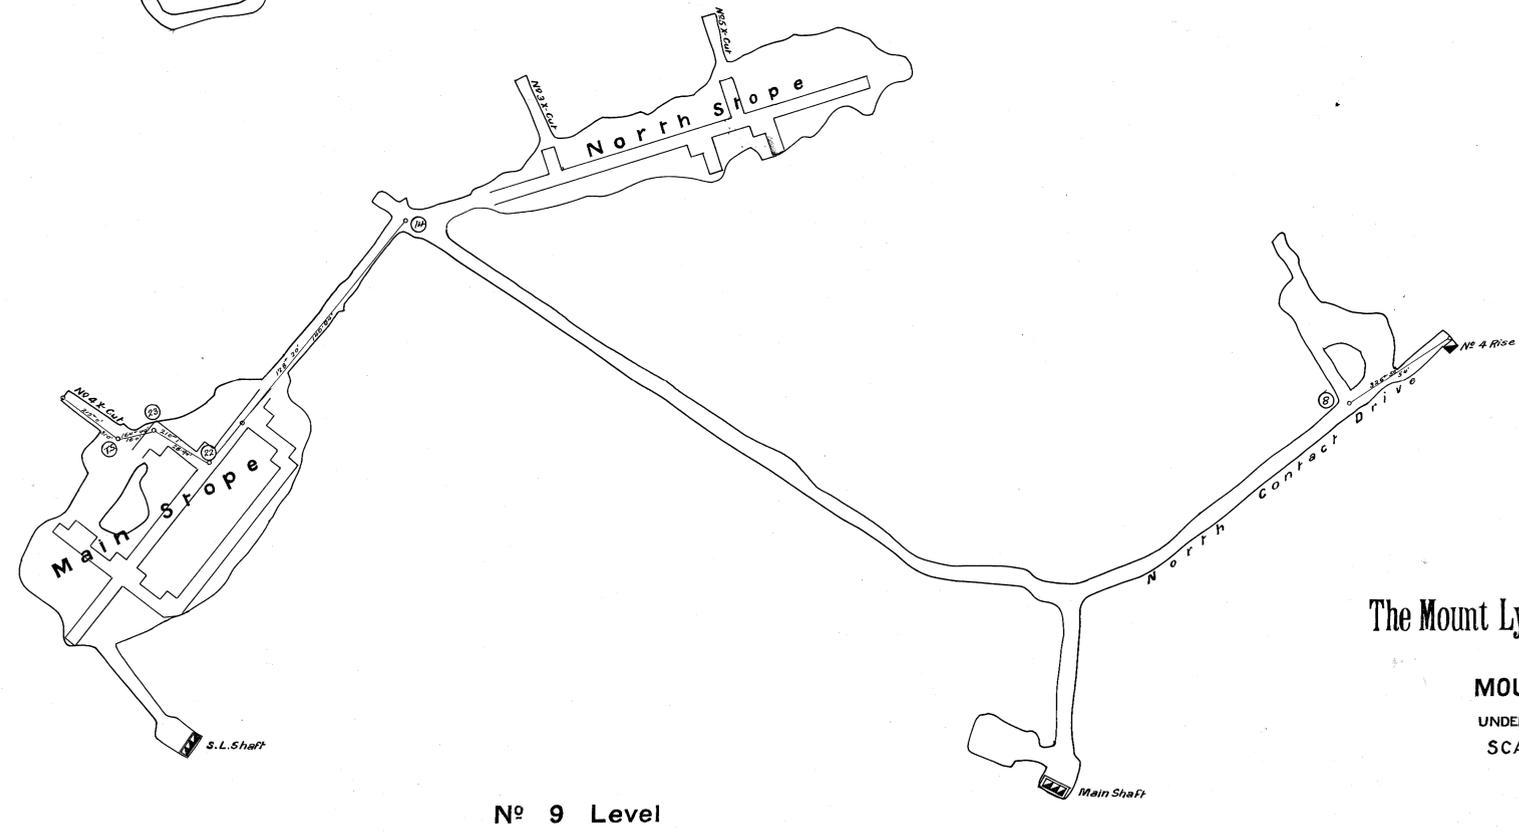
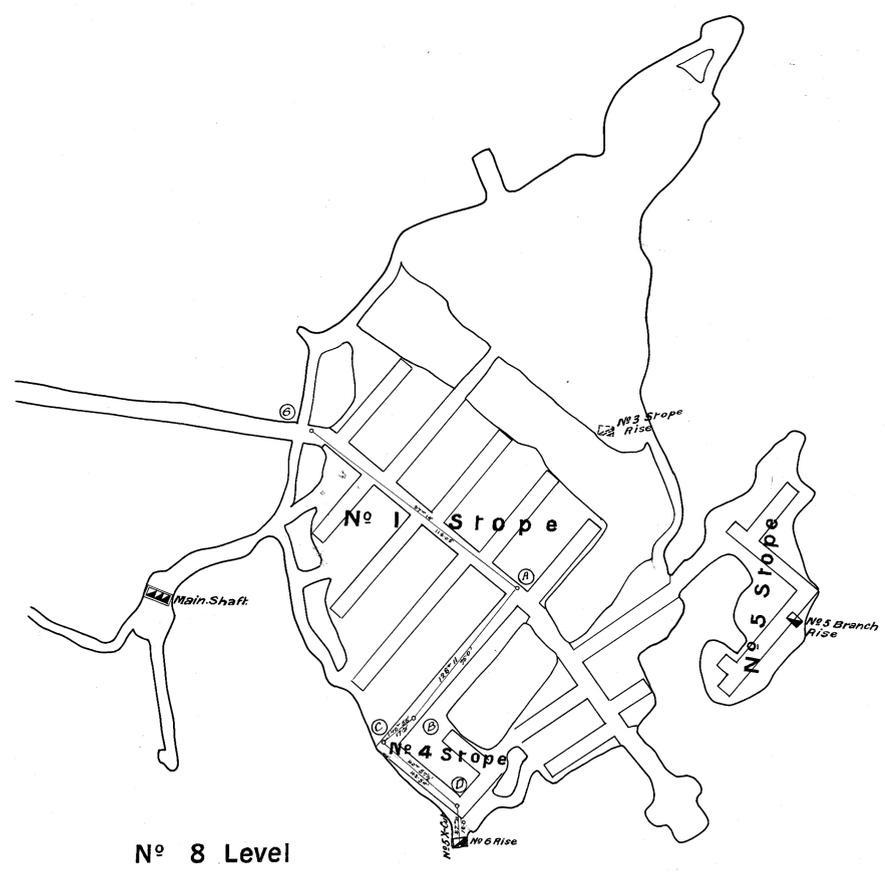
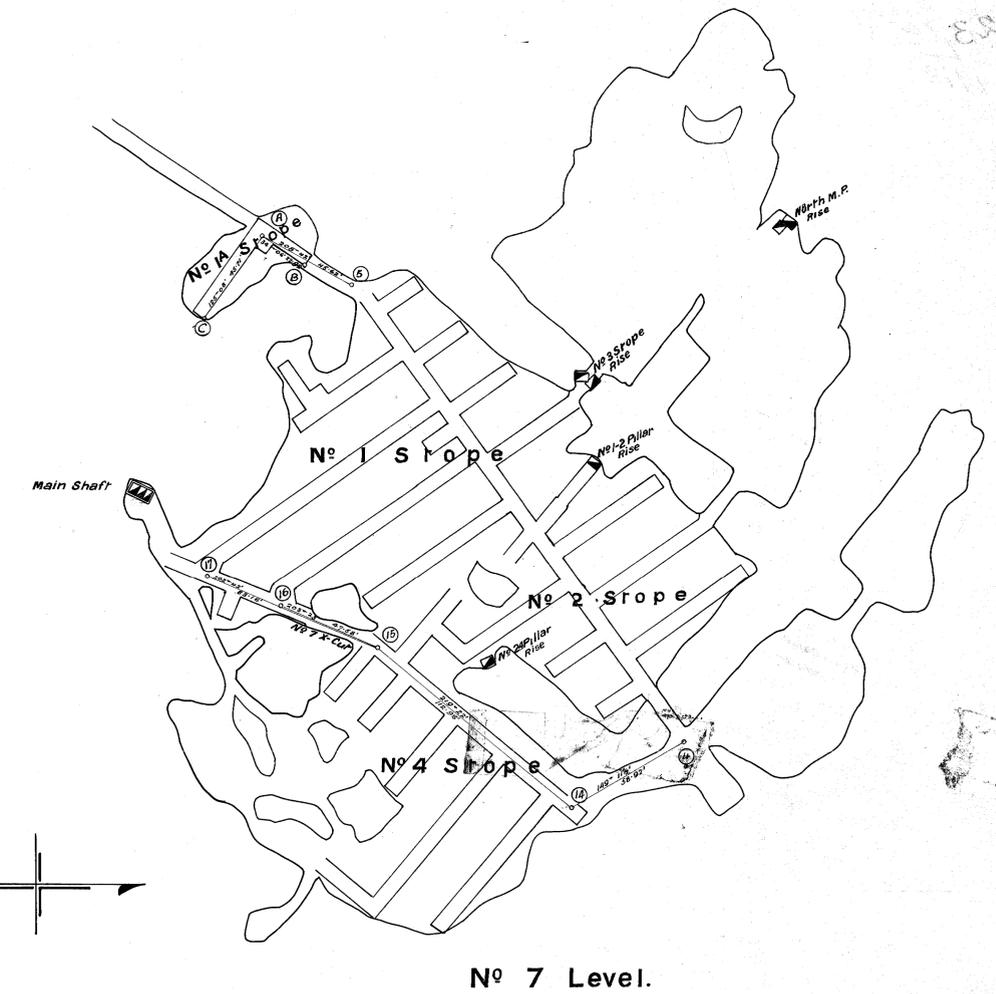


101-16

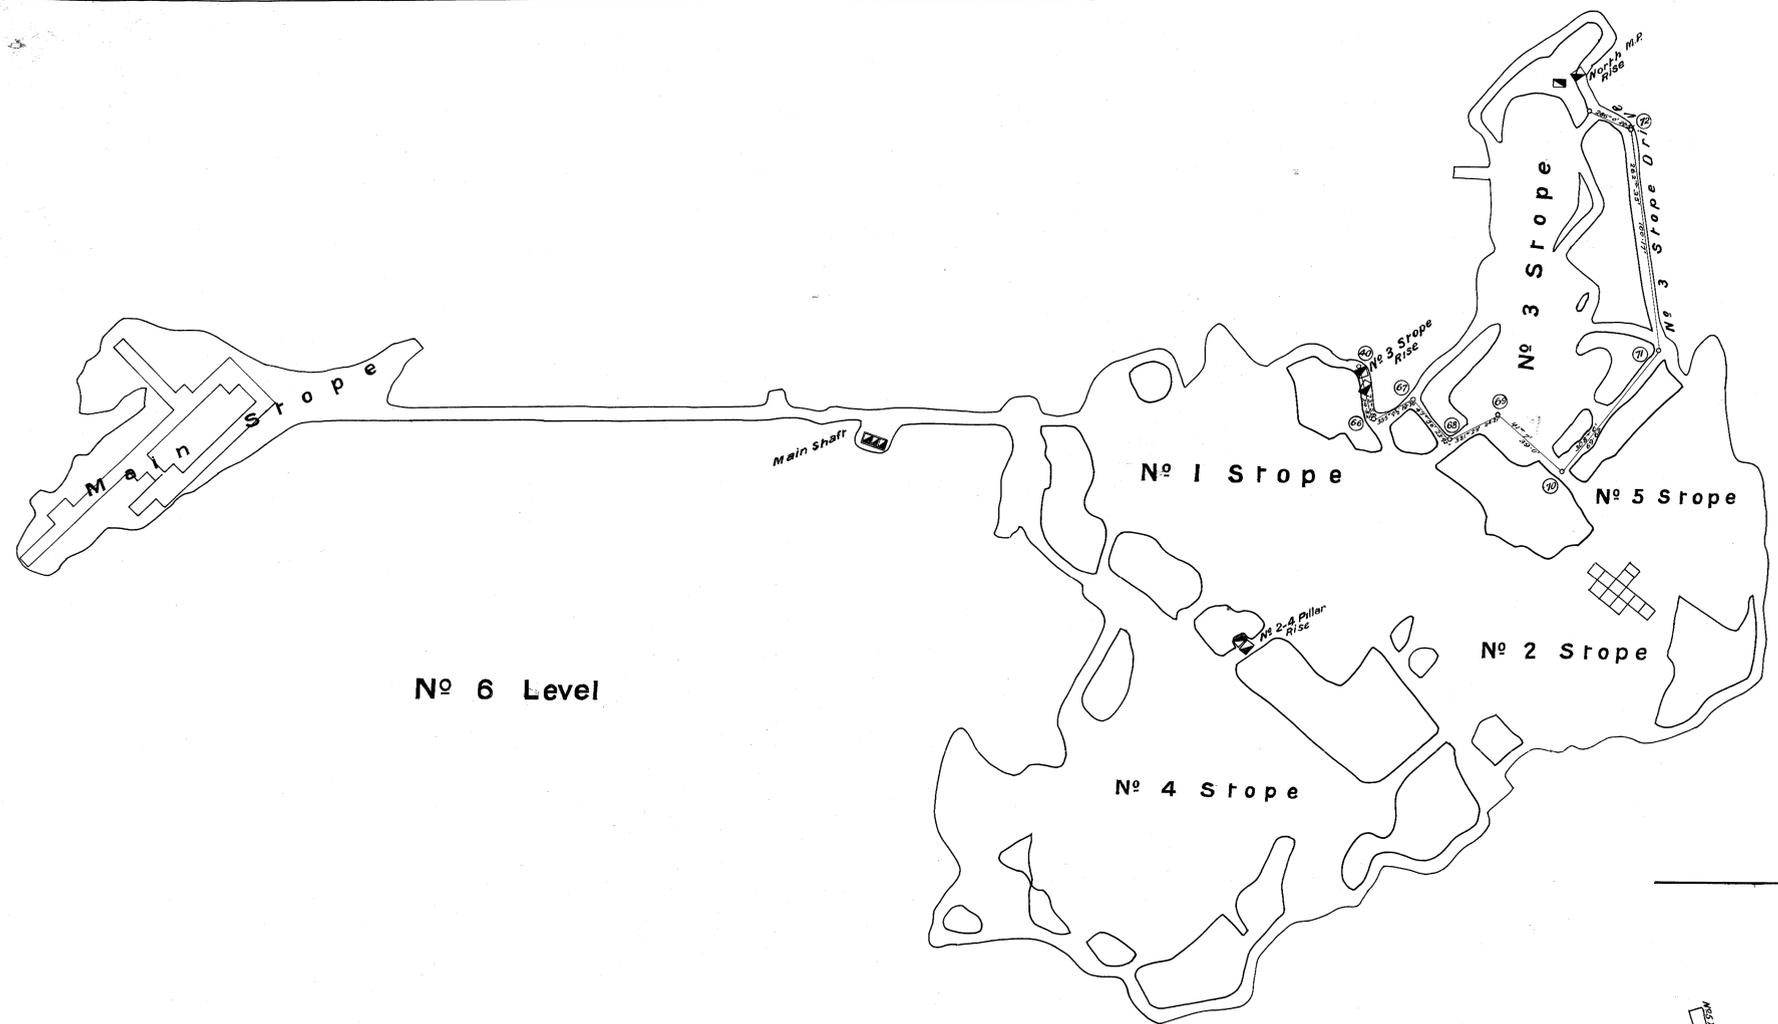

The Mount Lyell Mining & Railway Co., Ltd.  
 Mine Department.  
**MOUNT LYELL MINE**  
 UNDERGROUND WORKINGS. 1918  
 SCALE: 1 INCH = 30 FEET

*Robt. Smith* General Manager  
*R. Williams* Engineer-in-Charge

101-16

50m

891

153