


101-17

101-17

5 cm

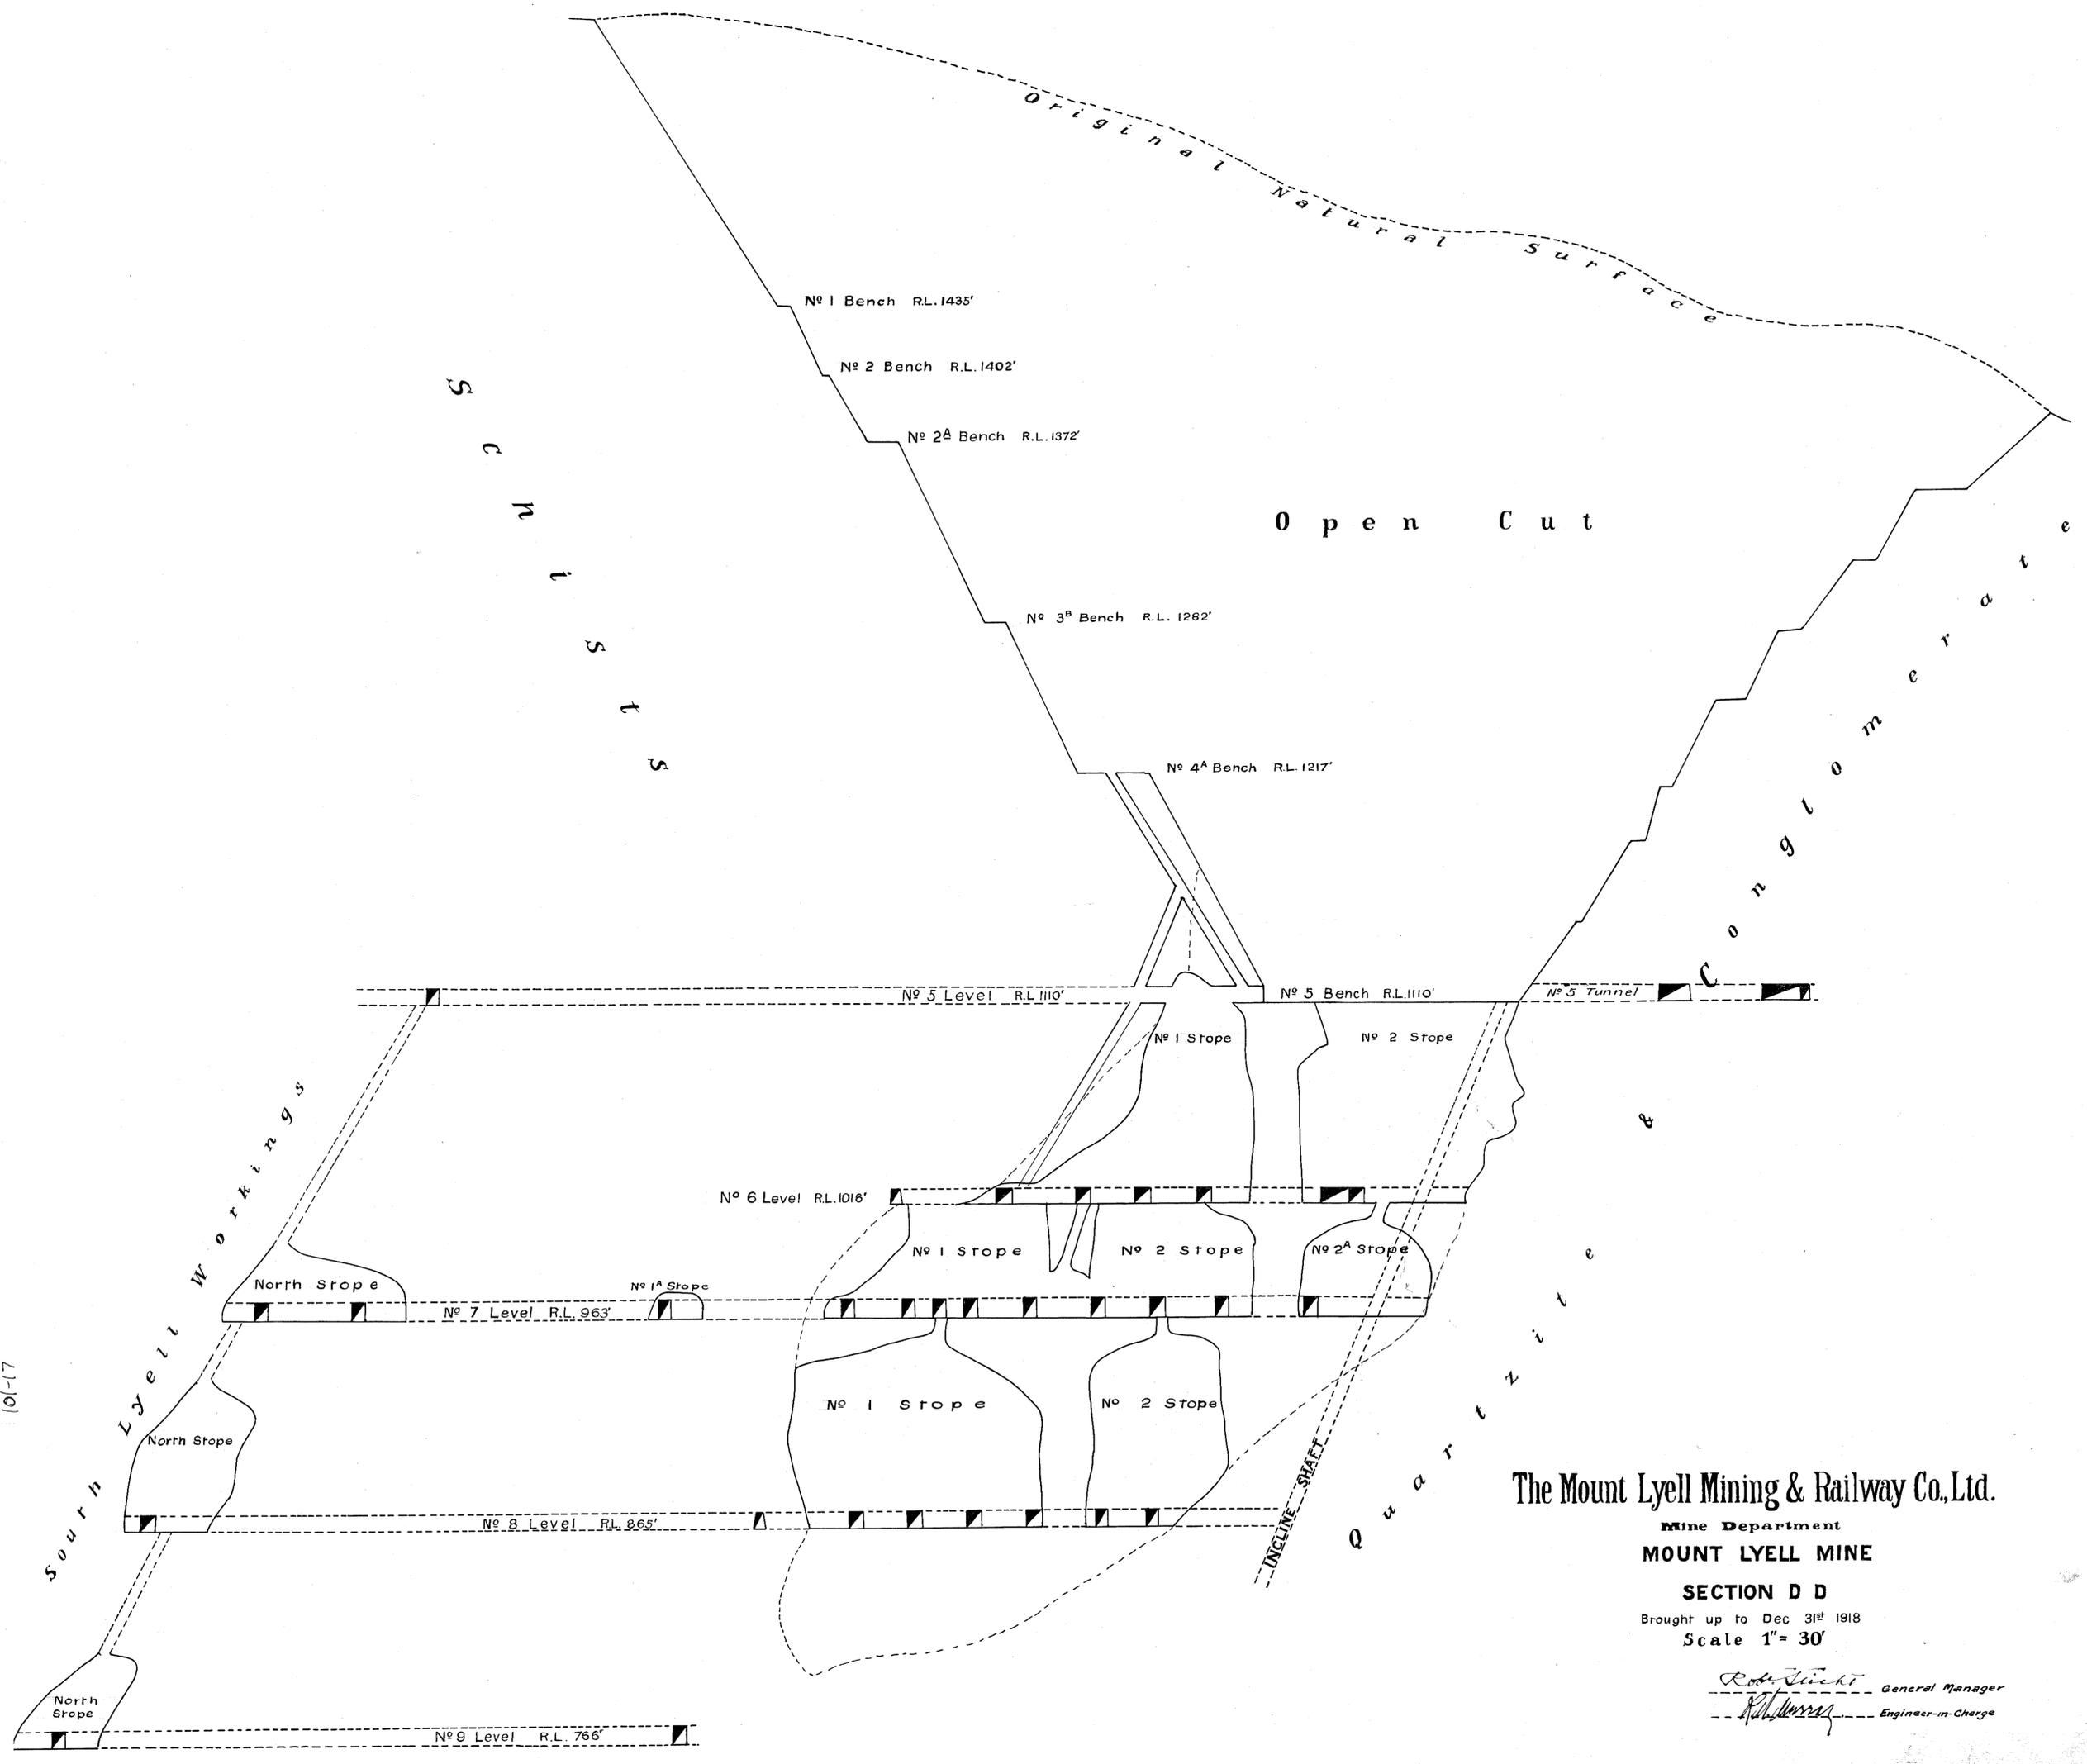


The Mount Lyell Mining & Railway Co., Ltd.

Mine Department
MOUNT LYELL MINE

SECTION D D

Brought up to Dec 31st 1918
Scale 1" = 30'

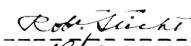 General Manager
 Engineer-in-Charge