

81-101

Original Natural Surface


N<sup>o</sup> 1 Bench R.L. 1435'  
N<sup>o</sup> 2 Bench R.L. 1402'  
N<sup>o</sup> 2<sup>A</sup> Bench R.L. 1372'

Open Cut

N<sup>o</sup> 3<sup>B</sup> Bench R.L. 1286  
N<sup>o</sup> 4<sup>A</sup> Bench R.L. 1217'


S  
c  
h  
i  
t  
s

MAIN SHAFT

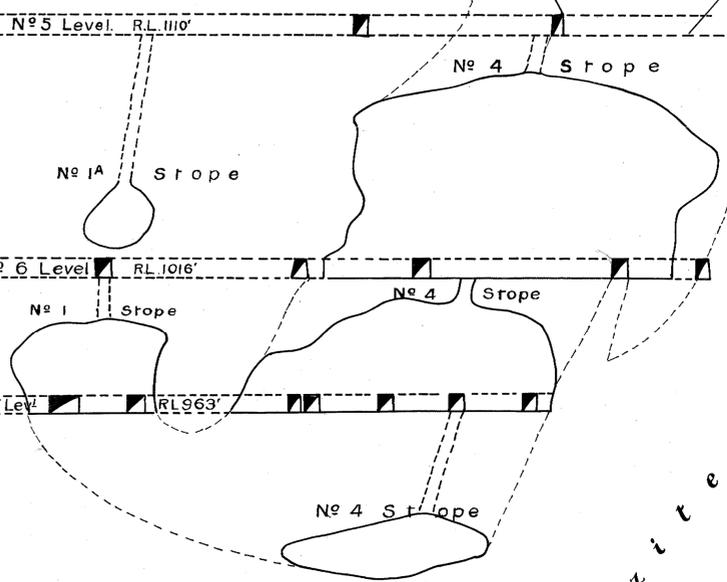

Conglomerate

Quartzite

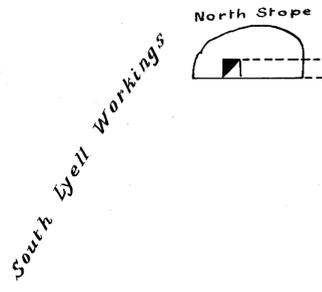

The Mount Lyell Mining & Railway Co. Ltd.

Mine Department  
MOUNT LYELL MINE

SECTION C-C

Brought up to Dec 31<sup>st</sup> 1918  
Scale 1" = 30'

*Robert Leitch* General Manager  
*William ...* Engineer-in-Charge

81-101