


101-19

5 cm

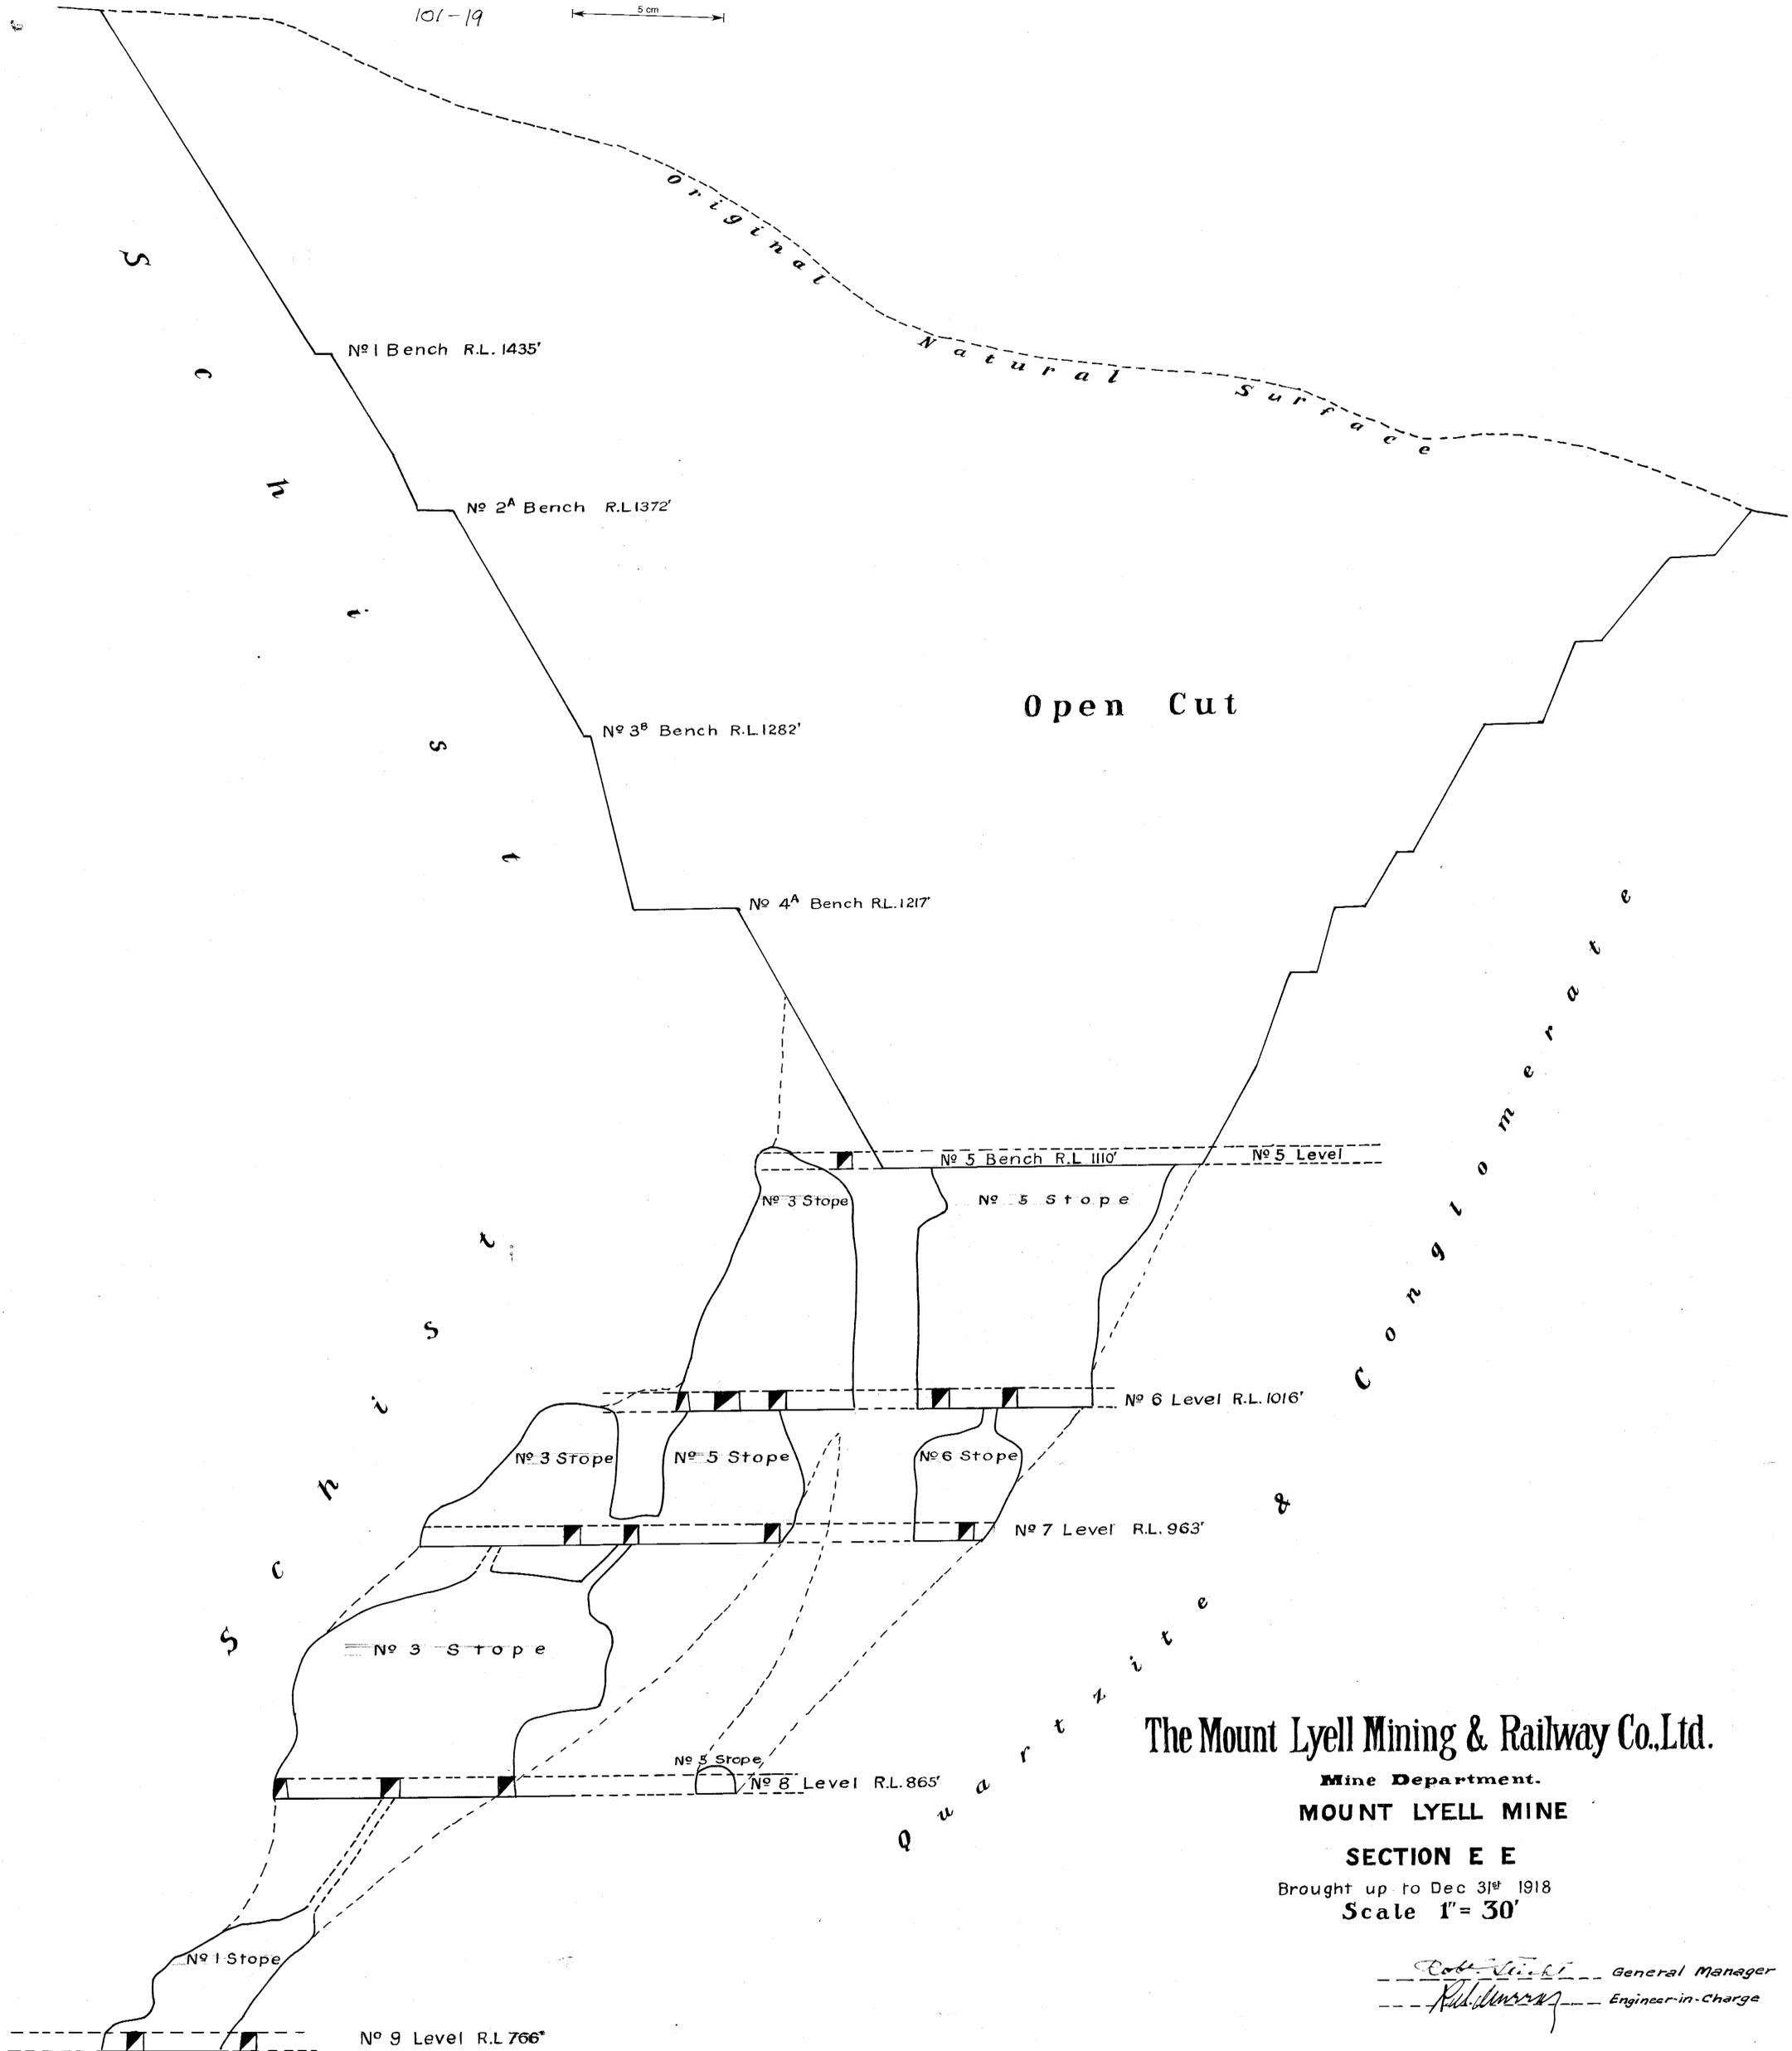

The Mount Lyell Mining & Railway Co., Ltd.

Mine Department.
MOUNT LYELL MINE

SECTION E E

Brought up to Dec 31st 1918
Scale 1" = 30'

Edw. Smith General Manager
Ed. Murray Engineer-in-Charge