


101-20

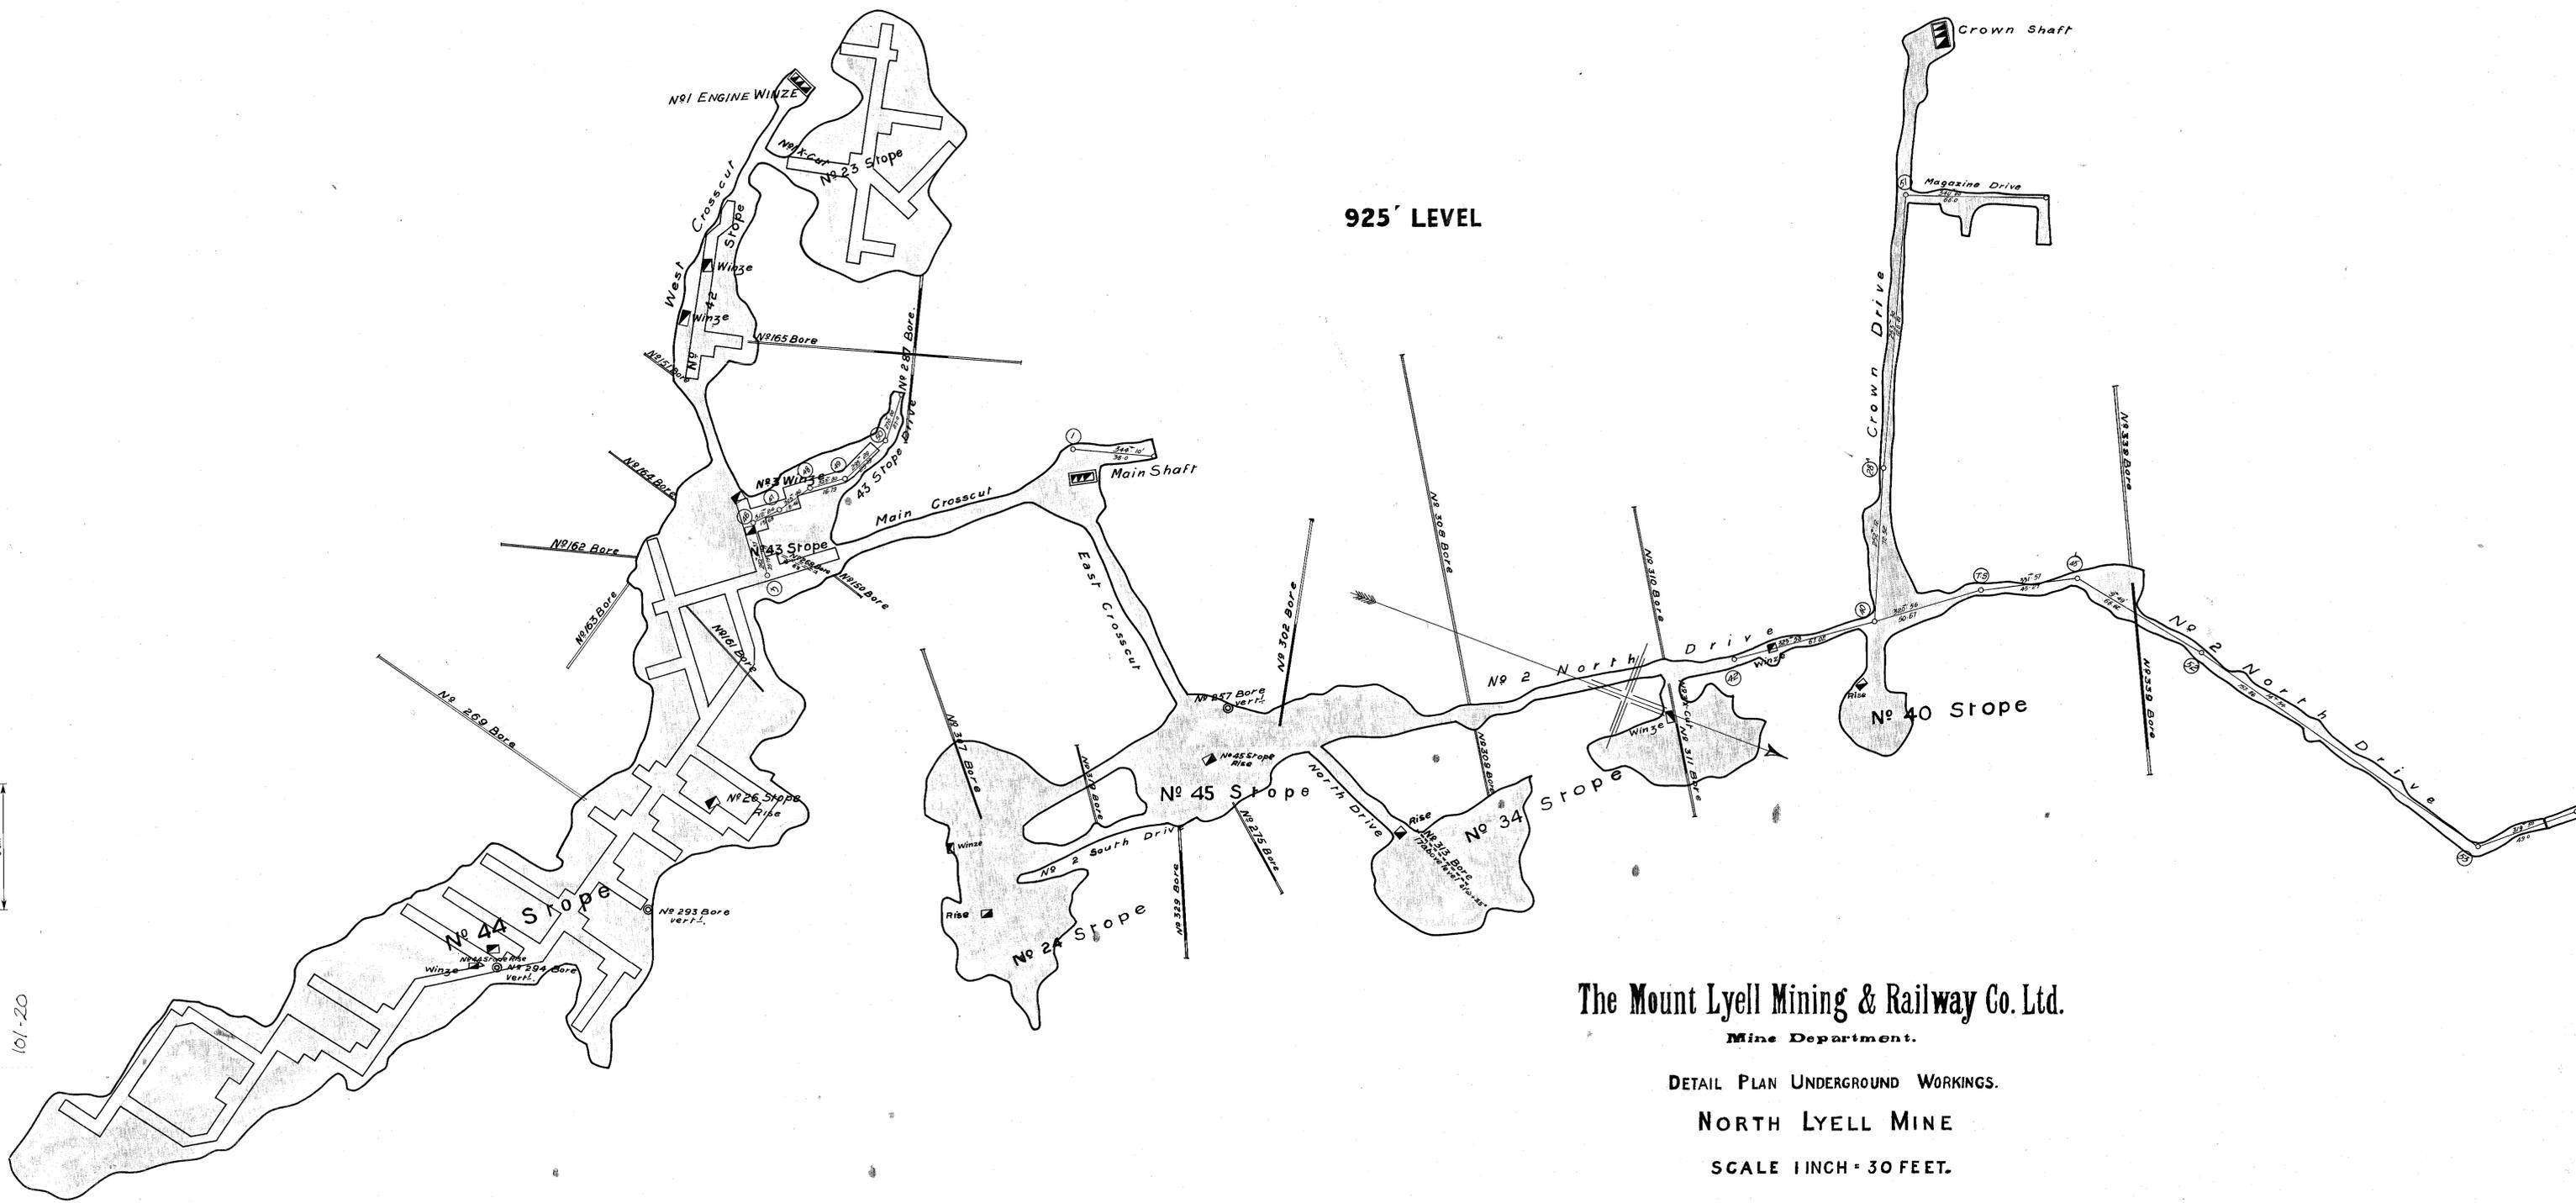

50m

101-20

925' LEVEL

The Mount Lyell Mining & Railway Co. Ltd.

Mine Department.

DETAIL PLAN UNDERGROUND WORKINGS.

NORTH LYELL MINE

SCALE 1 INCH = 30 FEET.

----- General Manager.  
*R. Murray* Engineer-in-Charge.