


101-21

5 cm

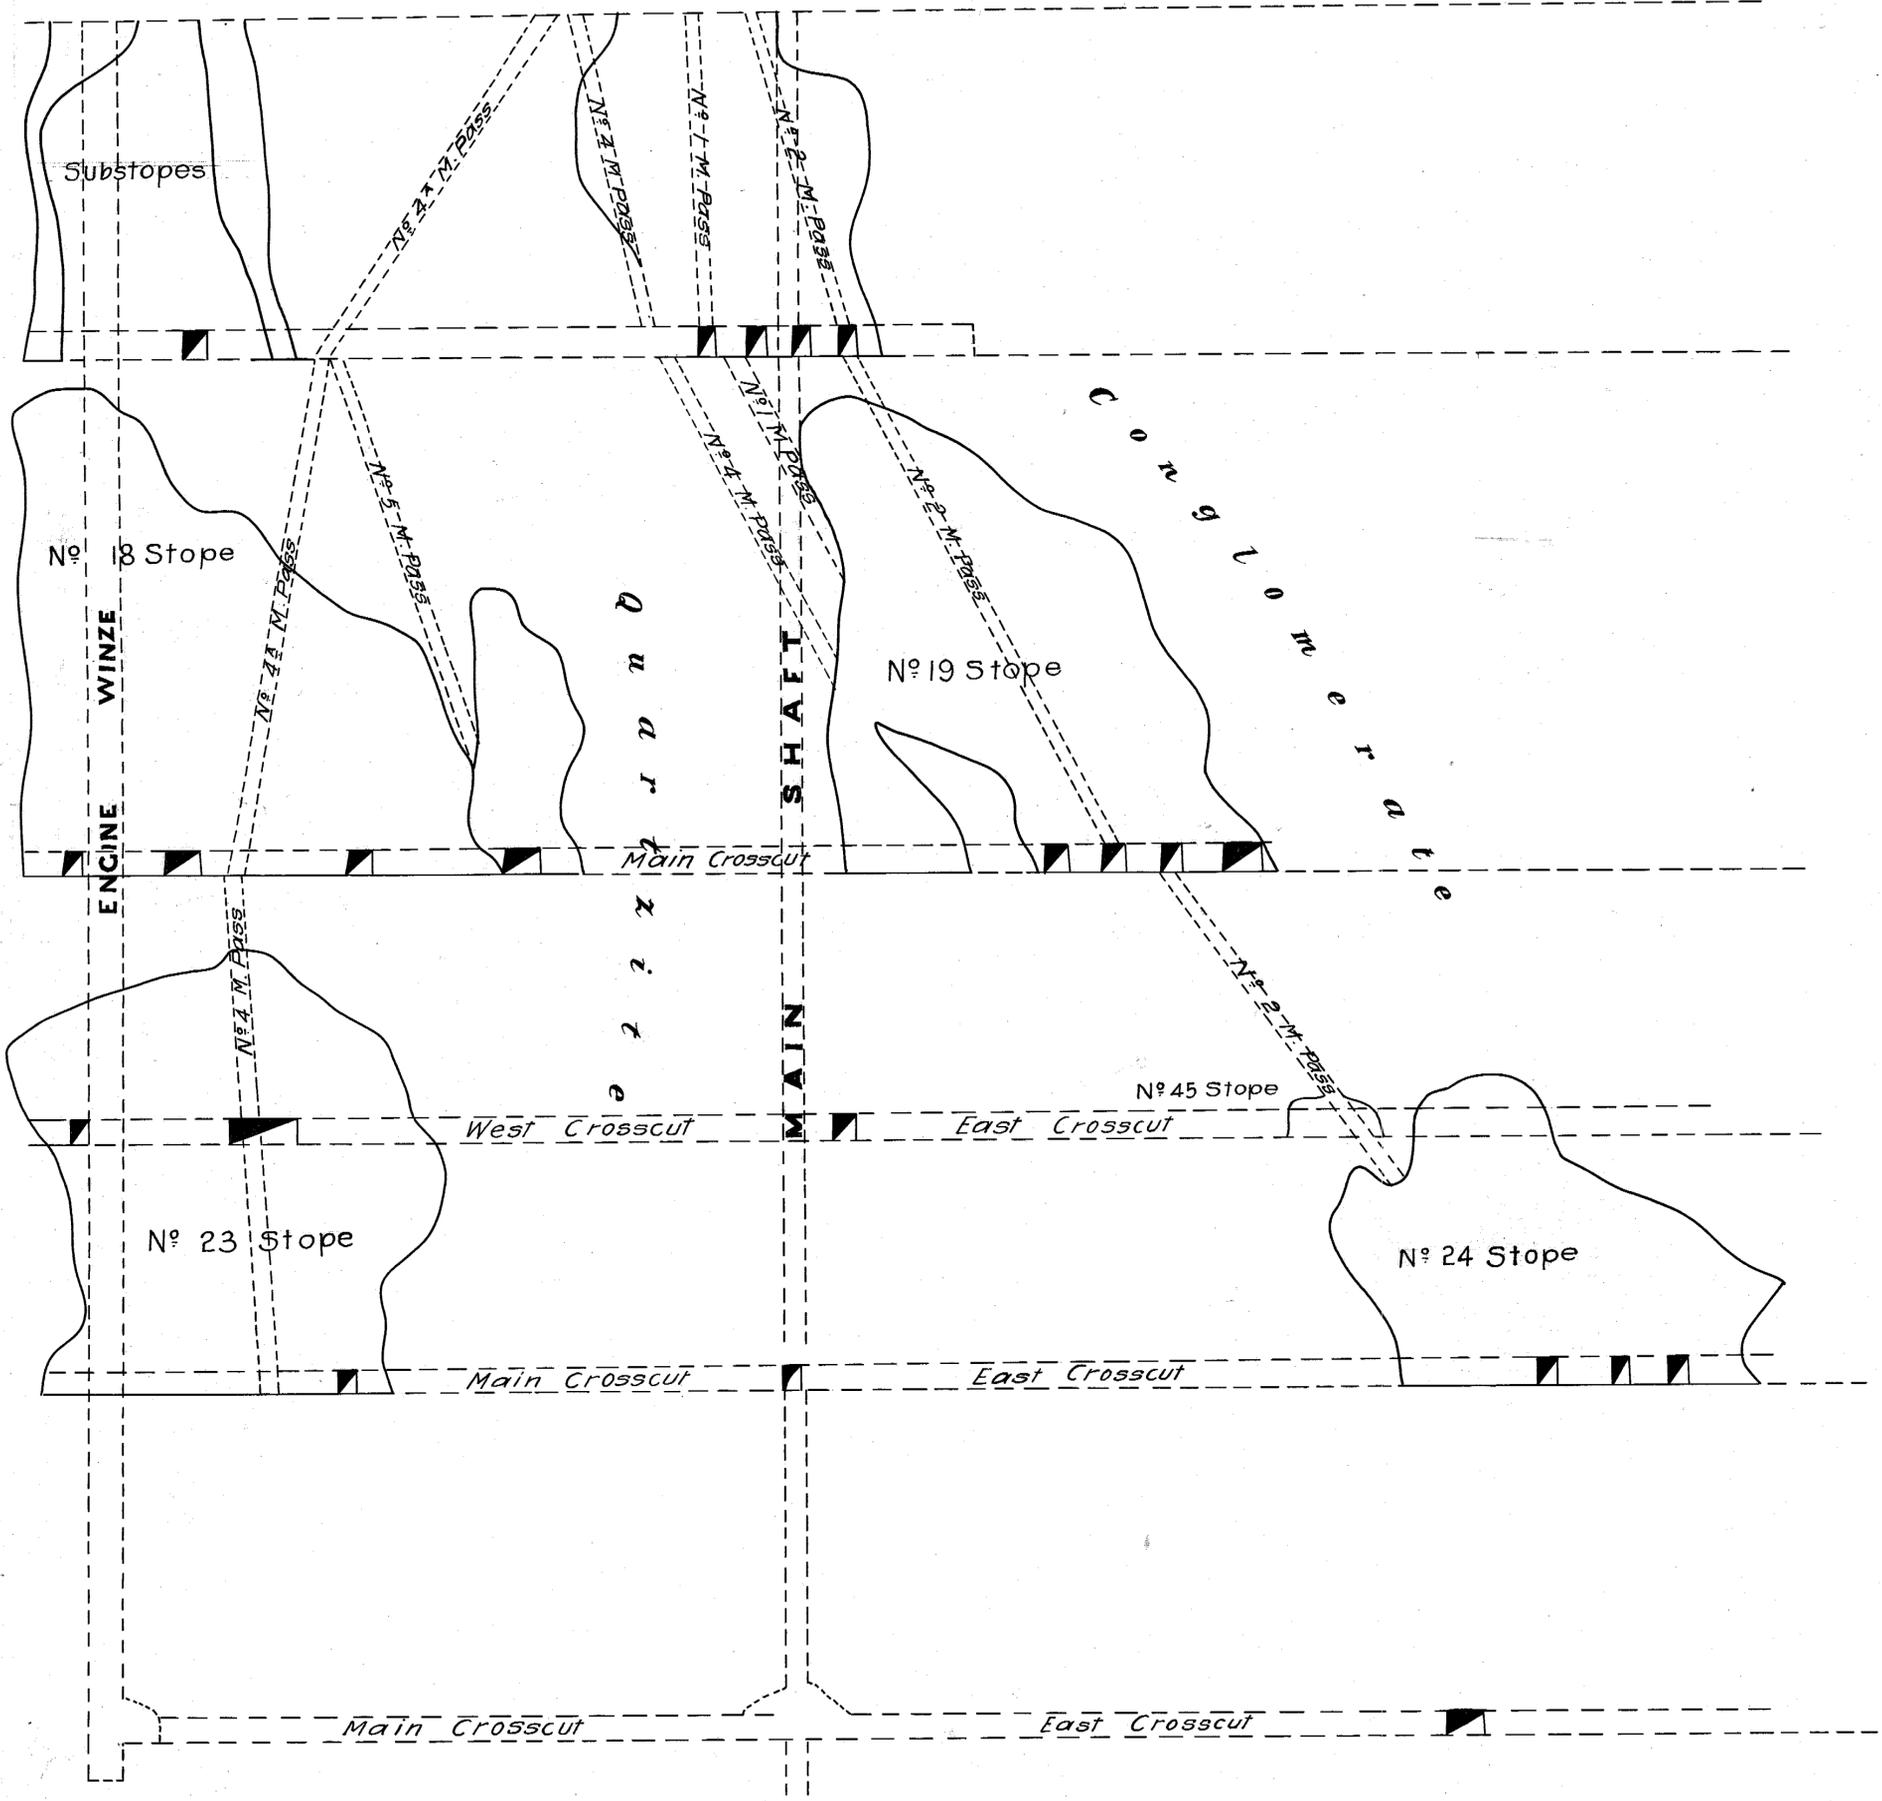

The Mount Lyell Mining & Railway Co., Ltd.

Mine Department.

NORTH LYELL MINE. Section on Line BB looking North.

Brought up to December 1919.
Scale 1" = 30.

General Manager.
R. J. Murray Engineer-in-Charge.