


101-22

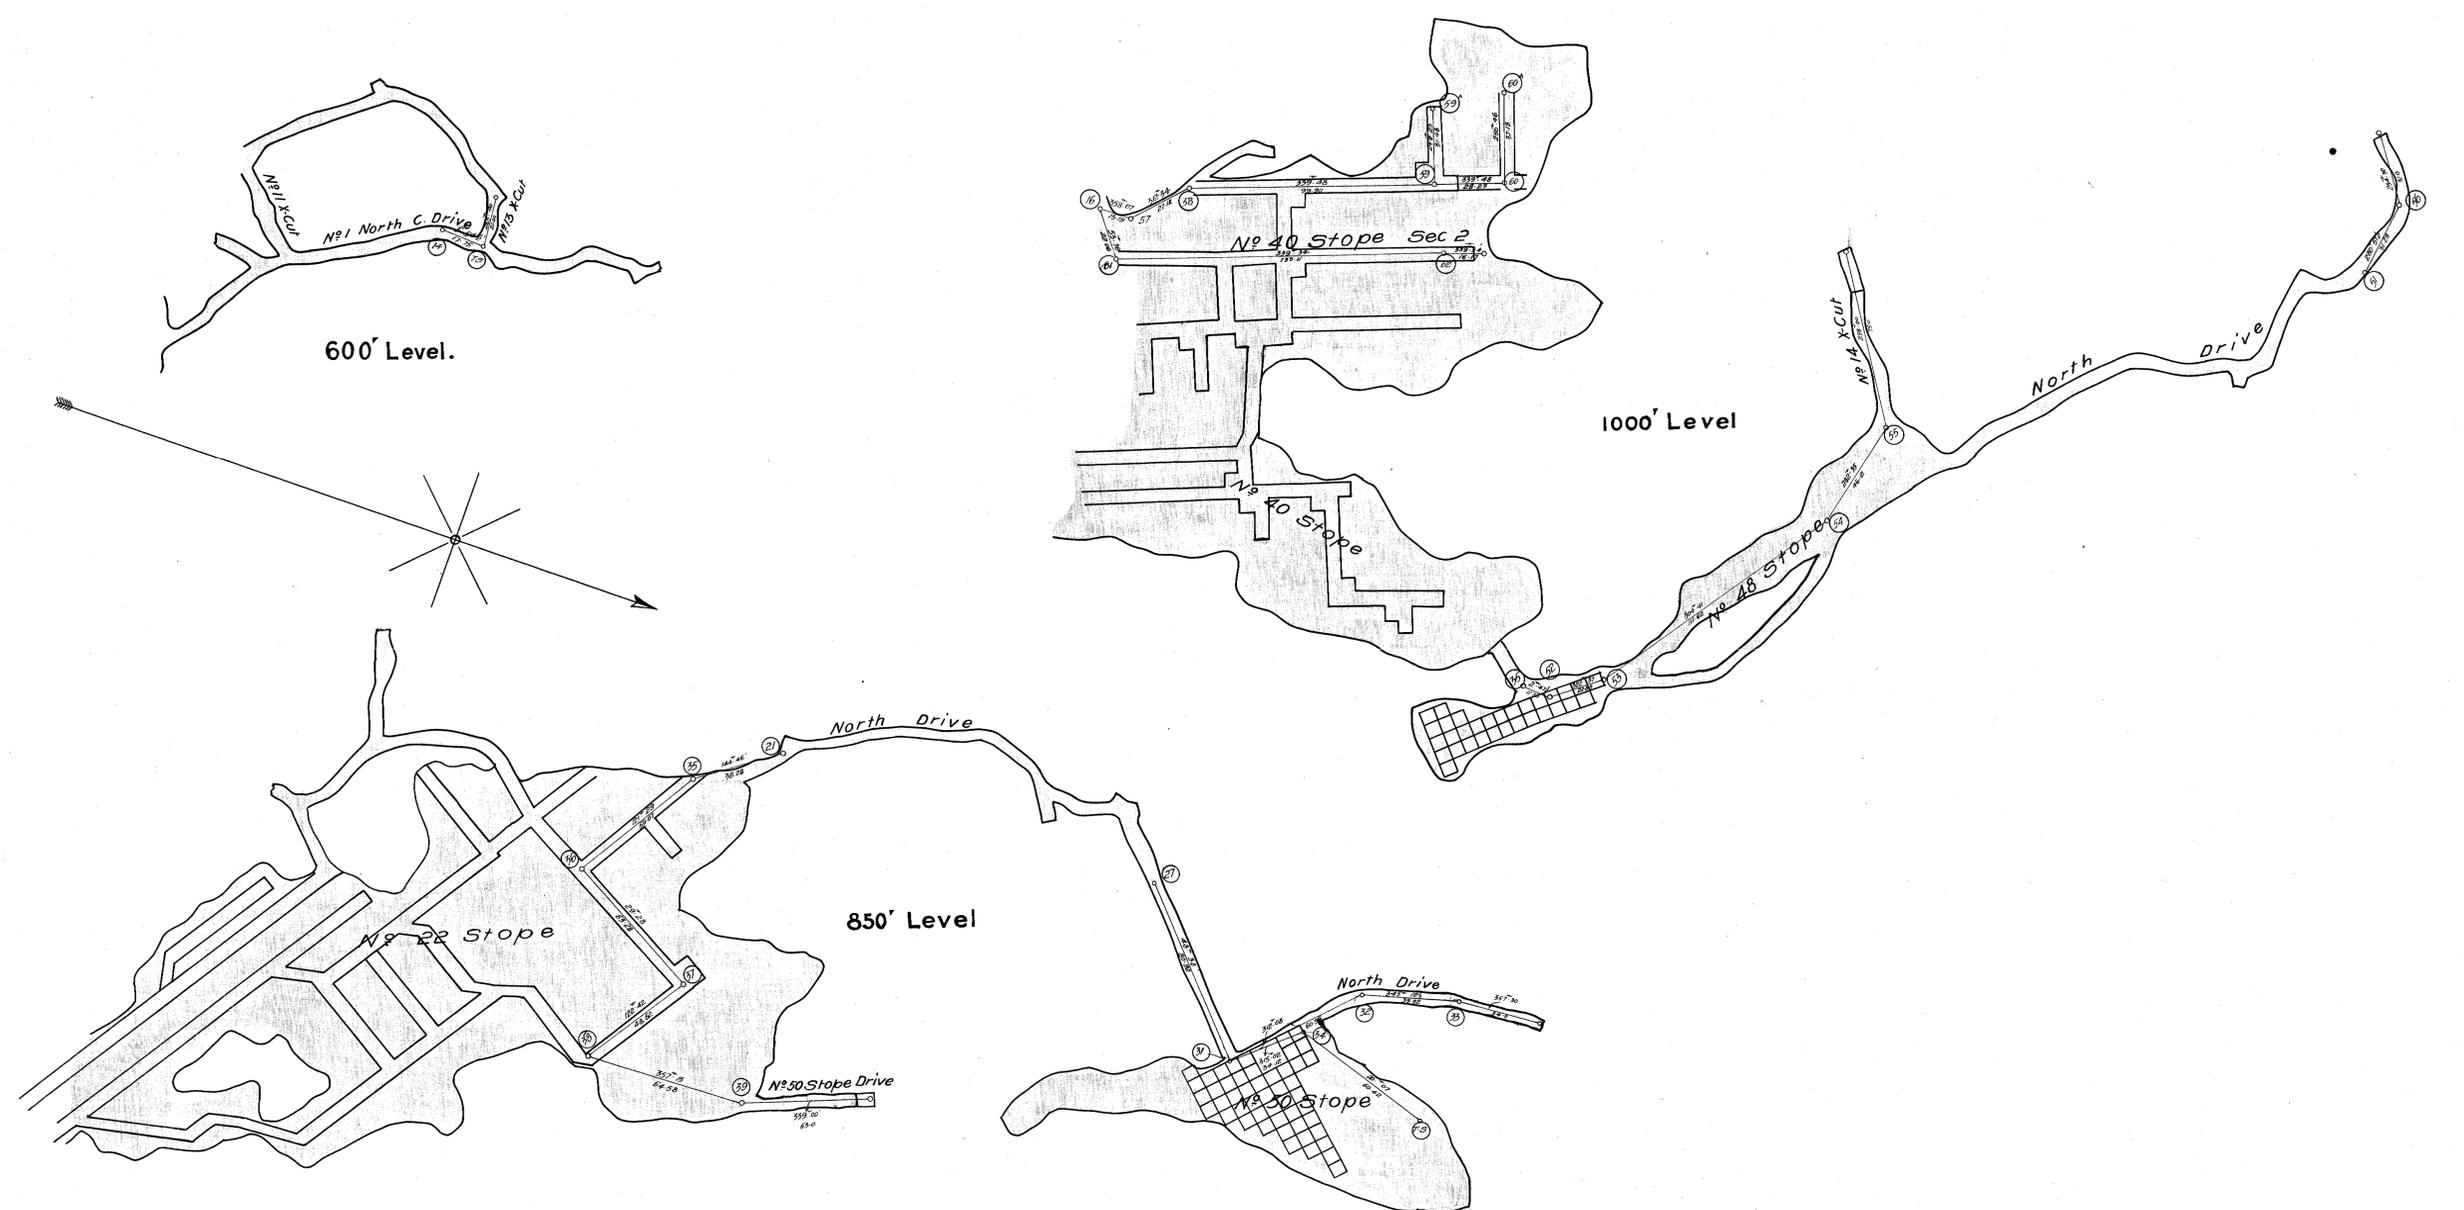

**The Mount Lyell Mining & Railway Co., Ltd.**

Mine Department.  
**NORTH LYELL MINE**  
 UNDERGROUND WORKINGS. 1919.  
 SCALE. 1 INCH = 30 FEET.

----- General Manager.  
*R. Murray* Engineer-in-Charge.

101-22

15