


# The Mount Lyell Mining & Railway Co. Ltd.

Mine Department.  
**MOUNT LYELL MINE.**  
DETAIL PLAN UNDERGROUND WORKINGS.  
SCALE: 1 INCH = 30 FEET.

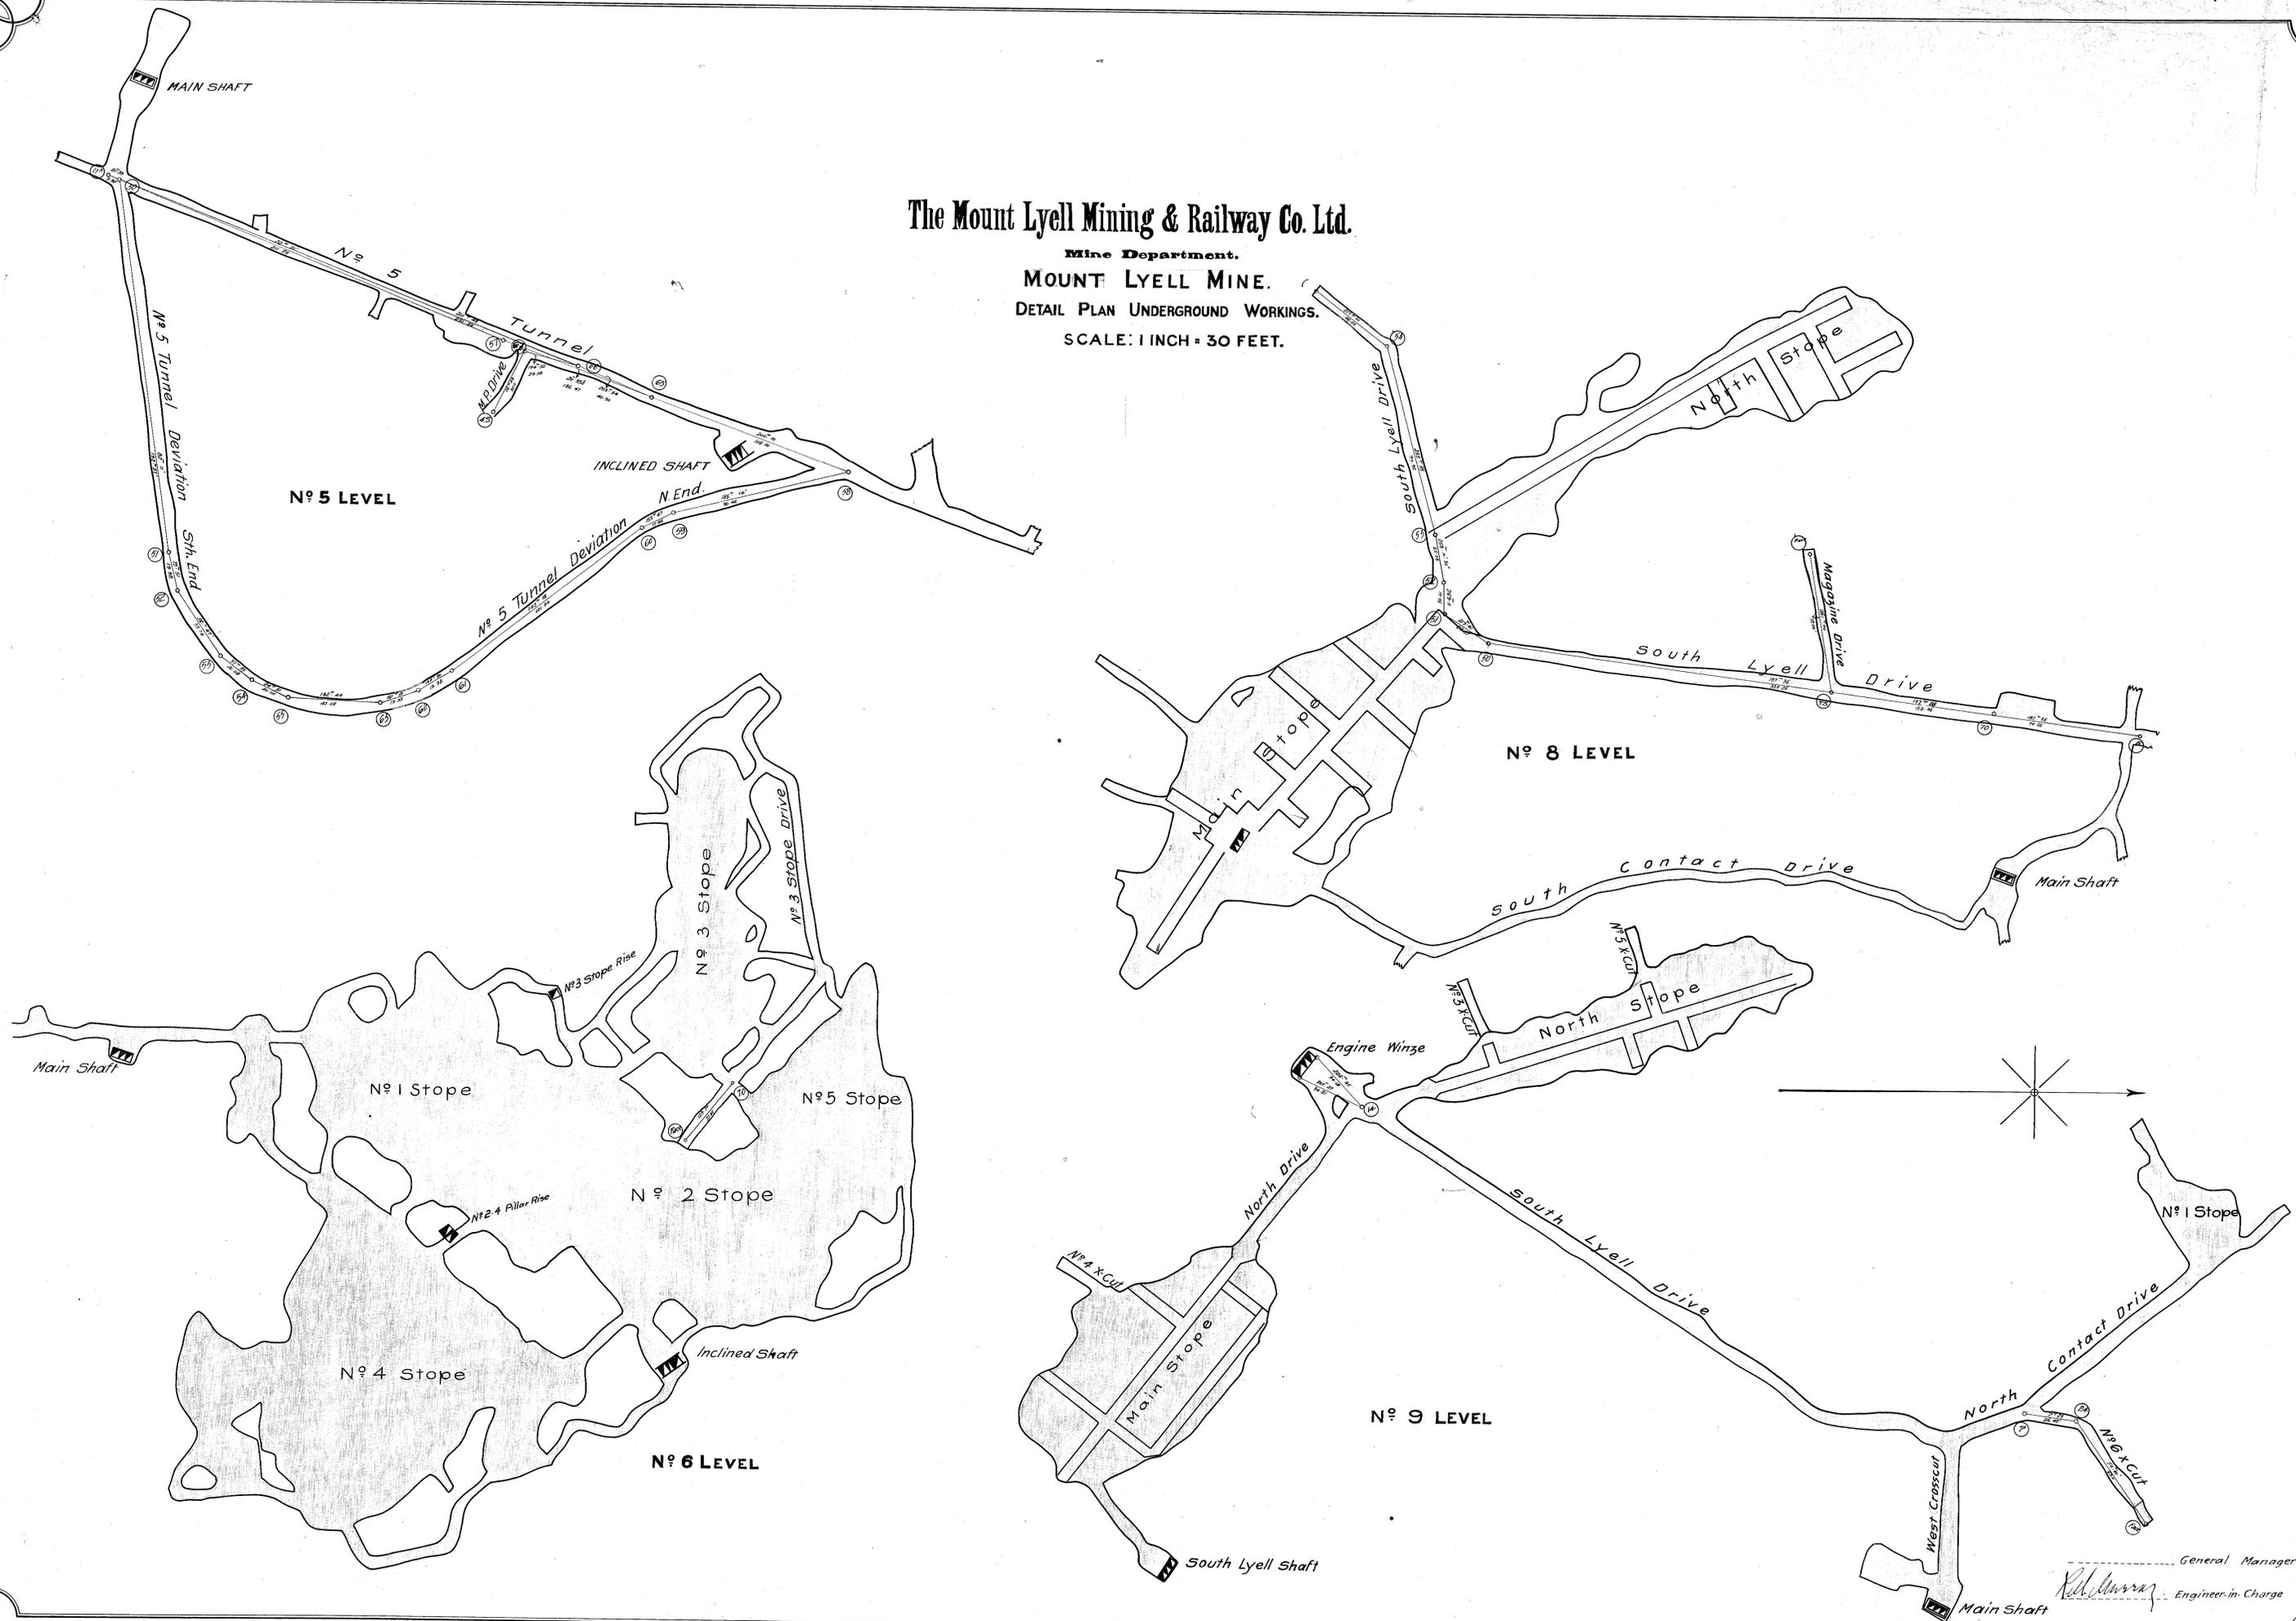

General Manager  
*R. H. Murray*  
Engineer-in-Charge