


5 cm

101-24

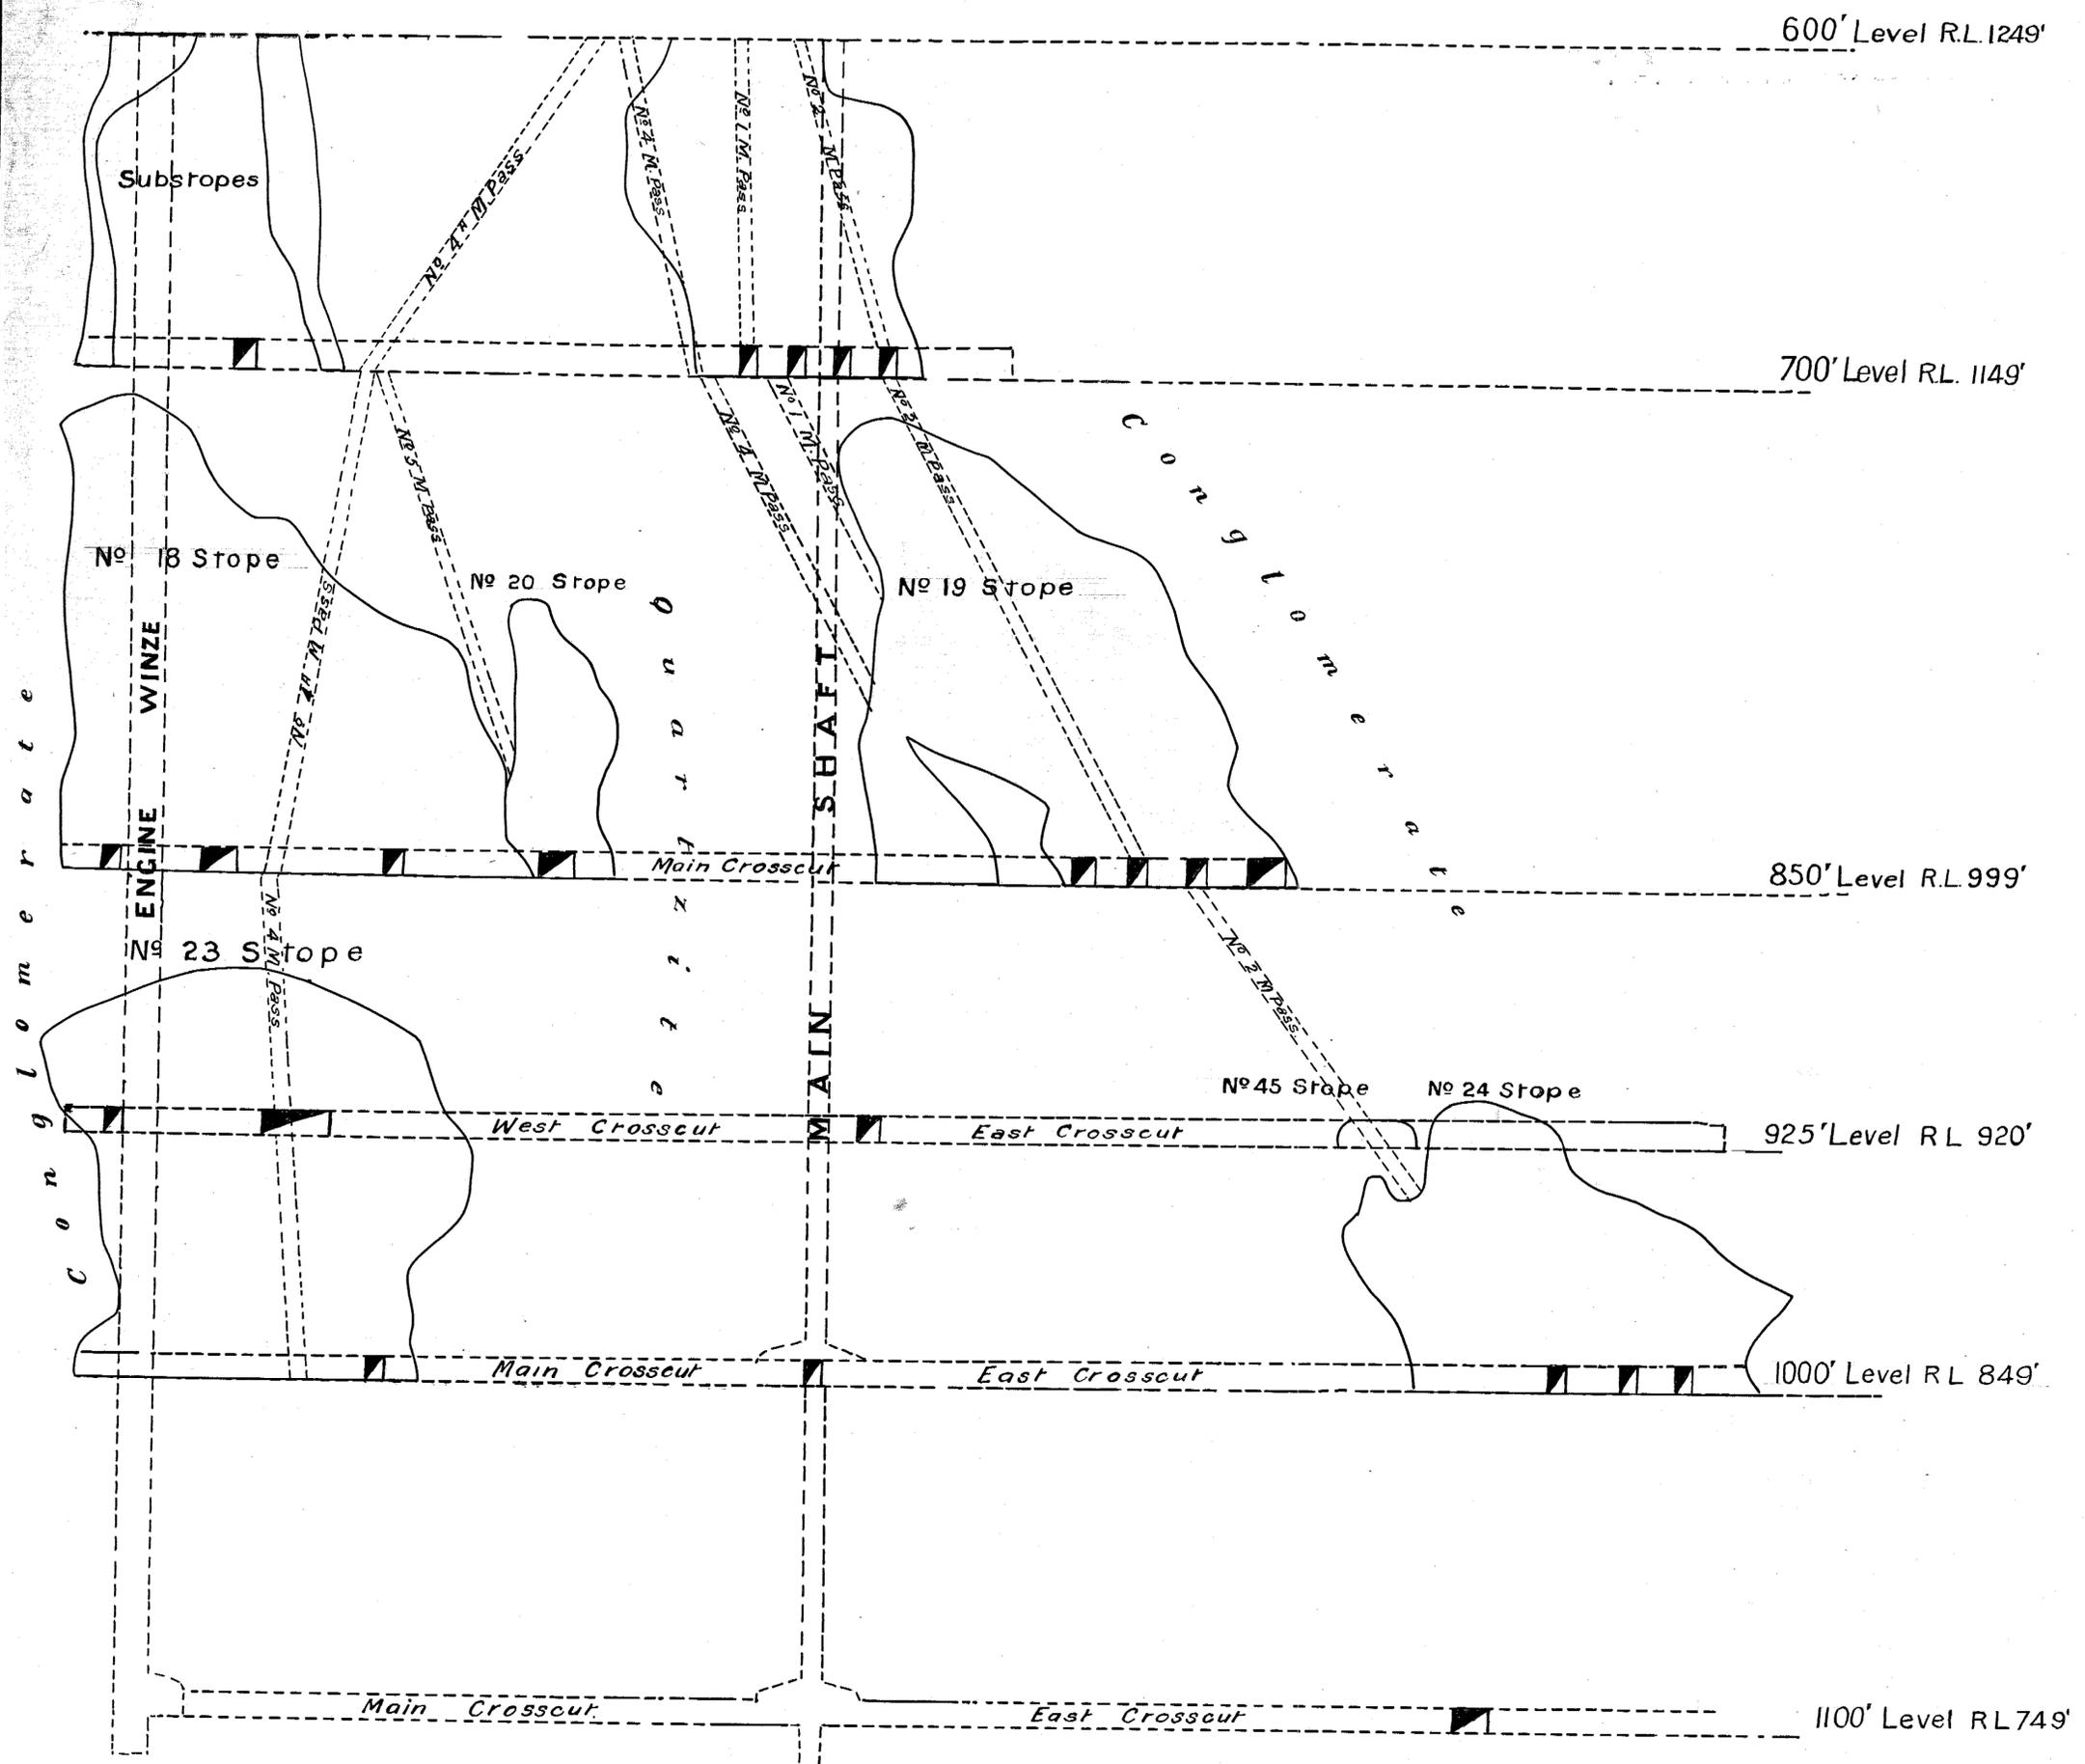

**The Mount Lyell Mining & Railway Co. Ltd.**

Mine Department.

**NORTH LYELL MINE**  
Section on Line BB looking North

Brought up to Dec. 31<sup>st</sup> 1918

Scale 1" = 30'

*Robt. Smith* General Manager  
*W. J. ...* Engineer-in-Charge