


5 cm

101-28

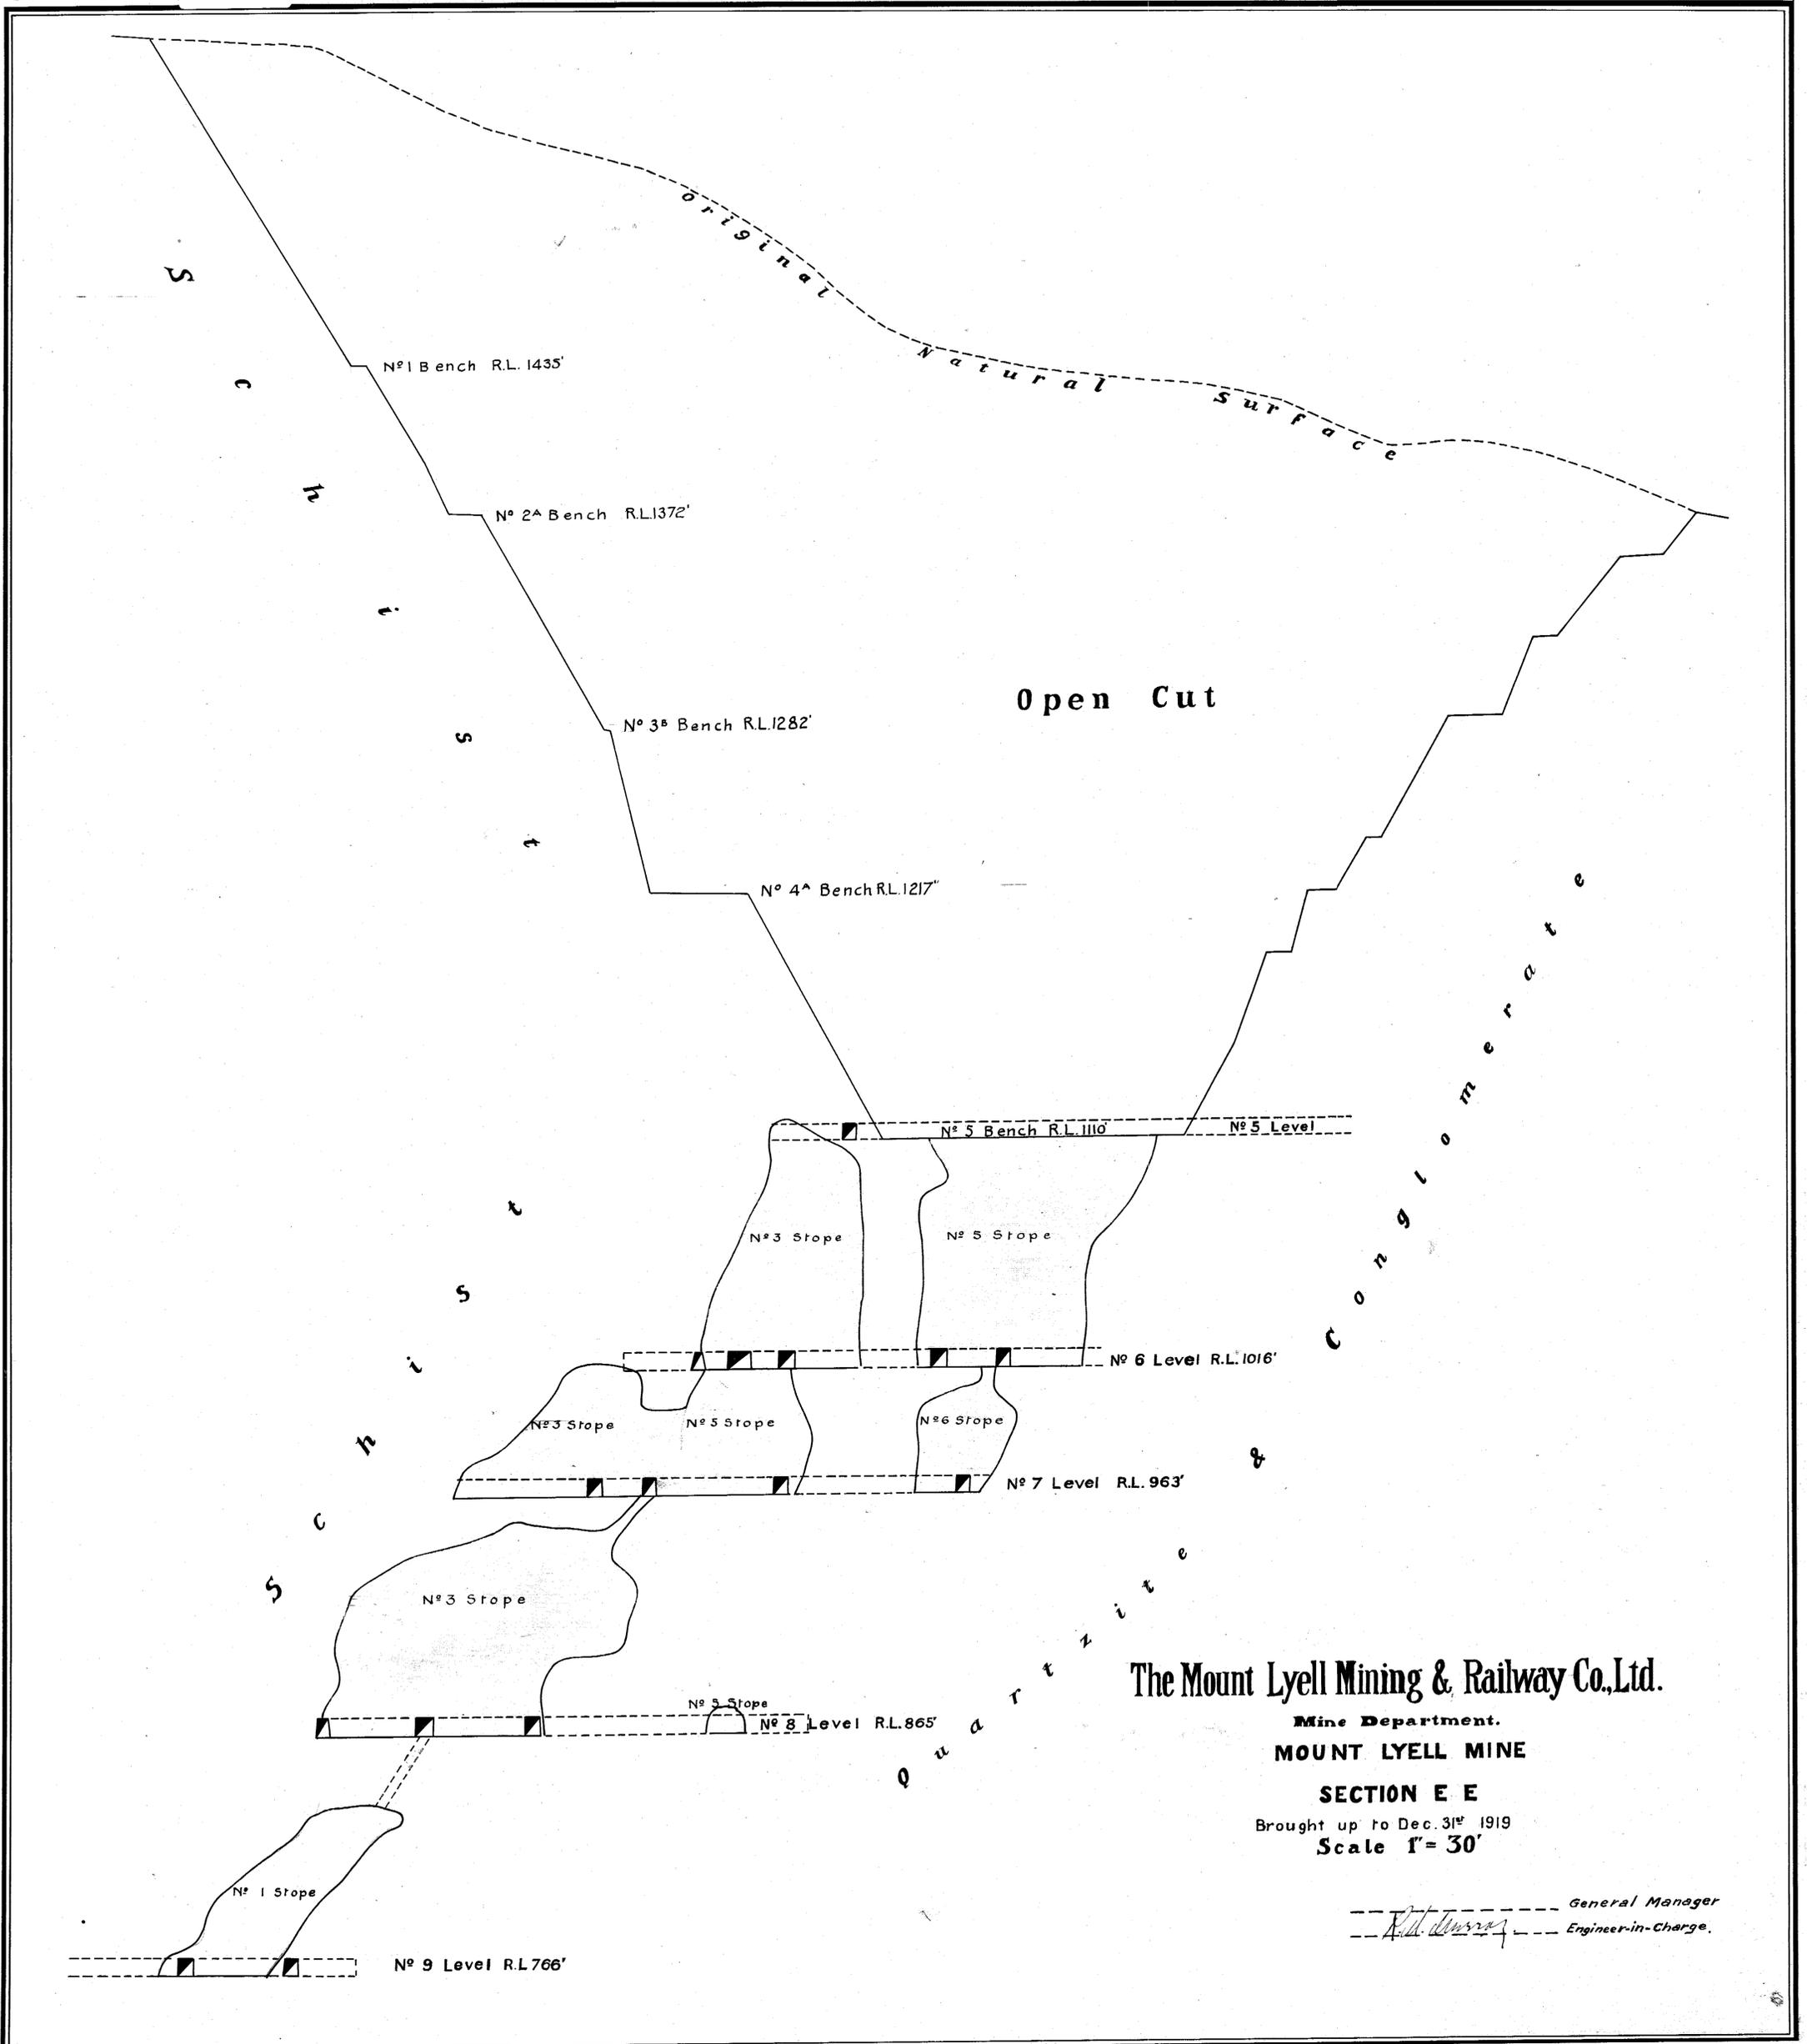

The Mount Lyell Mining & Railway Co., Ltd.

Mine Department.
MOUNT LYELL MINE

SECTION E E
Brought up to Dec. 31st 1919
Scale 1" = 30'

R. H. Murray General Manager
Engineer-in-Charge.